65 + 250' E.


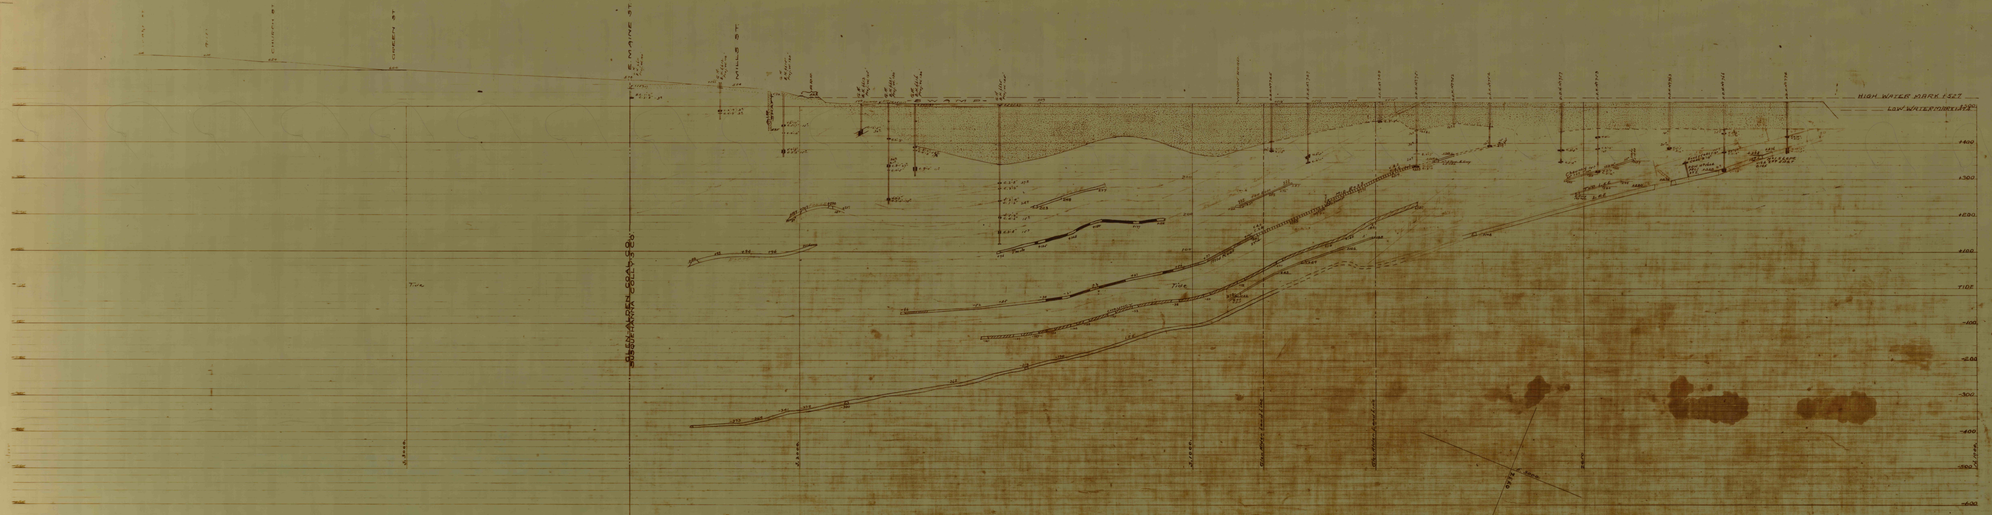
