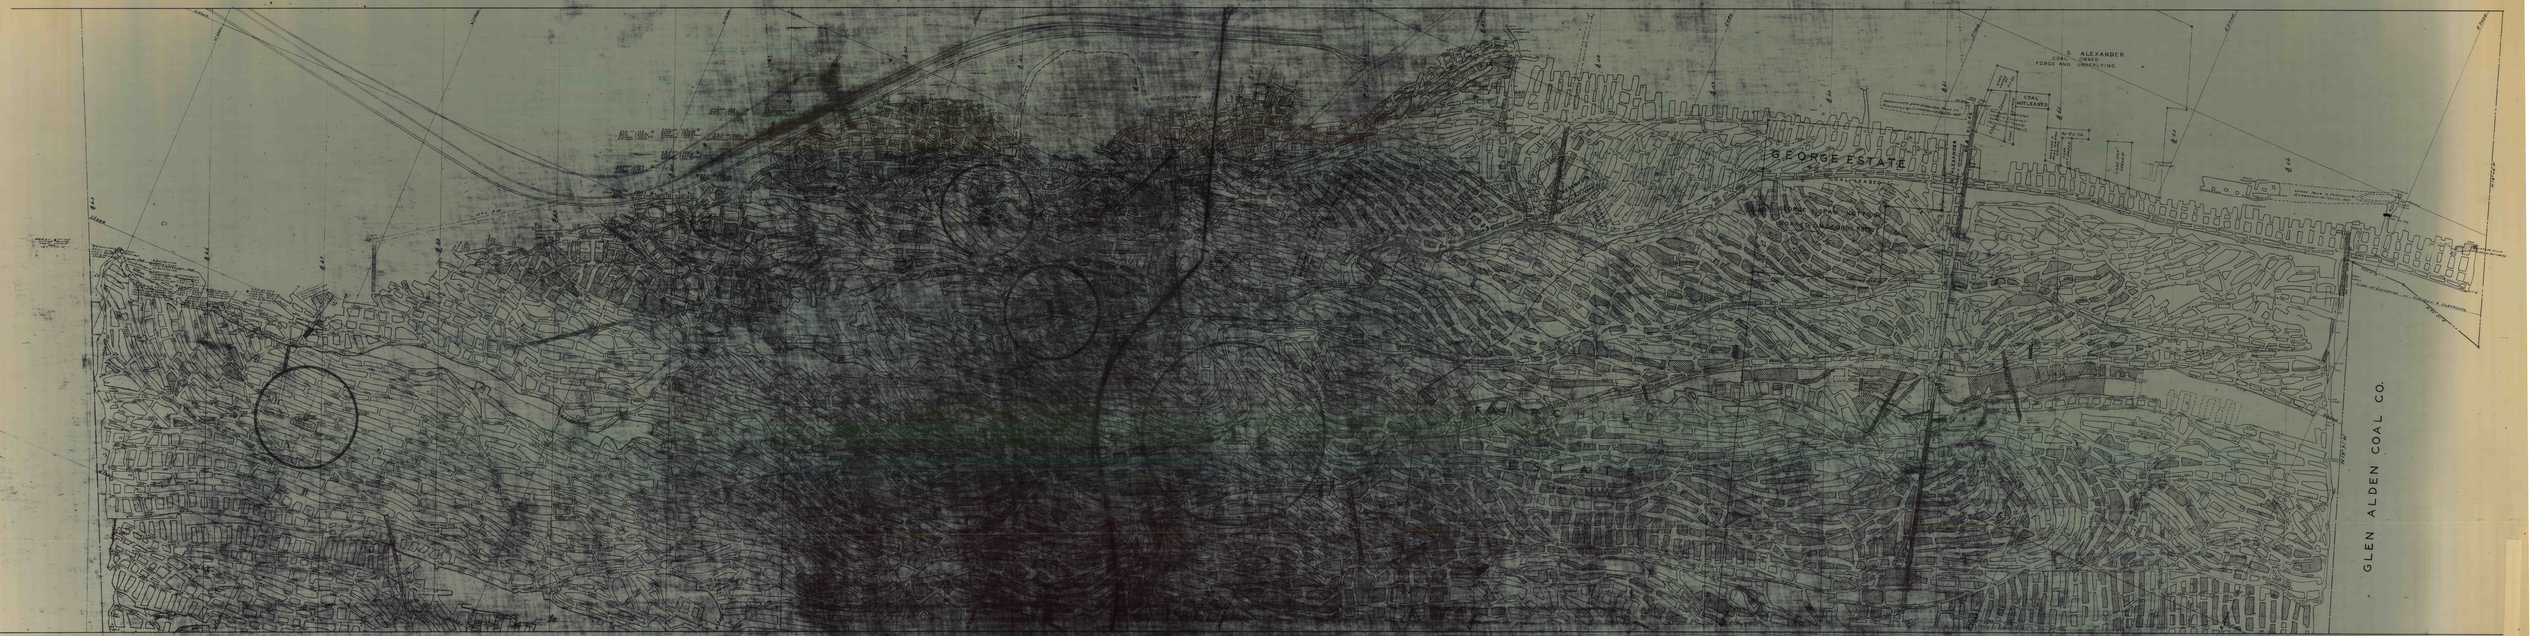
S. ALEXANDER
COAL OWNED
FORGE AND UNWELDING
COAL
UNLEASED
GEORGE ESTATE
GLEN ALDEN COAL CO.