


PART #1

PROJECT 37

Project # 37
36" Bore hole

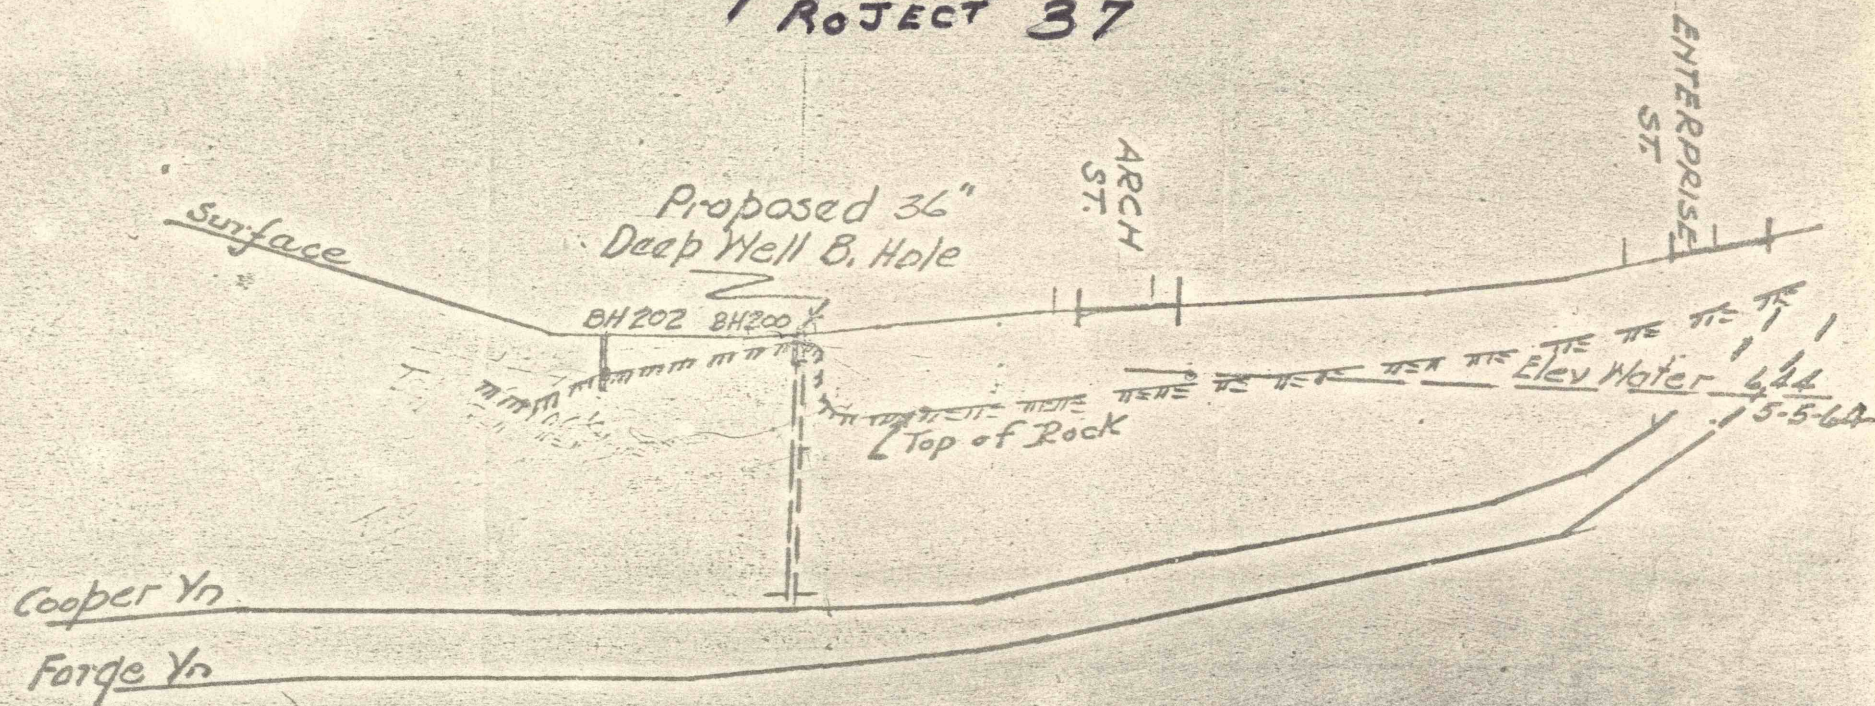

BH 200
 Platform 0'-6" surf. 652.19
 Ashes 0'-6" Top Rock 651.7
 Shelly Rock 12'-8"
 Rusty Sandstone 2'-4" Bot Hole 636.69
 16'-0"

BH 202
 Platform 0'-6" surf. 646.10
 Gravel with culm 7'-6"
 Sand + Fine Gravel 5'-0"
 Boulder 1'-0"
 Wood 0'-4"
 Boulder 1'-2" 15'0"
 Rock 10'-8" Bot Hole 620.43