


OLD FORCE WYBCX DBILL

VANBUREN

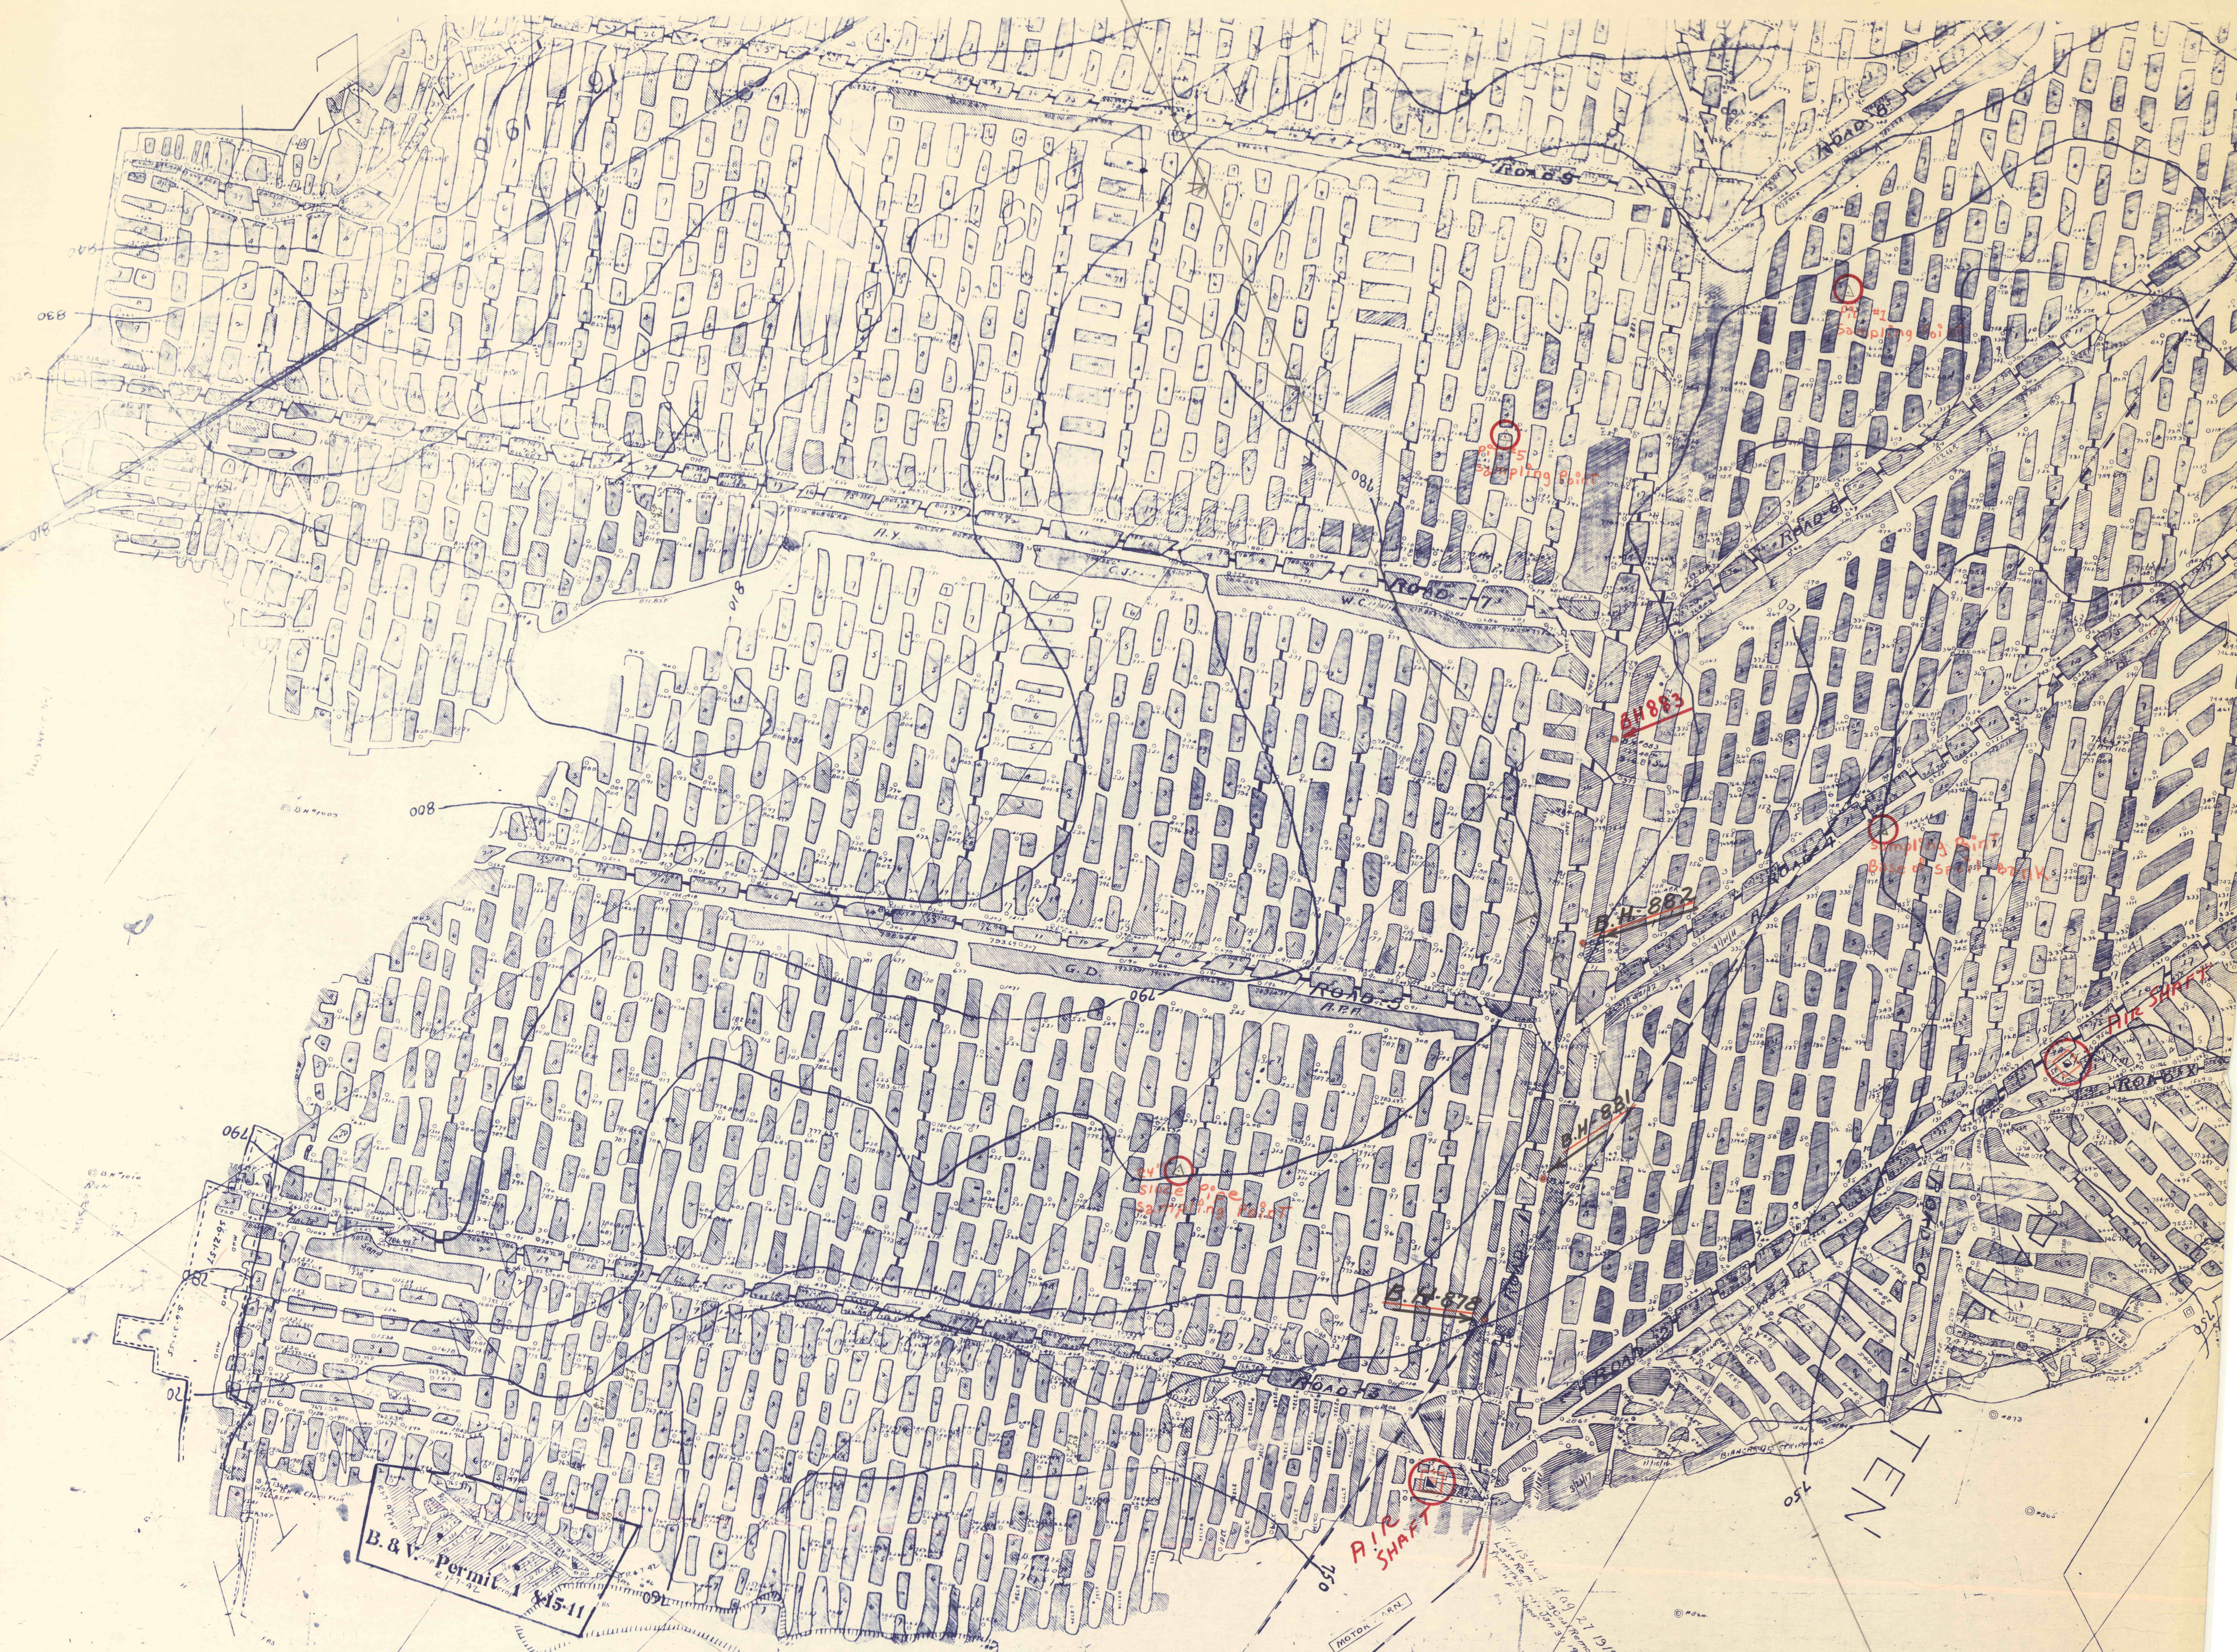

PARCEL NO 1
ALBERT J. MINICHIELLO
JENNIE MINICHIELLO
MAR. 1935
548 ACRES ±
LACKAWANNA MINING & CONSTRUCTION CO.
RELEASED OCT. 4, 1965
CANCELLED FEB. 10, 1966

Villa Corp
Sampling Point

AIR SHAFT

MARCY
VEIN