


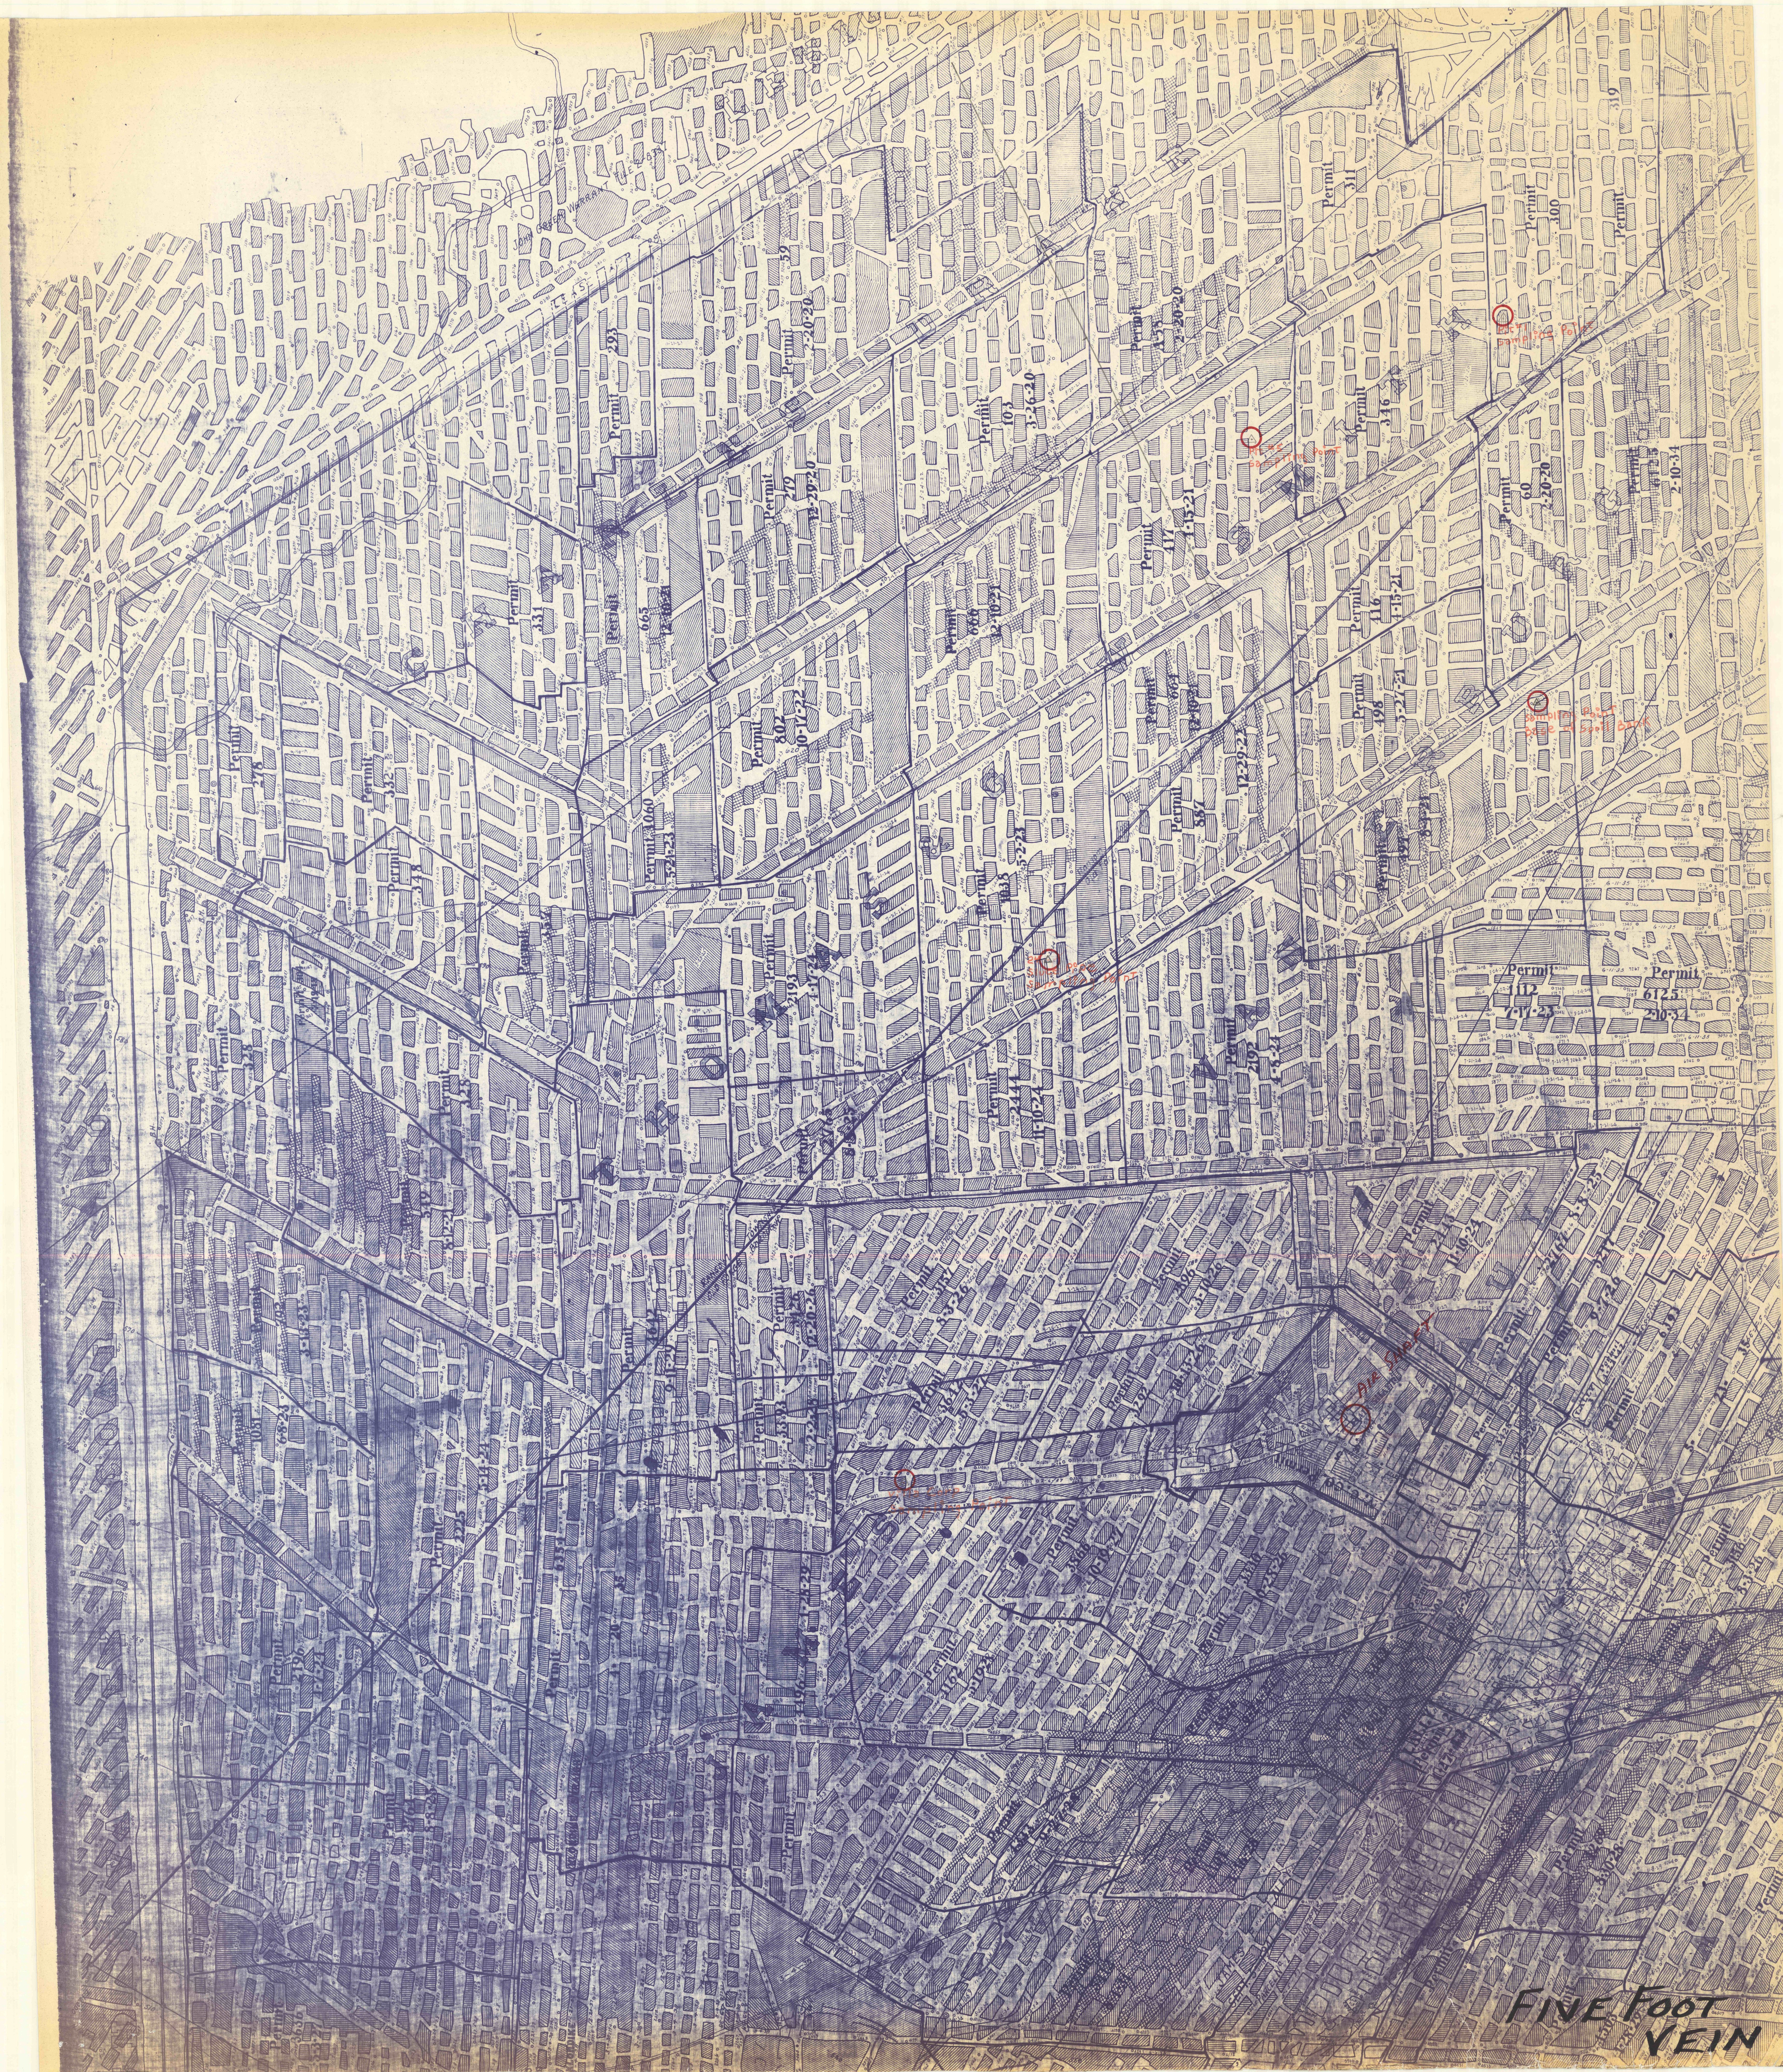

FIVE FOOT
VEIN