

N 23° 25' E 3983.70'

N 19,000

N 19,500

N 20,000

N 20,500

N 21,000


N 21,500

© L.M. & C. Co.
B.H. 128

© Penna. C. Co.
B.H. 129

L.M. & C. Co.
B.H. 129

B.H. 126

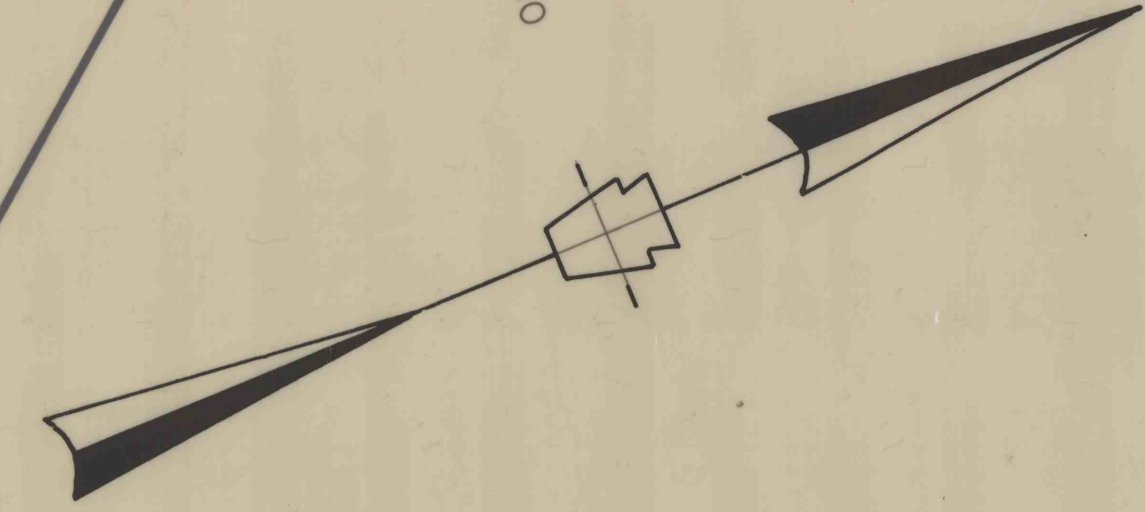

S 38° 17' E 769.20'

N 15° 07' E 1168.20'

RANSOM TOWNSHIP
OLD FORGE BOROUGH

- LEGEND**
- ⊗ Barrells Found
 - X No Barrells Found
 - △ D.E.R. Leachate Sampling Sites
 - Approximate High Wall Boundary of Pit # 5
 - Vent Pipe
- EXCAVATIONS**
- 1 Shallow Pit
 - 2 Deep Pit
 - 3a East Pit
 - 3b East Pit Extension
 - 4a Two Pits in
 - 4b Center Trench
 - 5a South Pits
 - 5b South Pits

SURFACE MAP
 NORTHEASTERN LAND DEVELOPMENT CO. INC.
 PETER IACOVAZZI
 OLD FORGE BOROUGH
 LACKAWANNA COUNTY
 PENNSYLVANIA

**SANITARY
 LANDFILL PITS**

1"=100'



Bottom Edge Existing Pit

Sampling Point
Base of Spoil Bank
Below Pit # 5

24" Sluce Pipe
Sampling Point

Pit # 1
Sampling Point Pit

Sampling Point

PIT # 2

PIT # 3

East West
Base Line

pole line

Intermittent Stream

ditch

dirt road