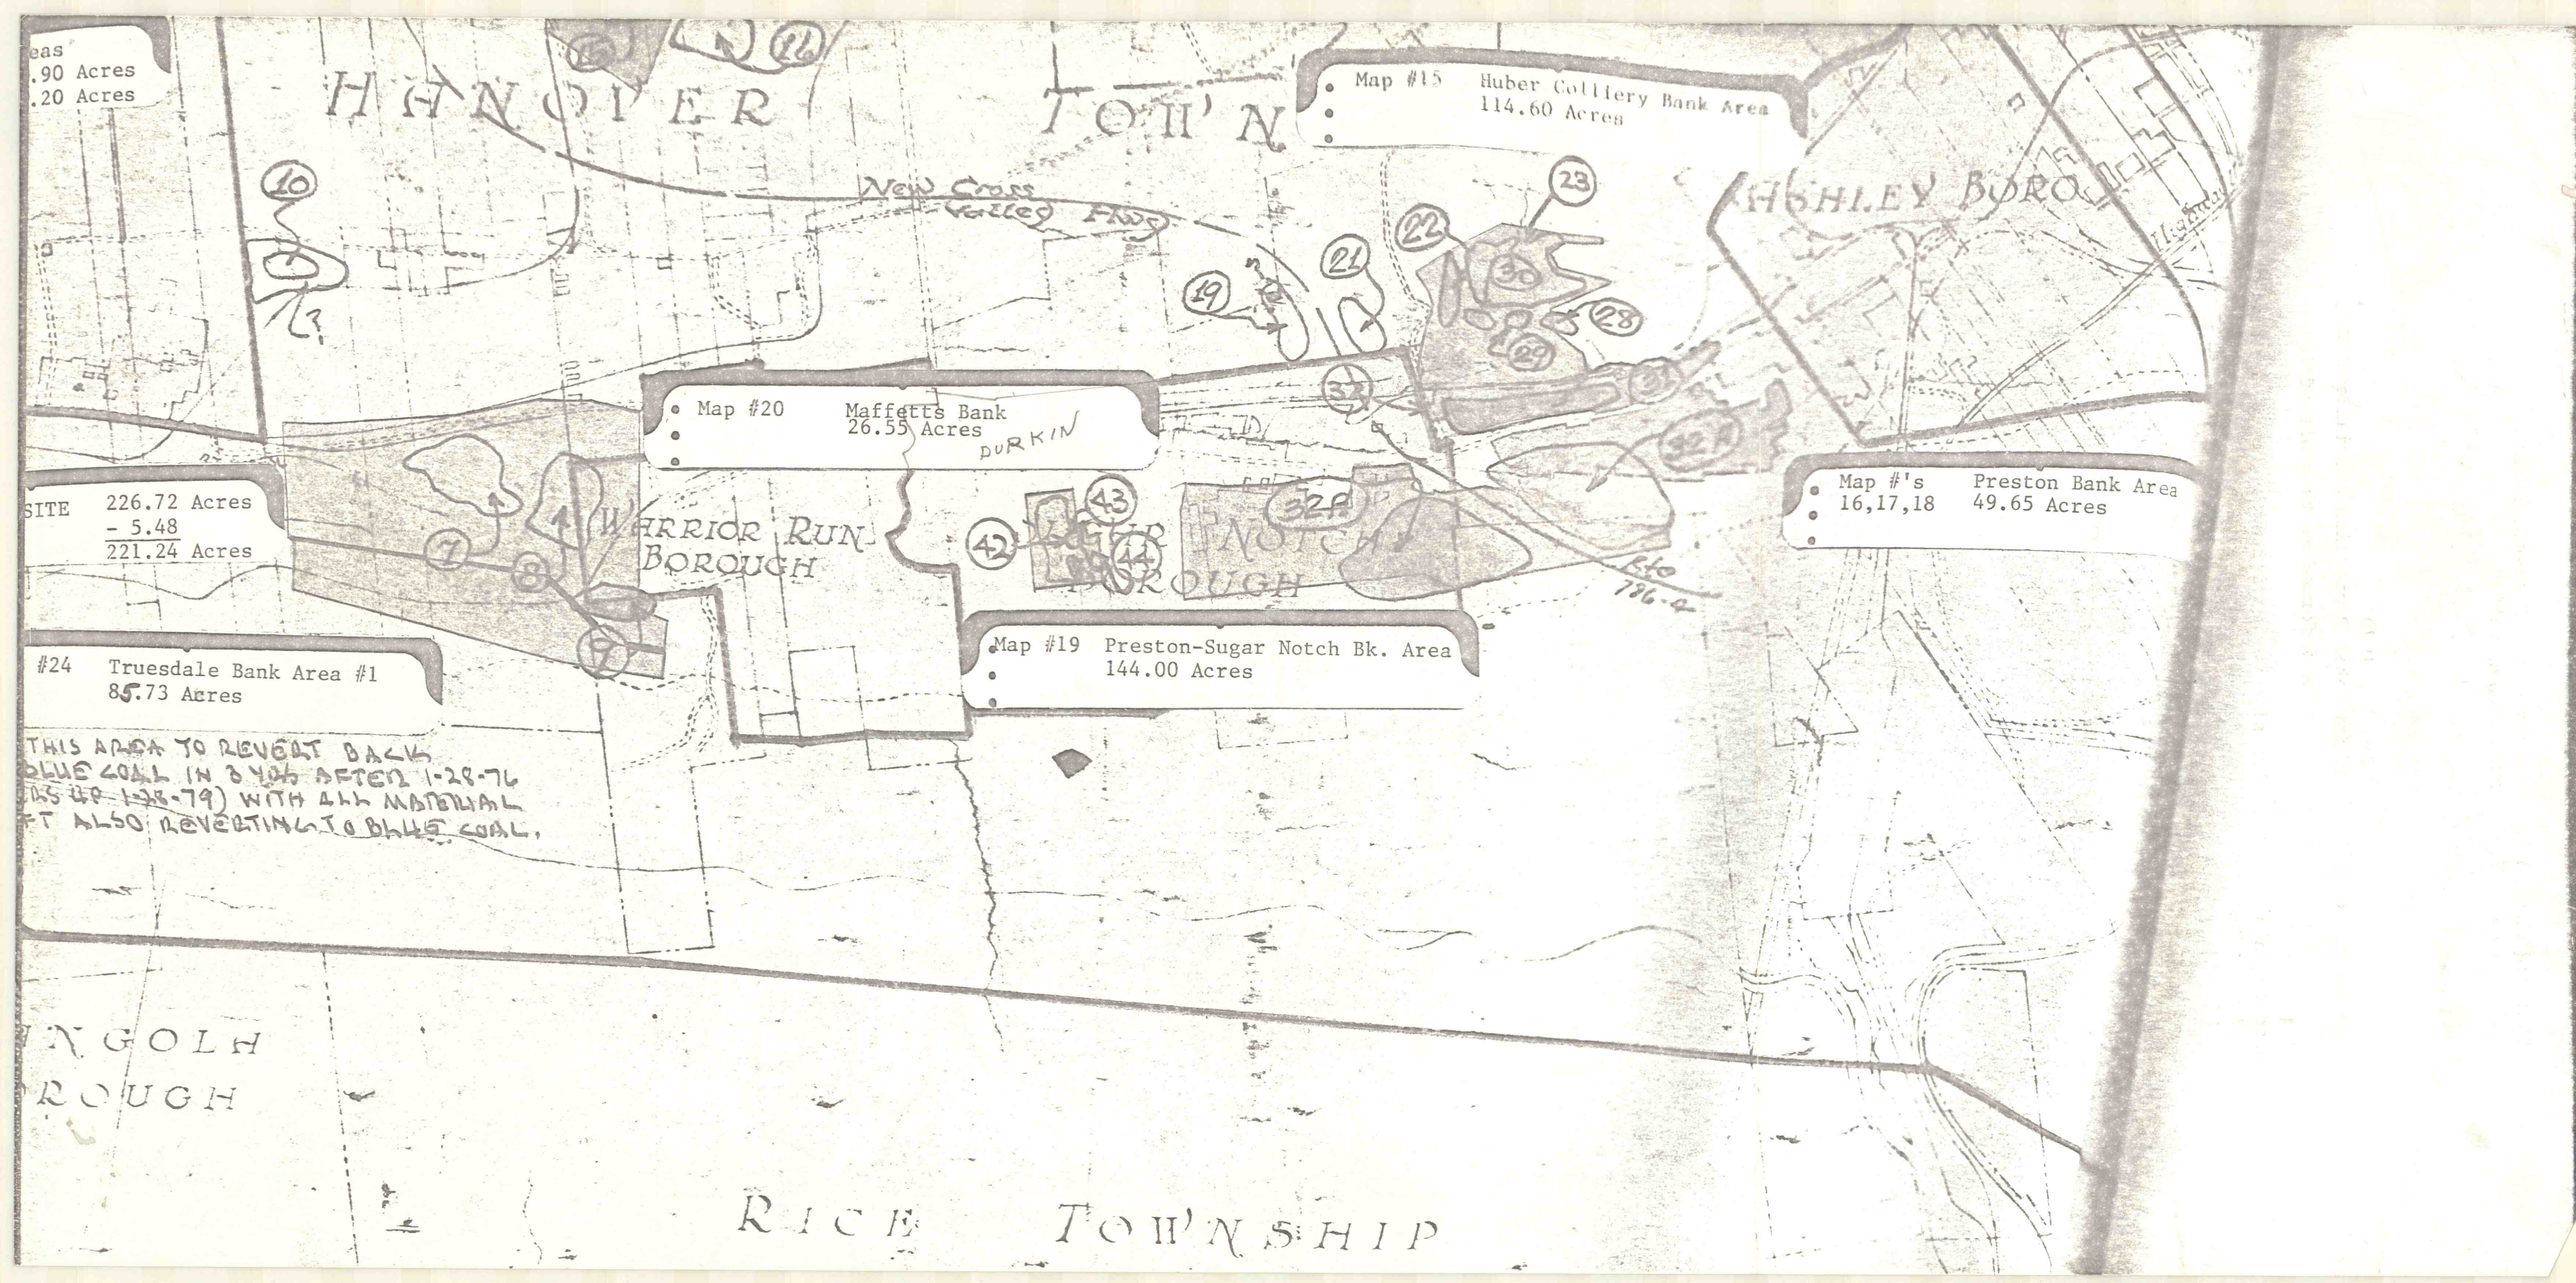
eas
.90 Acres
.20 Acres
HANOVER TOWN
New Cross Valley Hwy
Map #15 Huber Colliery Bank Area
114.60 Acres
Map #20 Maffetts Bank
26.55 Acres
DURKIN
SITE 226.72 Acres
- 5.48
221.24 Acres
WARRIOR RUN BOROUGH
SUGAR NOTCH BOROUGH
Map #'s 16,17,18 Preston Bank Area
49.65 Acres
Map #19 Preston-Sugar Notch Bk. Area
144.00 Acres
#24 Truesdale Bank Area #1
85.73 Acres
THIS AREA TO REVERT BACK
BLUE COAL IN 3 YRS AFTER 1-28-76
(RS 4P 1-28-79) WITH ALL MATERIAL
FT ALSO REVERTING TO BLUE COAL.
NGOLH
ROUGH
RICE TOWNSHIP