



ELE 195529

BORE HOLE NO. 1

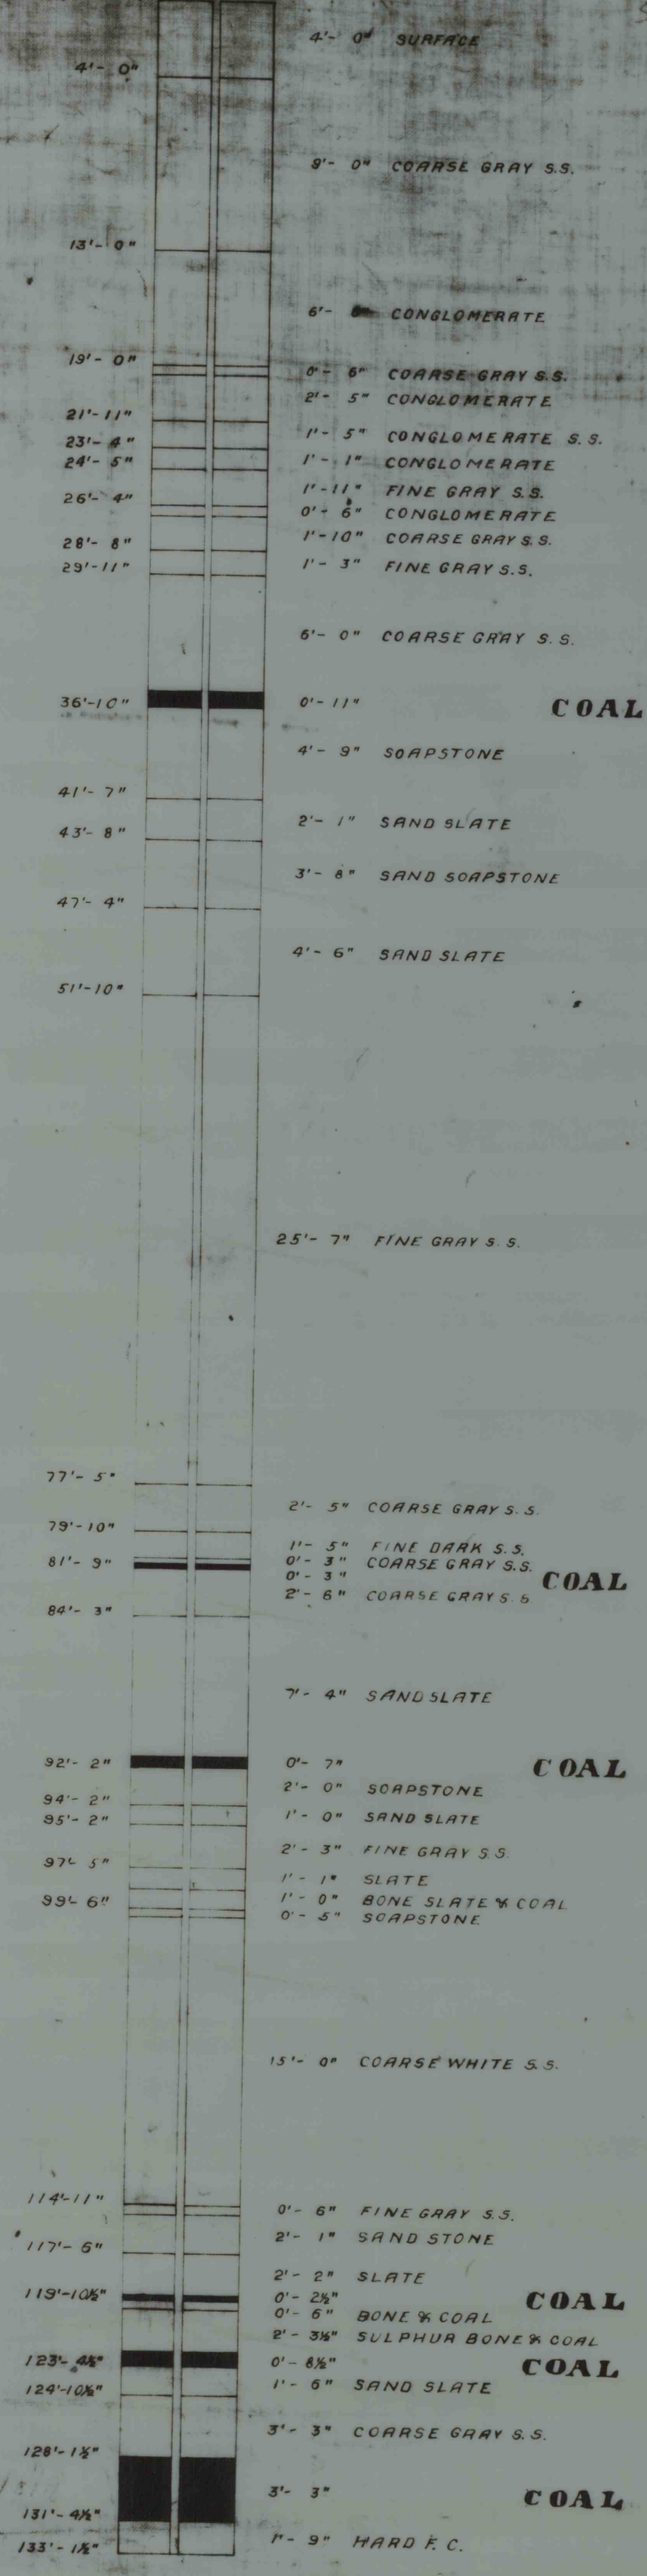


SCALE 1/8" = 1'

BORE HOLE NO. 2

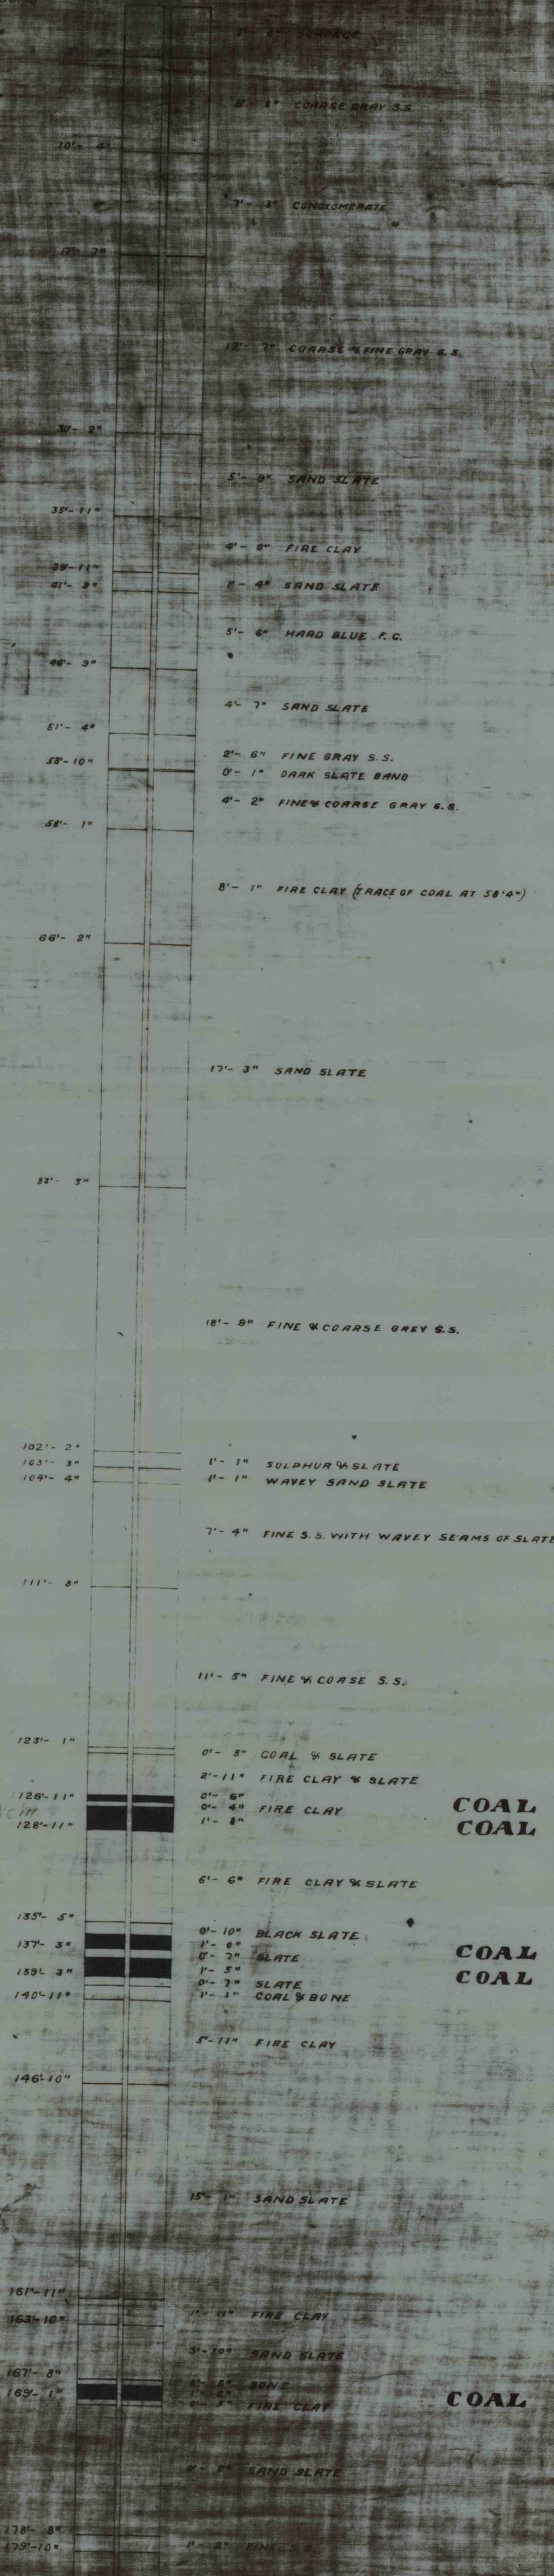

BORE HOLE NO. 3

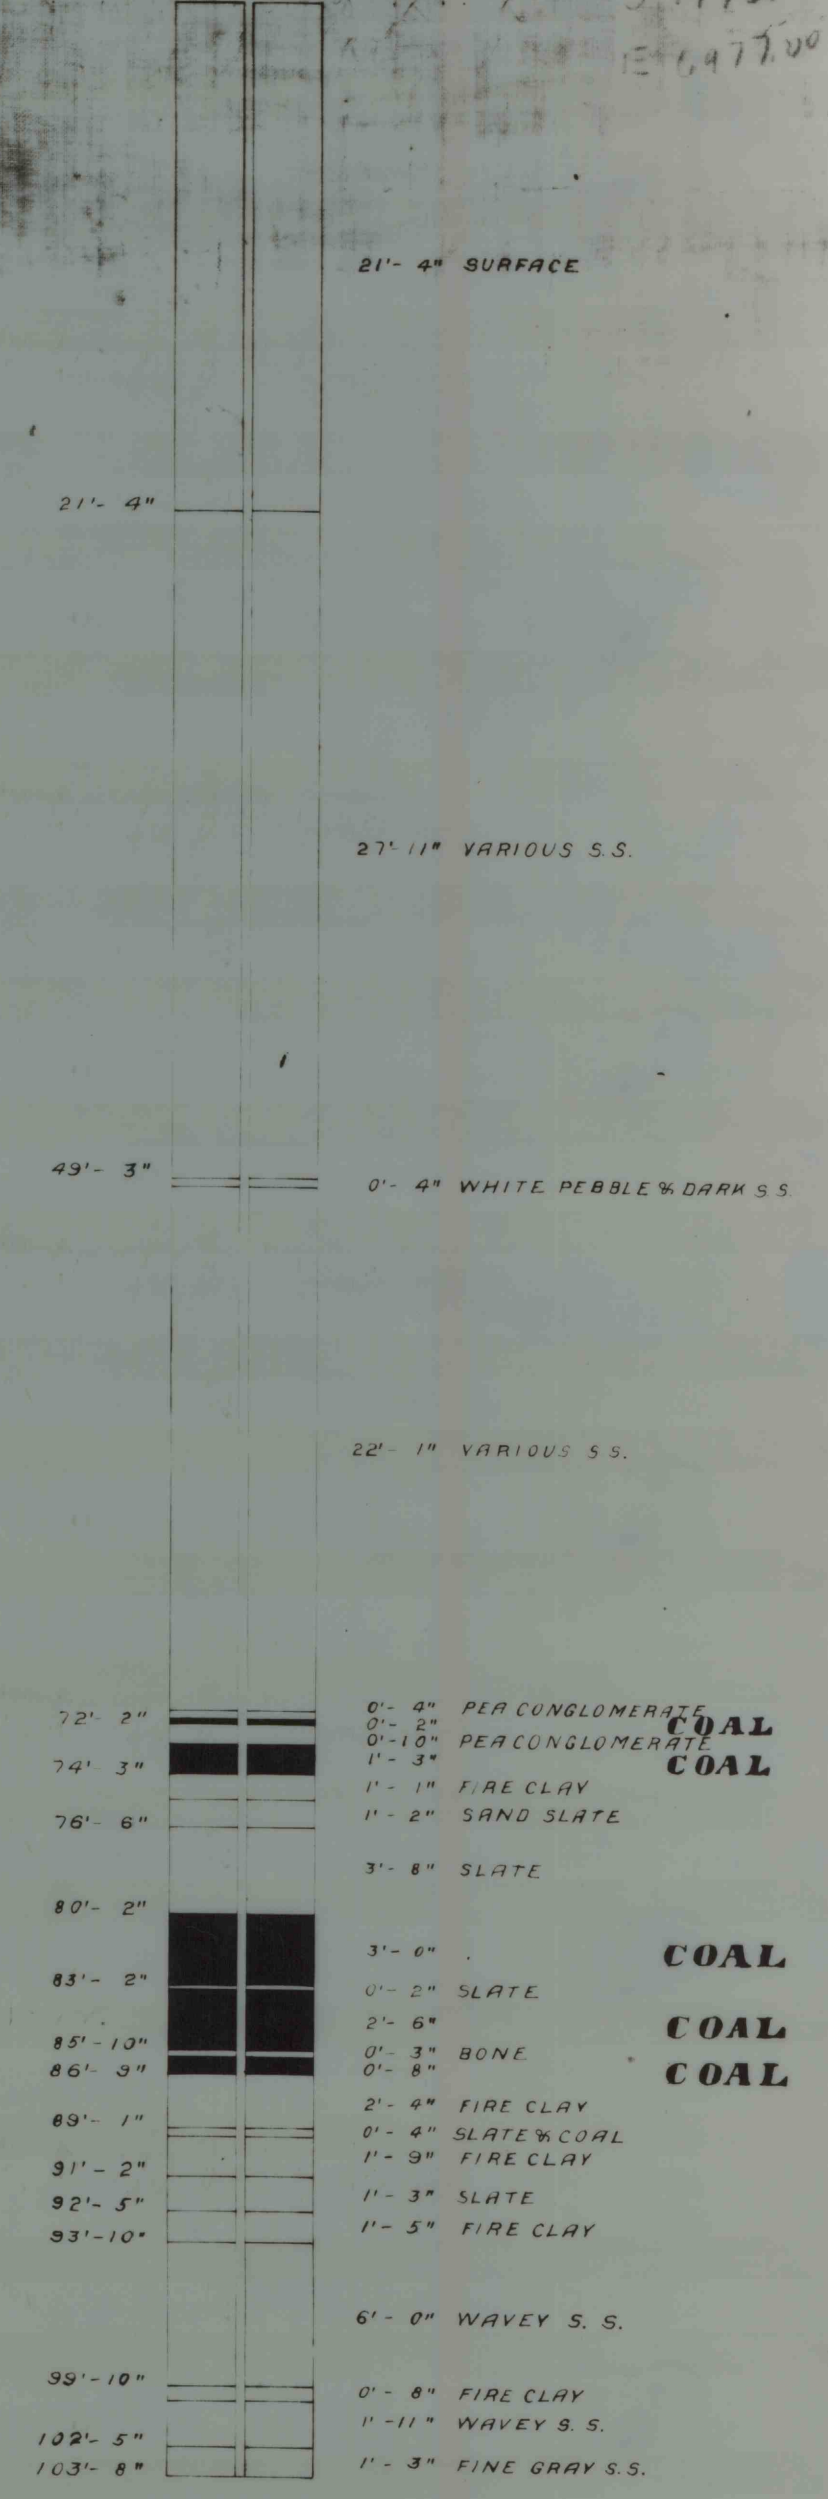

SCALE 1/8" = 1'

5,773.00
E 1,477.00