


52818.00  
 5336.00  
 measuring from  
 top of


BORE HOLE NO. 9  
 SPRAGUE & HENWOOD STARTED 4/13/01. COMPLETED 4/15/01.  
 WILLIAM SCHMIDT RUNNER.

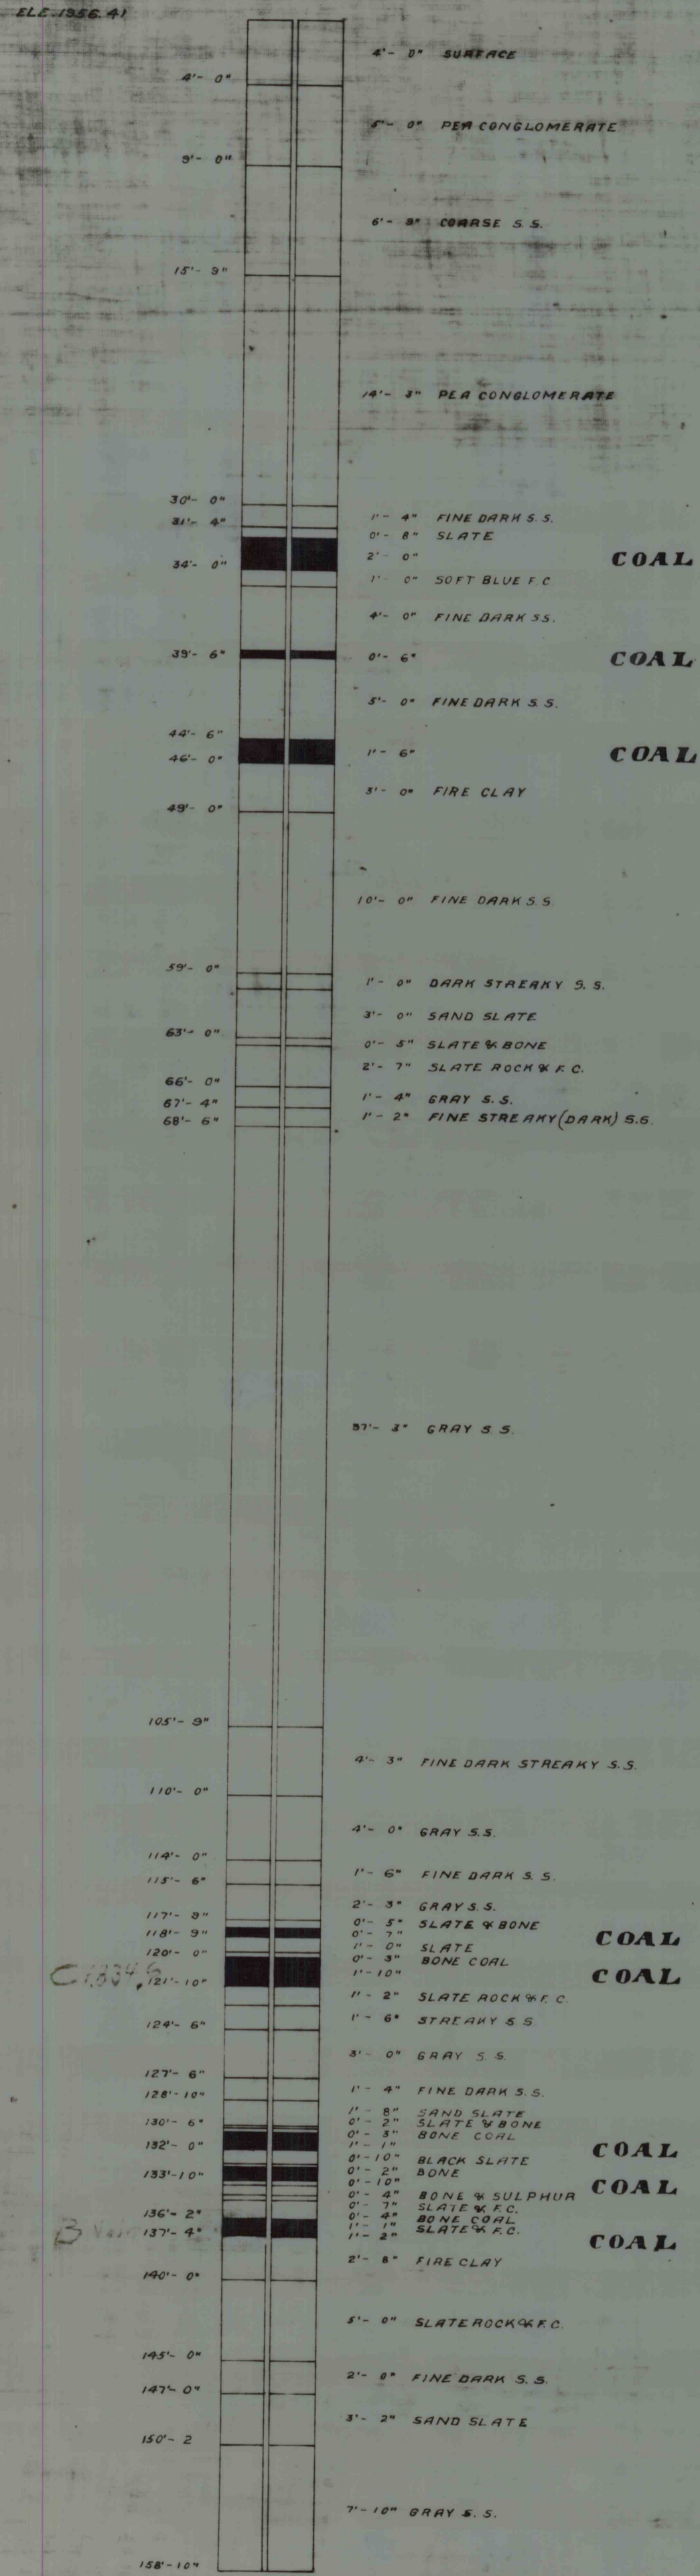

SCALE 1/4" = 1'

W 651 measuring from  
 S-3016  
 40' 3" 1903.70  
 1903.70


BORE HOLE NO. 10  
 SPRAGUE & HENWOOD STARTED 4/15/01. COMPLETED 4/19/01.  
 WILLIAM SCHMIDT RUNNER.

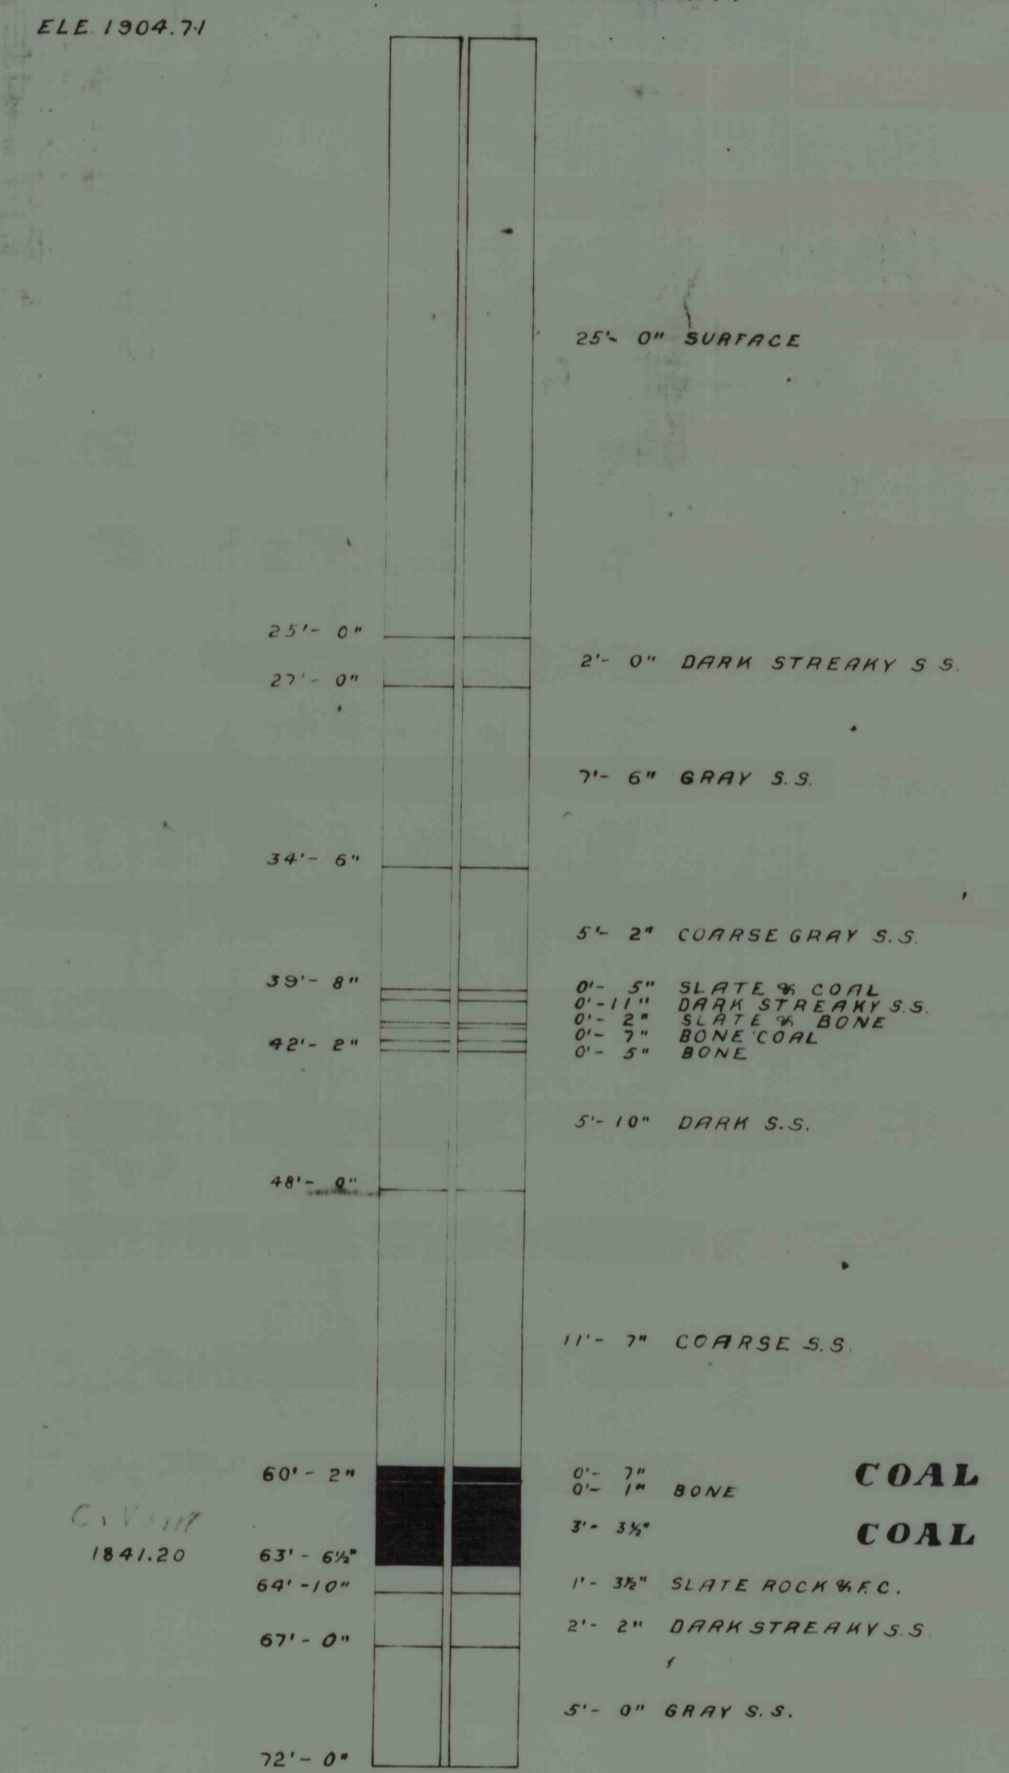

SCALE 1/4" = 1'

W 547 measuring from  
 S 3209  
 1906.10


BORE HOLE NO. 11  
 SPRAGUE & HENWOOD STARTED 4/13/01. COMPLETED 4/20/01.  
 WILLIAM SCHMIDT RUNNER.

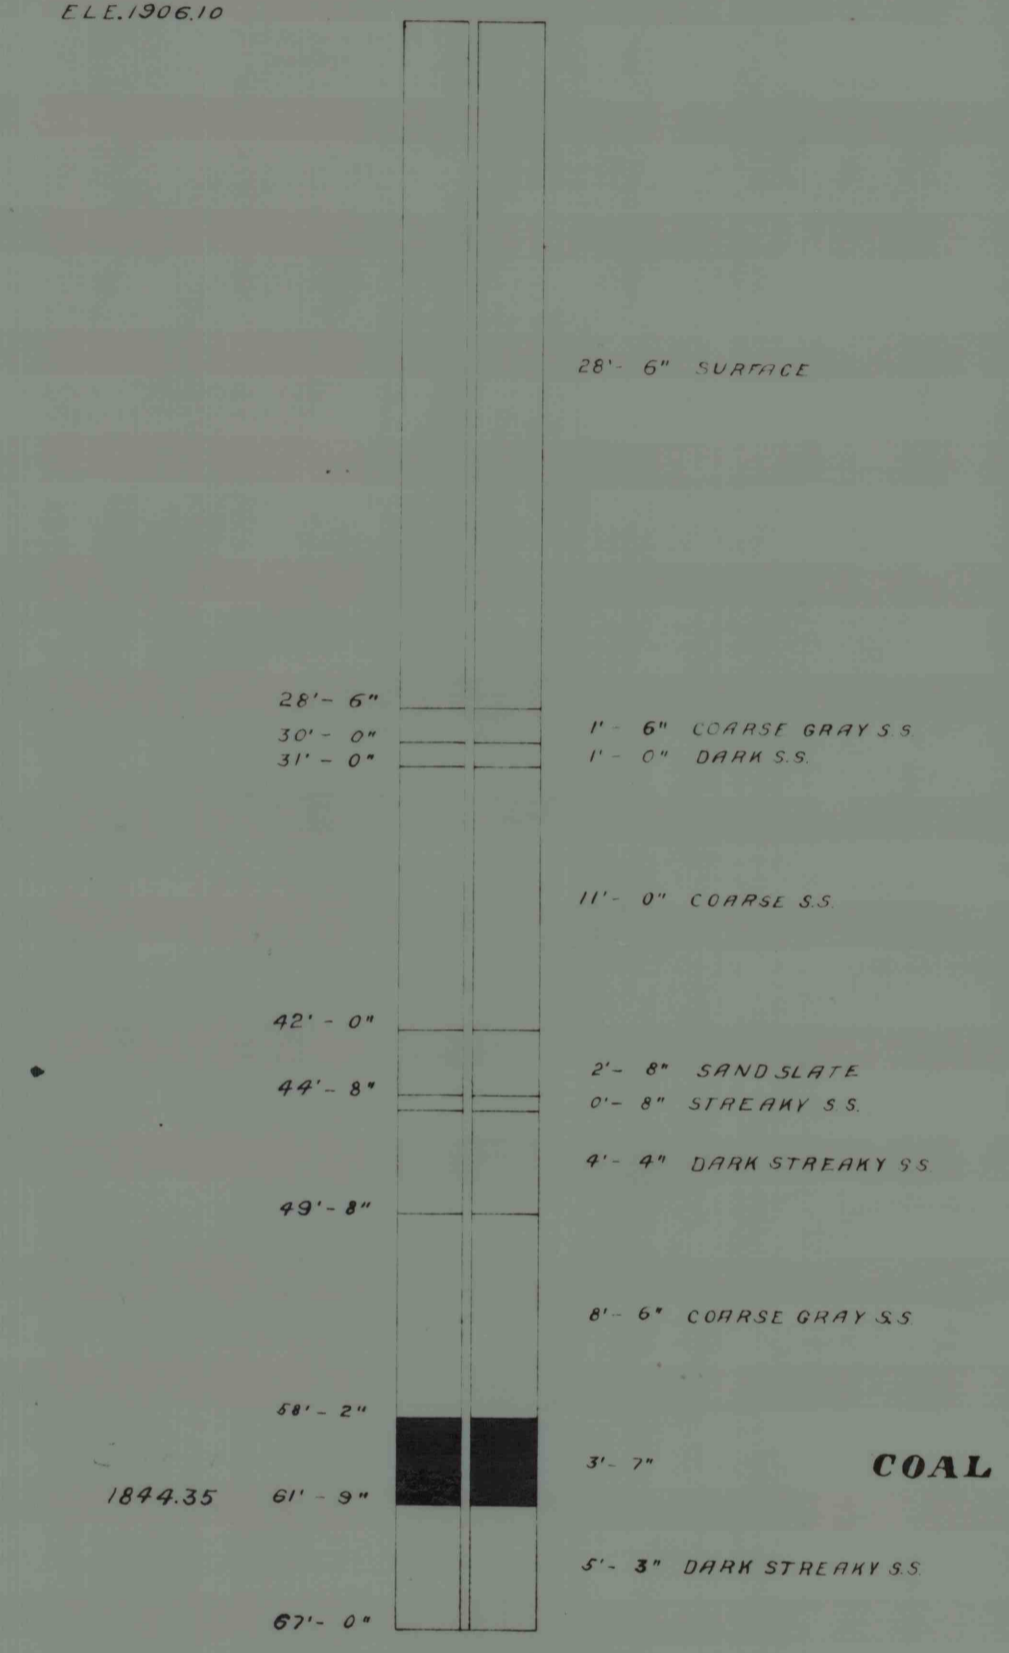

SCALE 1/4" = 1'

W 504 measuring from  
 S 3517  
 1903.96  
 1903.42

BORE HOLE NO. 12  
 SPRAGUE & HENWOOD STARTED 4/24/01. COMPLETED 4/27/01.  
 WILLIAM SCHMIDT RUNNER.  
 70E. OF LV. TRACKS JUST BEFORE P.C. AT SQUEEDUNK  
 CORRECT ELEVATION

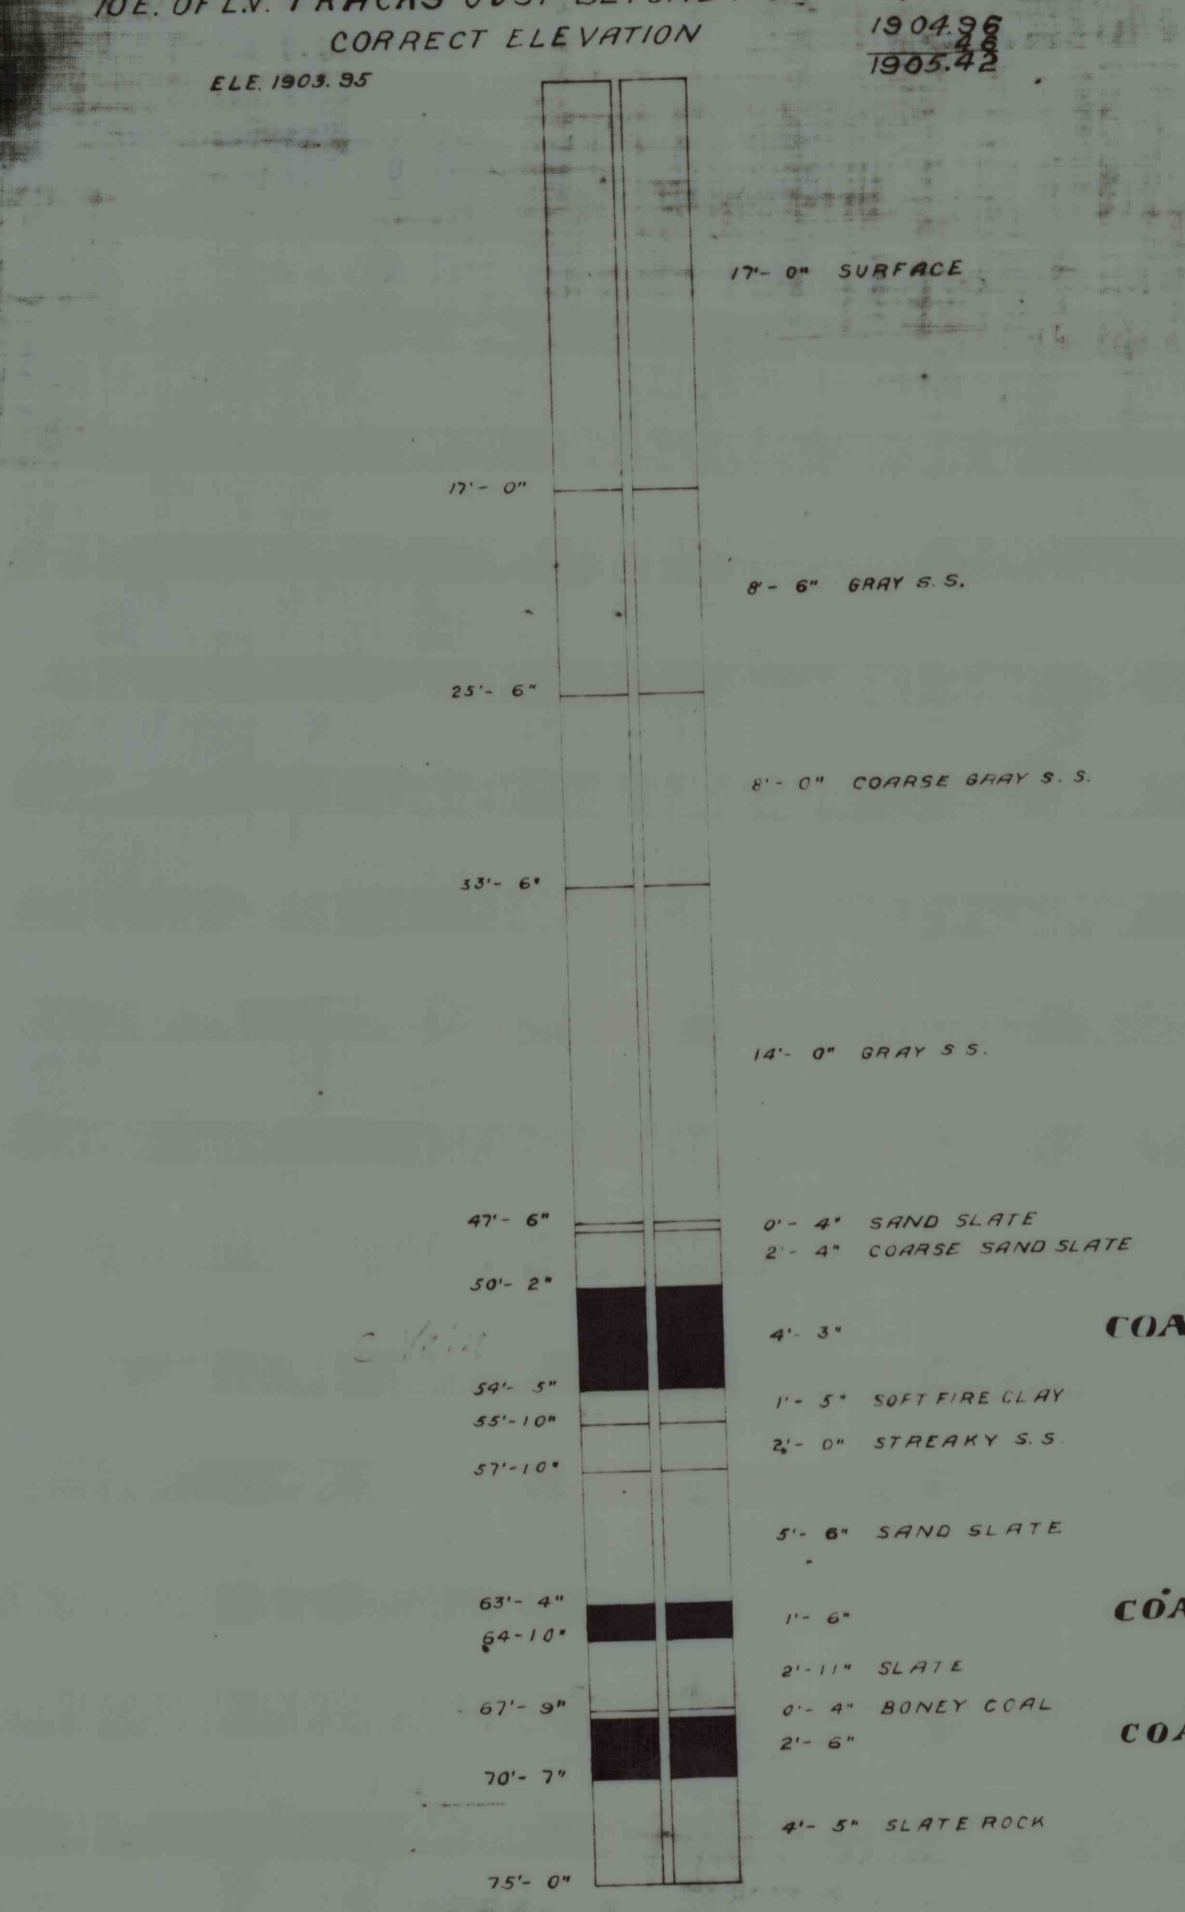

SCALE 1/4" = 1'