


BORE HOLE NO. 22  
 SPRAGUE & HENWOOD STARTED 1/13/01. COMPLETED 1/13/01.  
 WILLIAM SCHMIDT RUNNER.  
 E.L. 1938.76

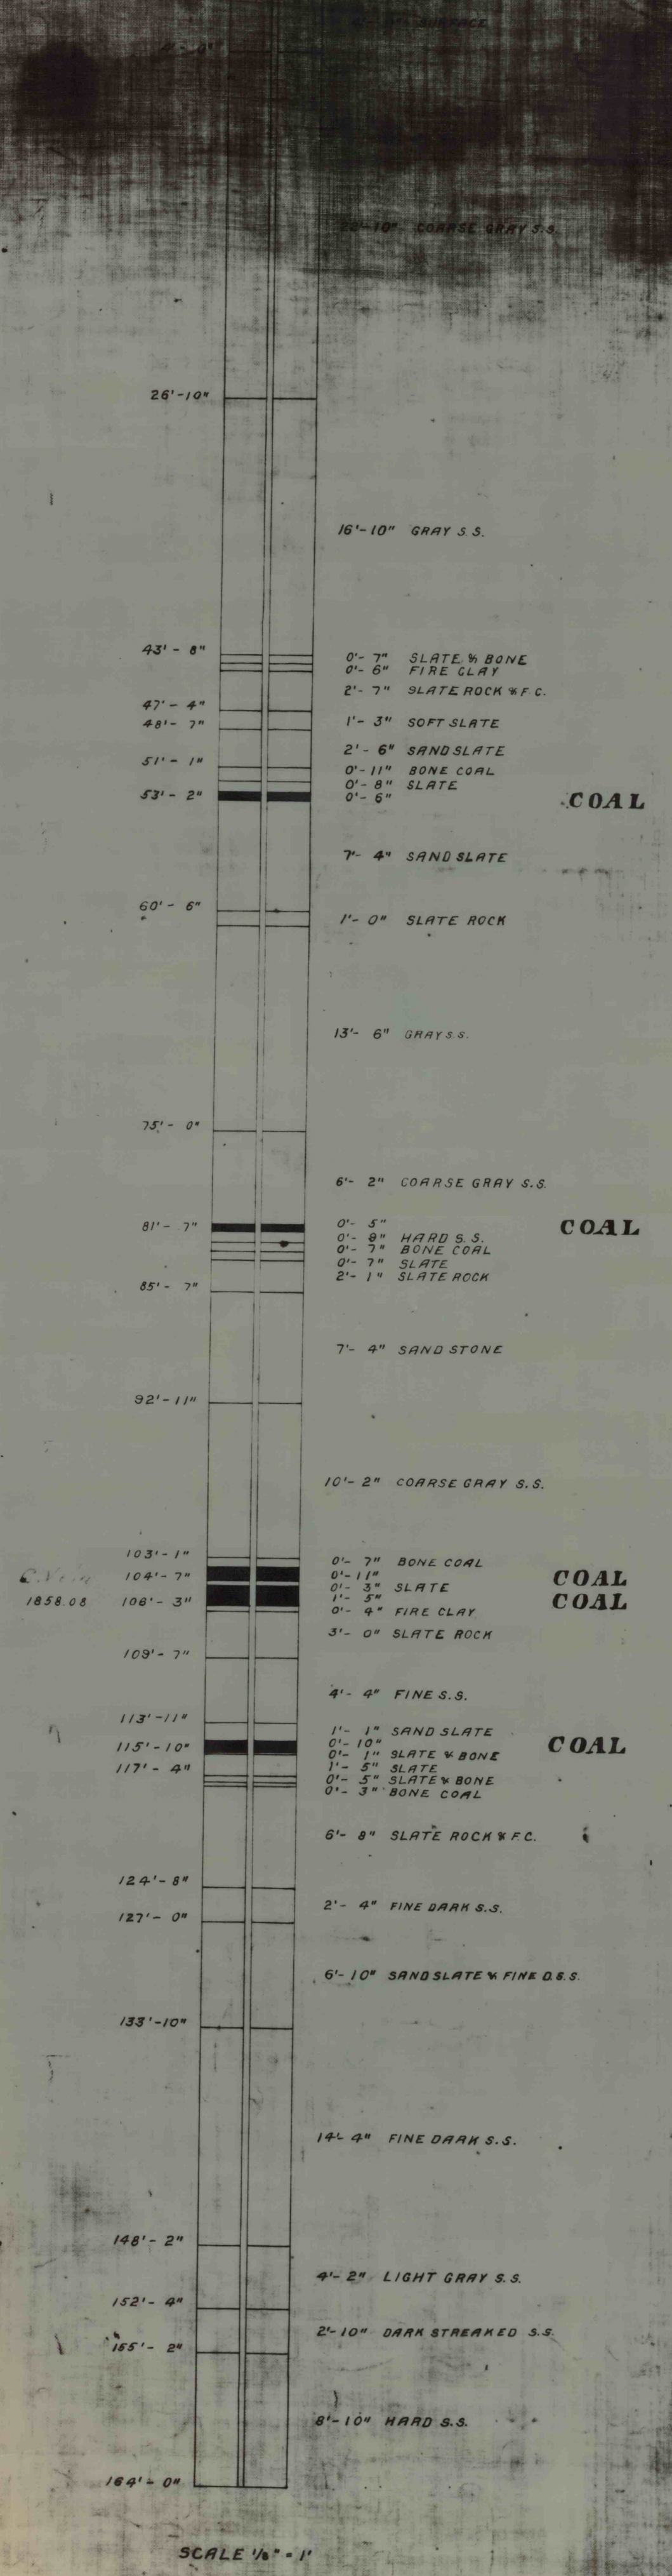

BORE HOLE NO. 22  
 SPRAGUE & HENWOOD STARTED 1/13/01. COMPLETED 1/22/01.  
 WILLIAM SCHMIDT RUNNER.  
 E.L. 1938.76

