



26 West of Squiduck
S 3800.2
W 1774.6
E.L. 1920.0

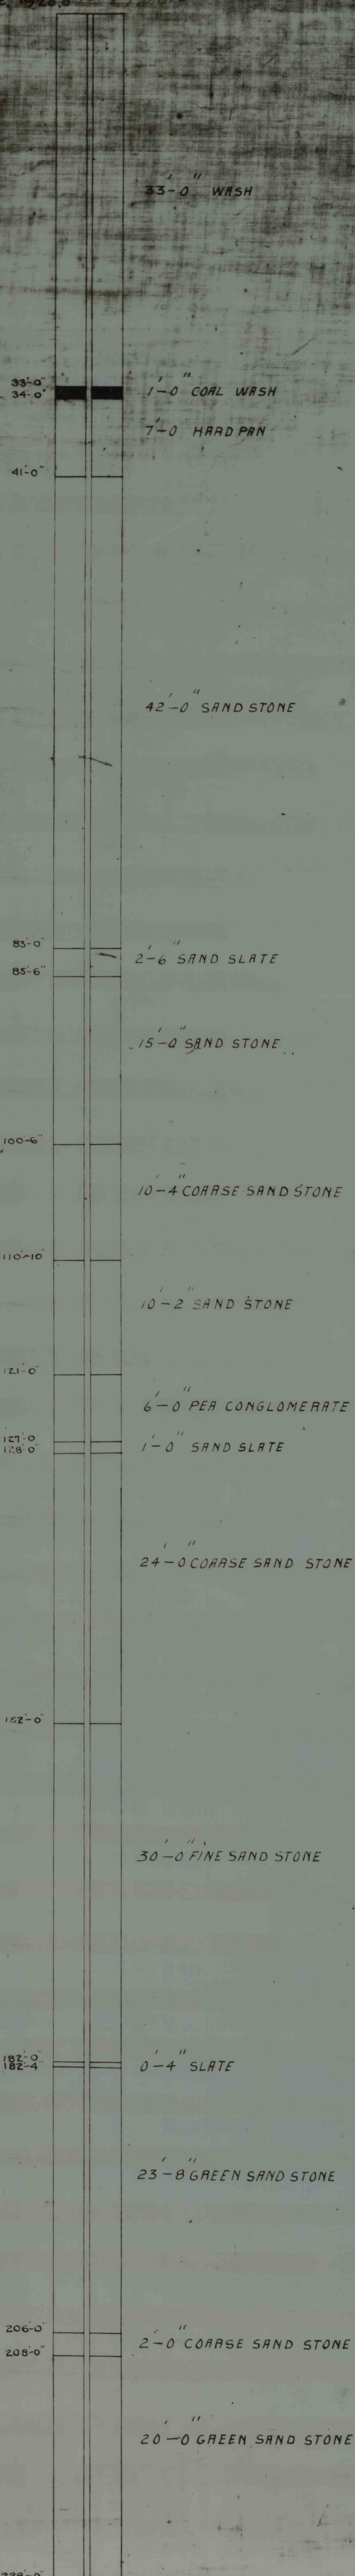


Feb. 17th - March 11th - 1911
George Jackson.

S 2742.27
W 980.16
E.L. 1885.88
289

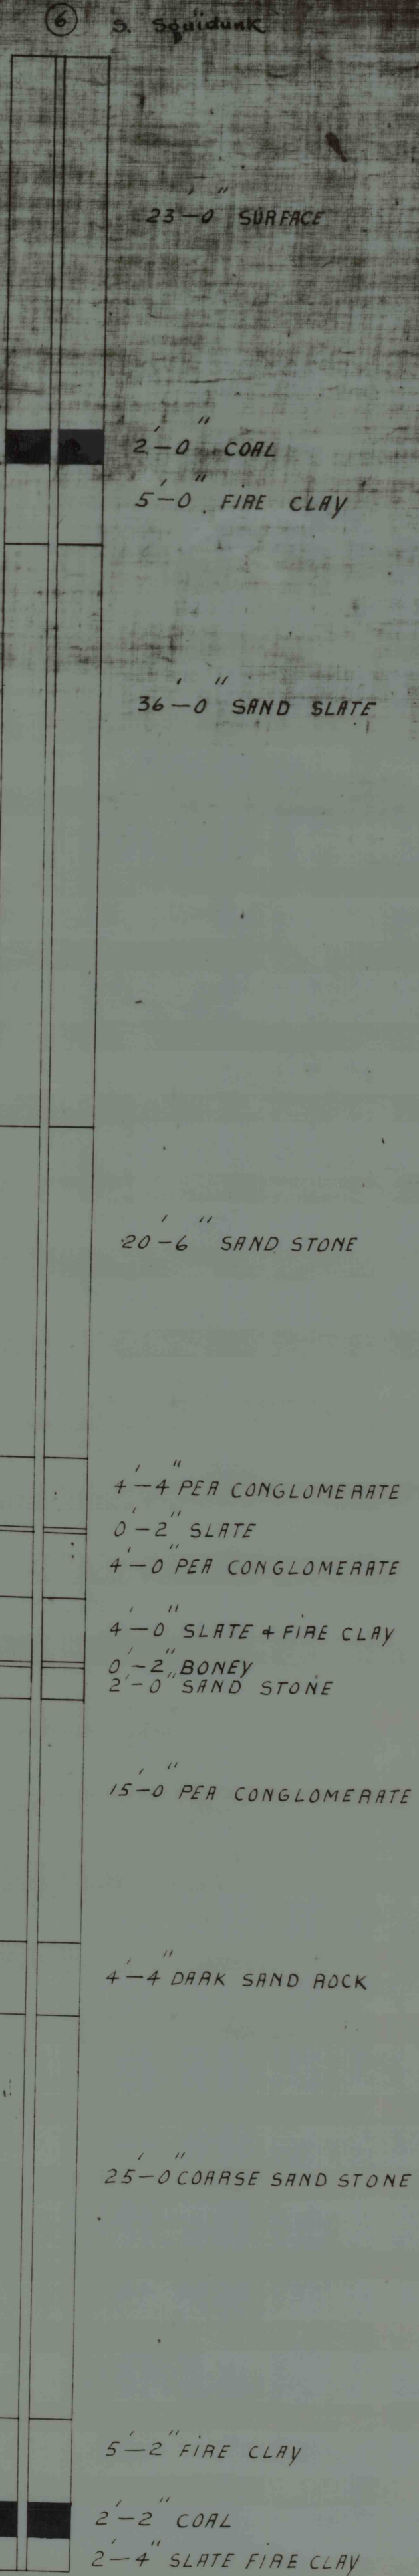


April 22nd - May 3rd - 1911
George Jackson.

43
S 4468.0
E 9948.2
E.L. 1885.3

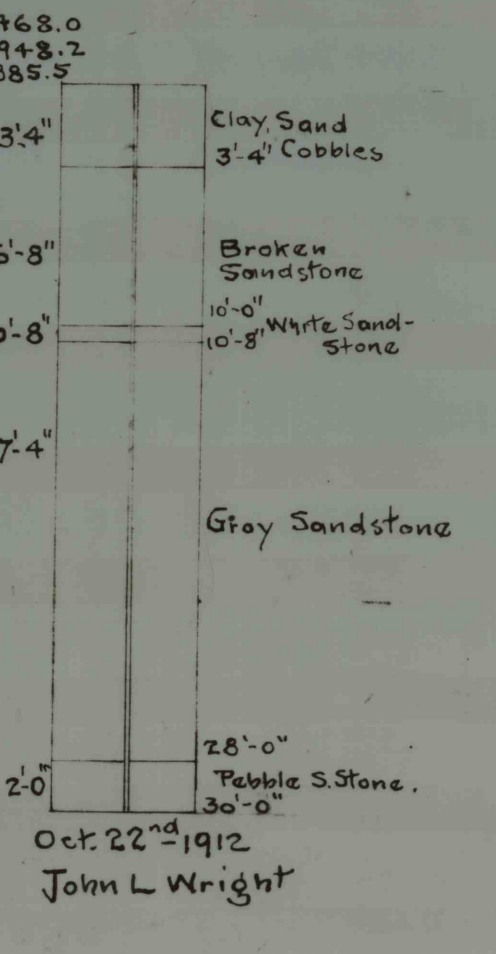

Oct. 22nd 1912
John L. Wright

44
S 4460.2
E 8454.0
E.L. 1863.7

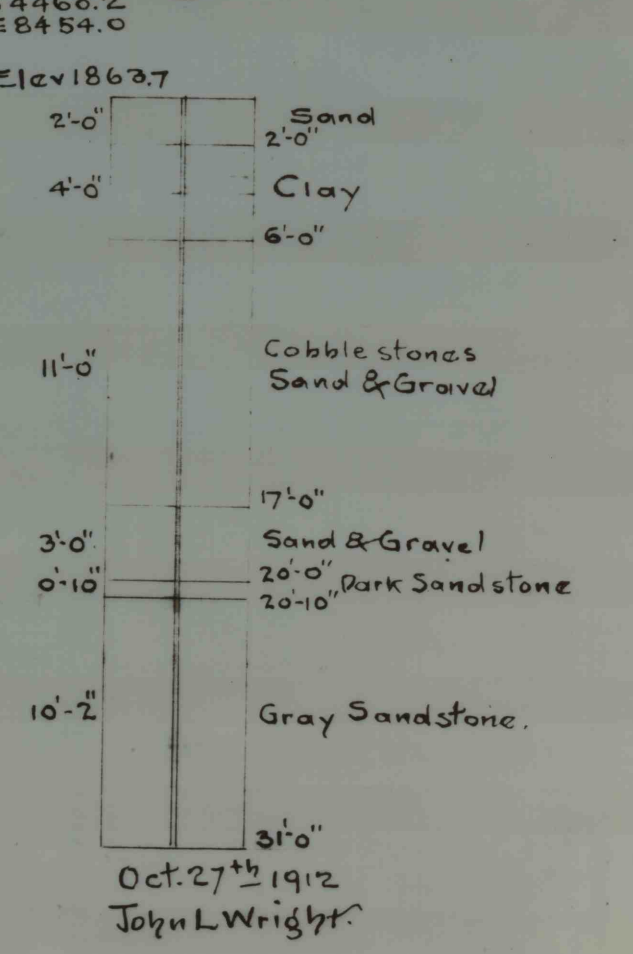

Oct. 27th 1912
John L. Wright