



68

(2)

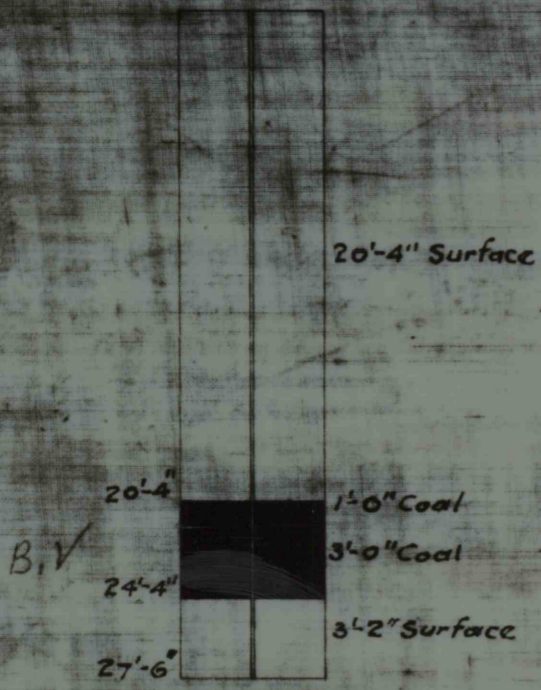


87

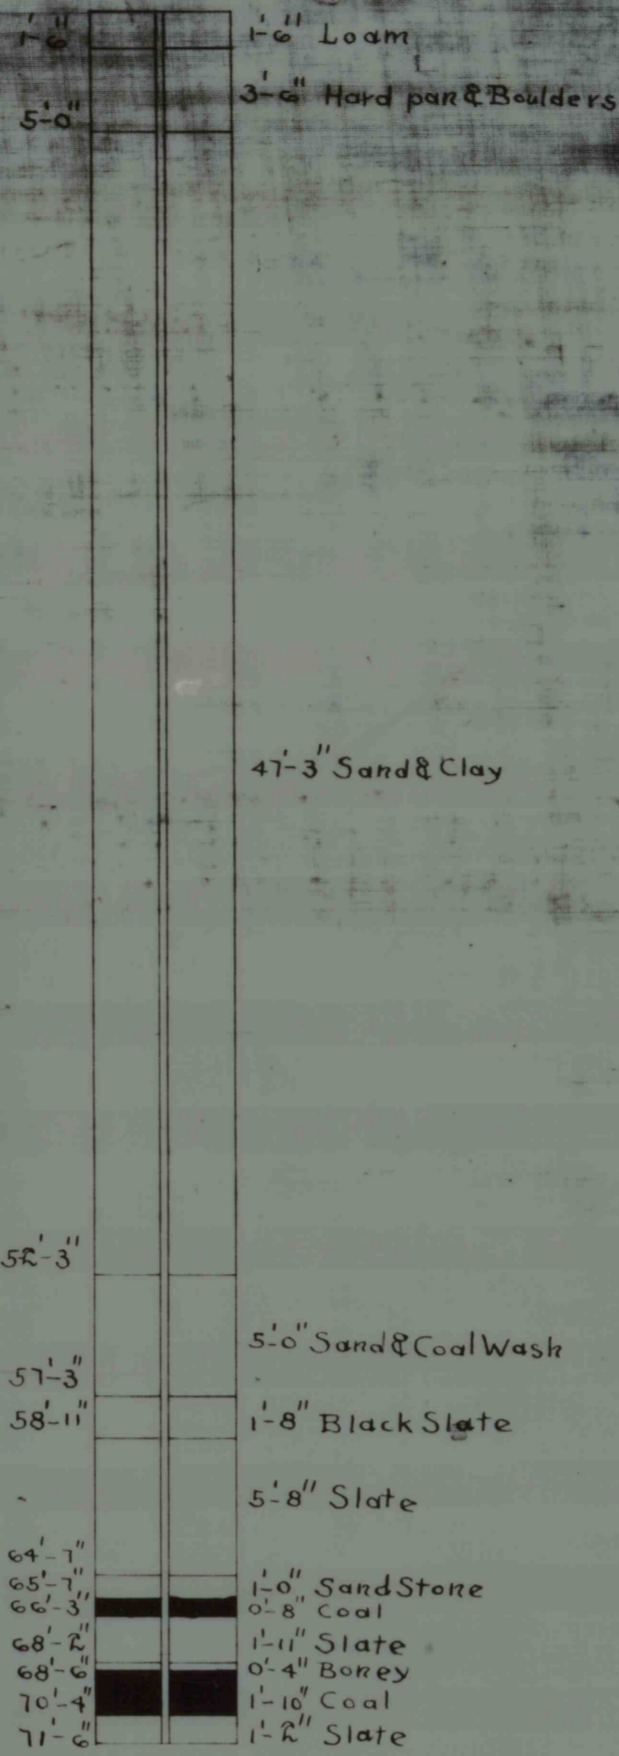


71

(5)

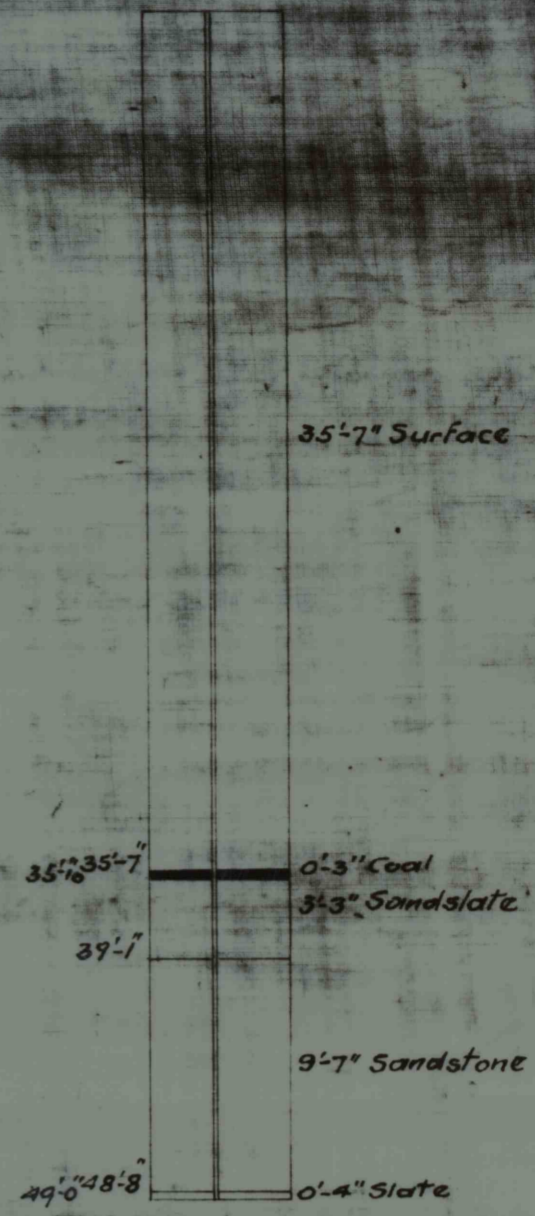


69

(3)

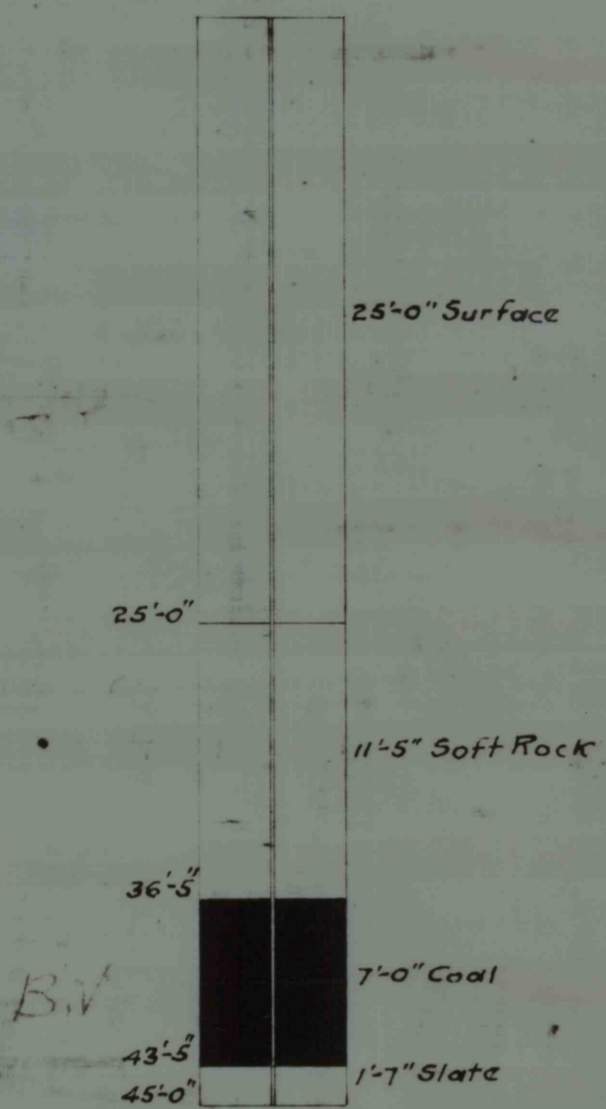


72

(6)

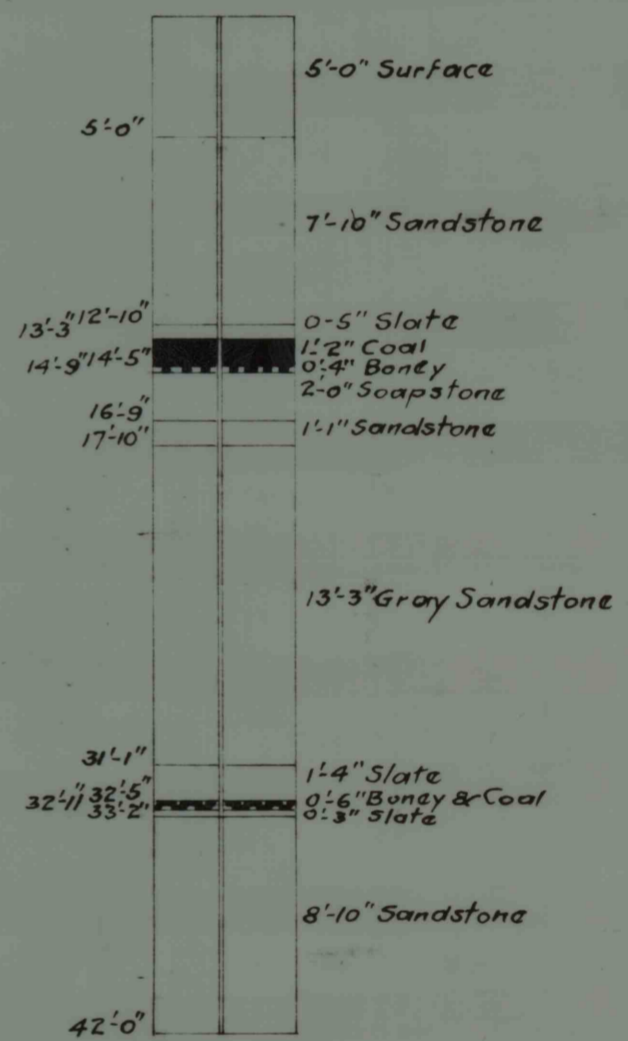


89

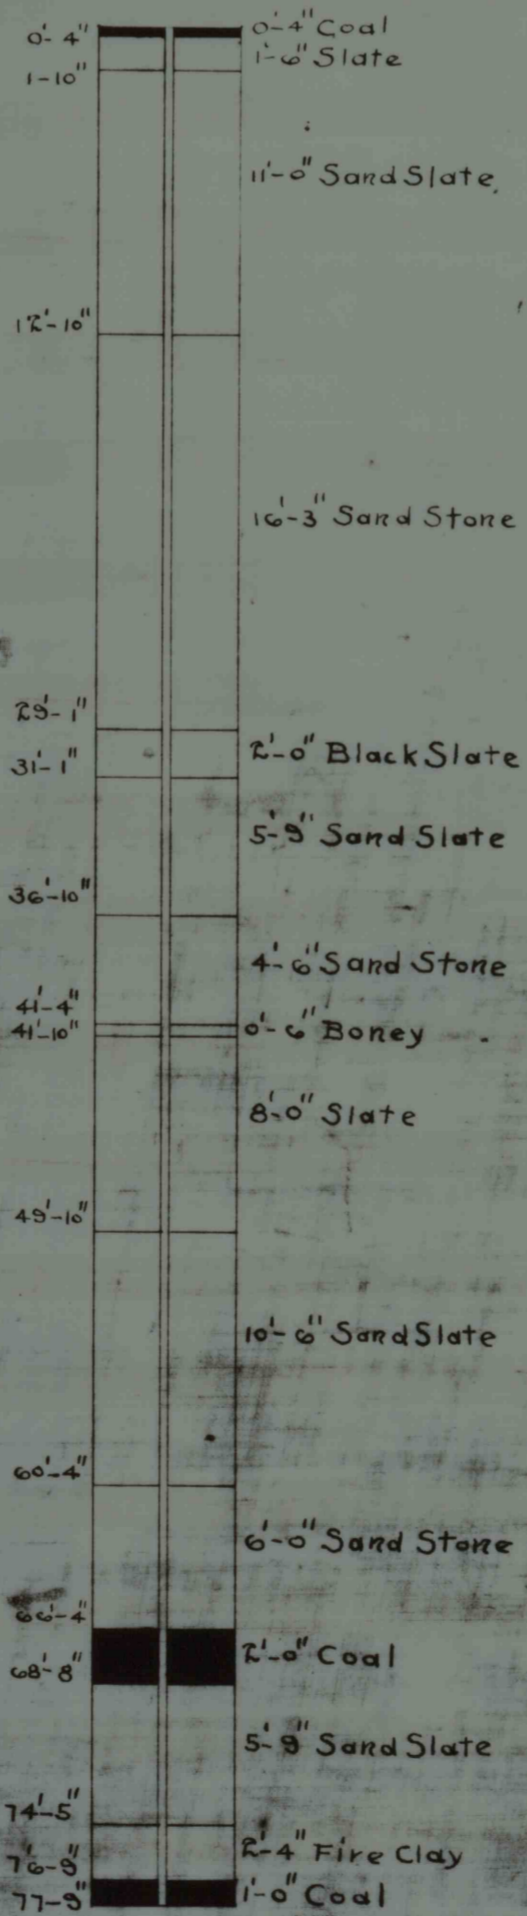

73

(7)

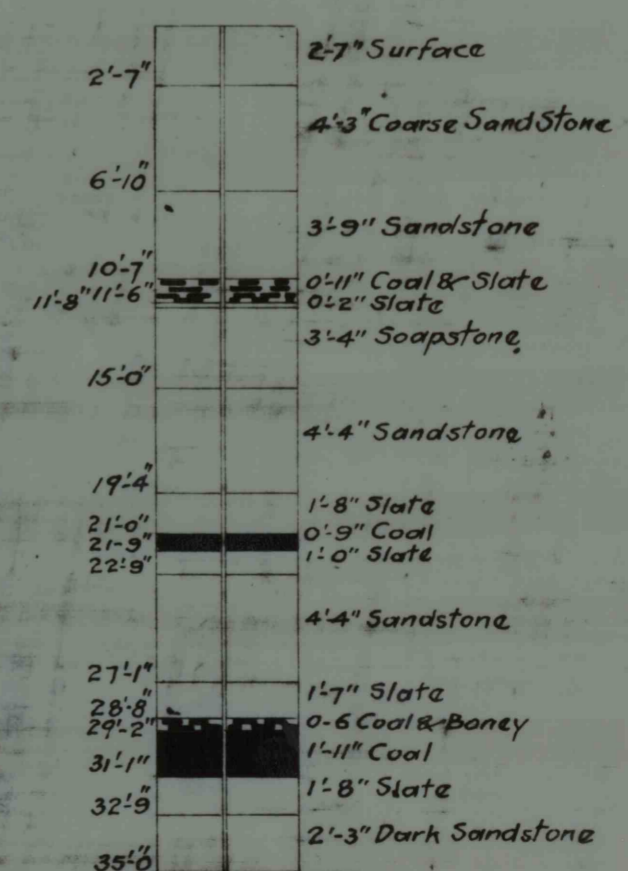

70

(4)

