


S 2836.5
W 3469.1

27

El. 1977.7
1977.5

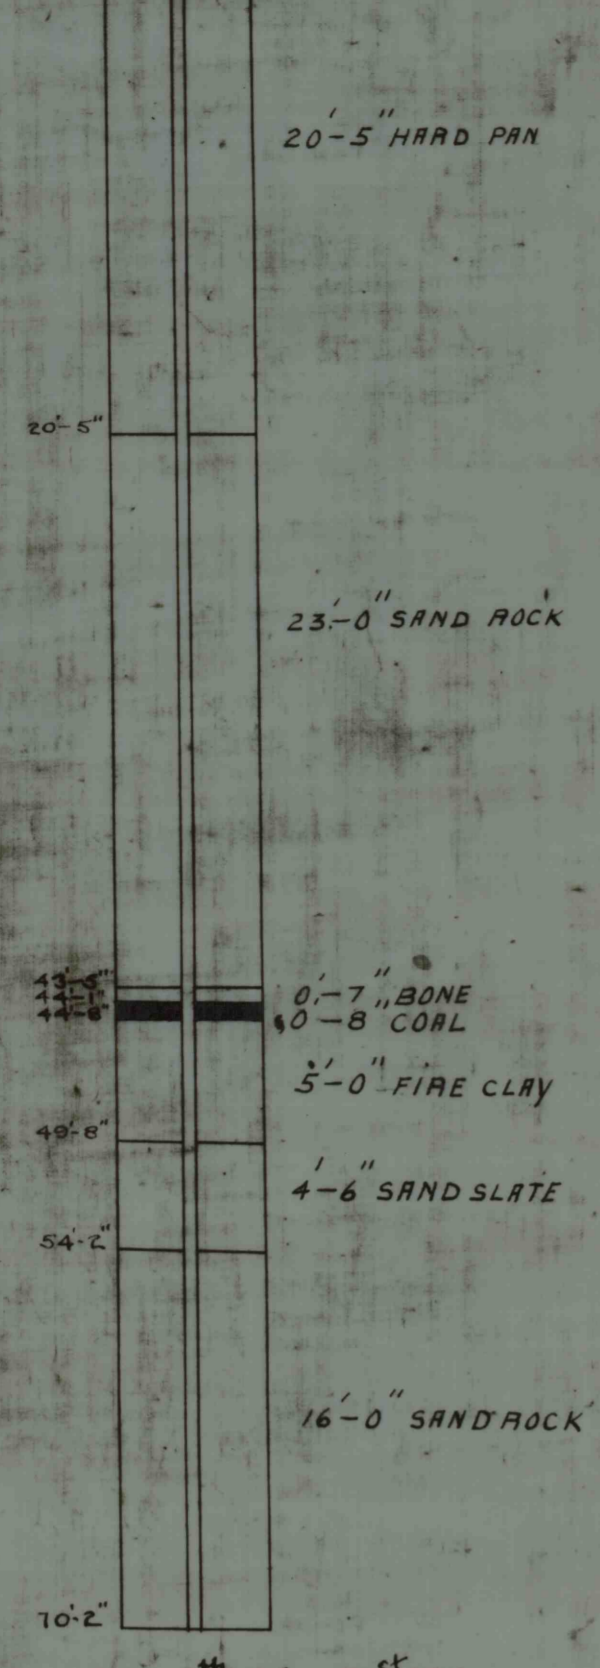


May 14th - May 21st 1911
George Jackson.

S 3346.8
W 3547.0

28

El. 1959.0
1958.9

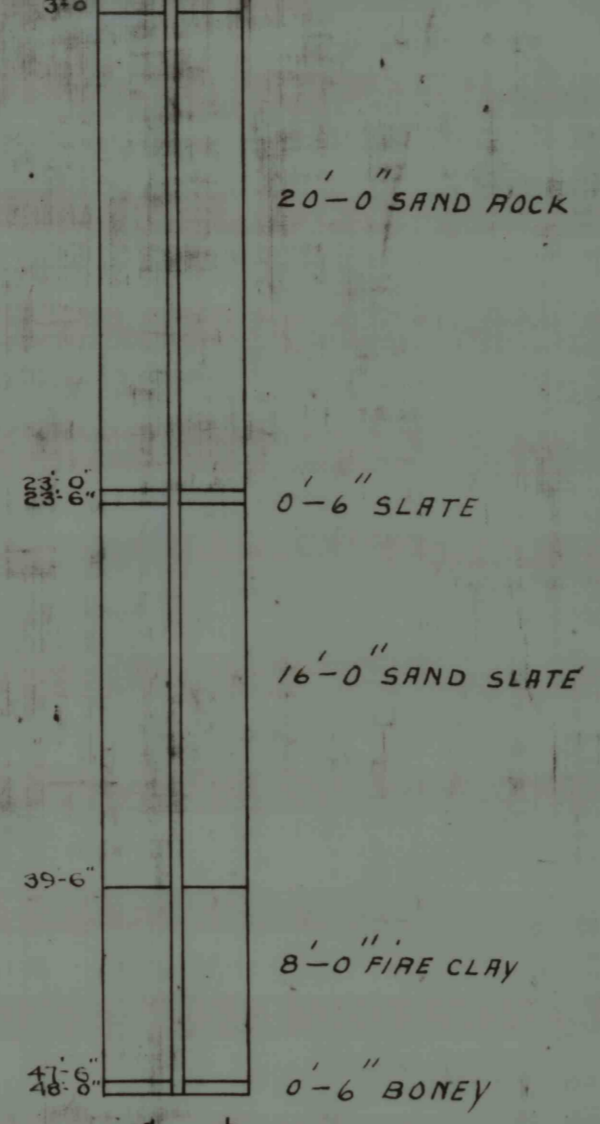


March 23rd - 28th 1911
George Jackson.

S 1074.2
E 12548.3

34

El. 1468.3

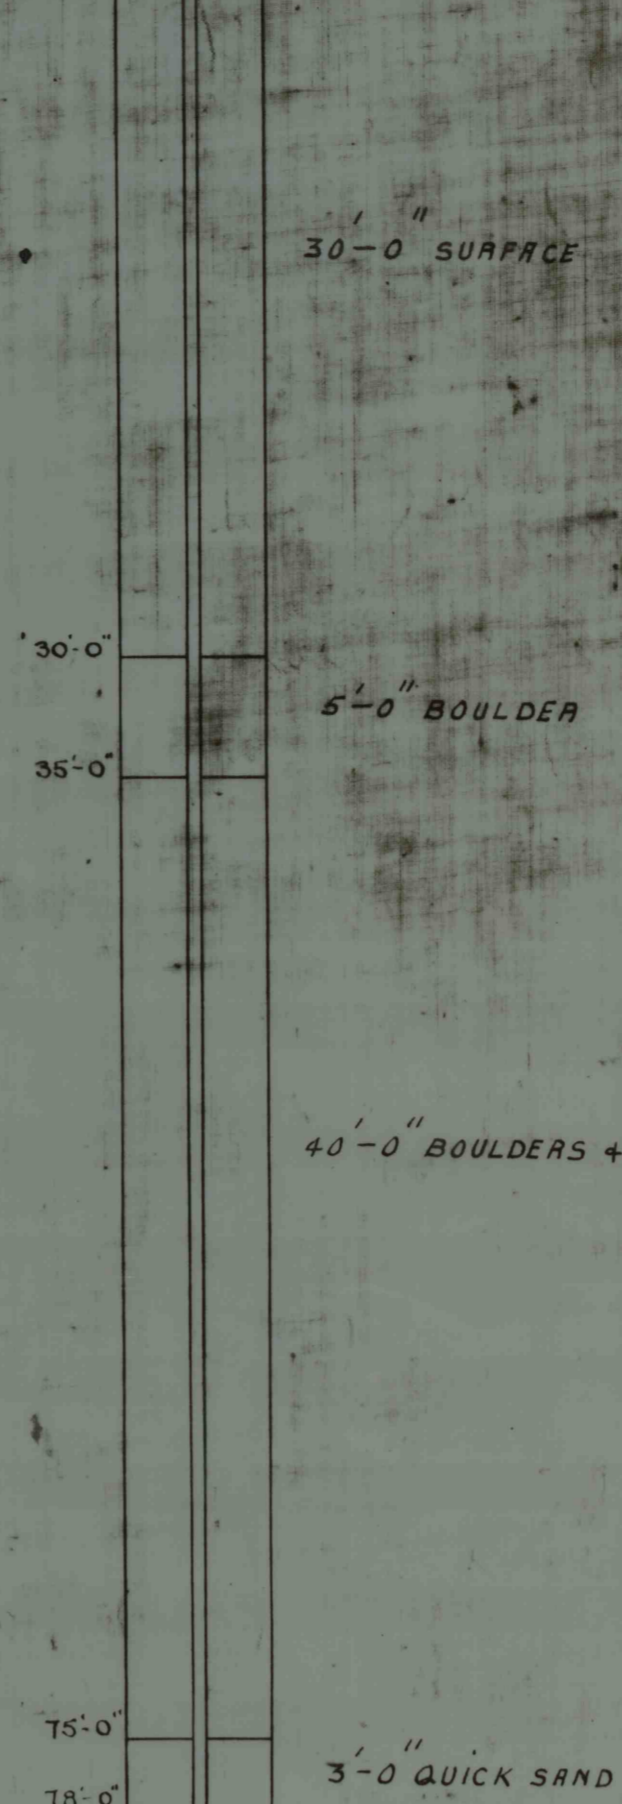


June 3rd - 18th 1911
George Jackson.

S 3233.4
E 12862.2


36

El. 1965.2

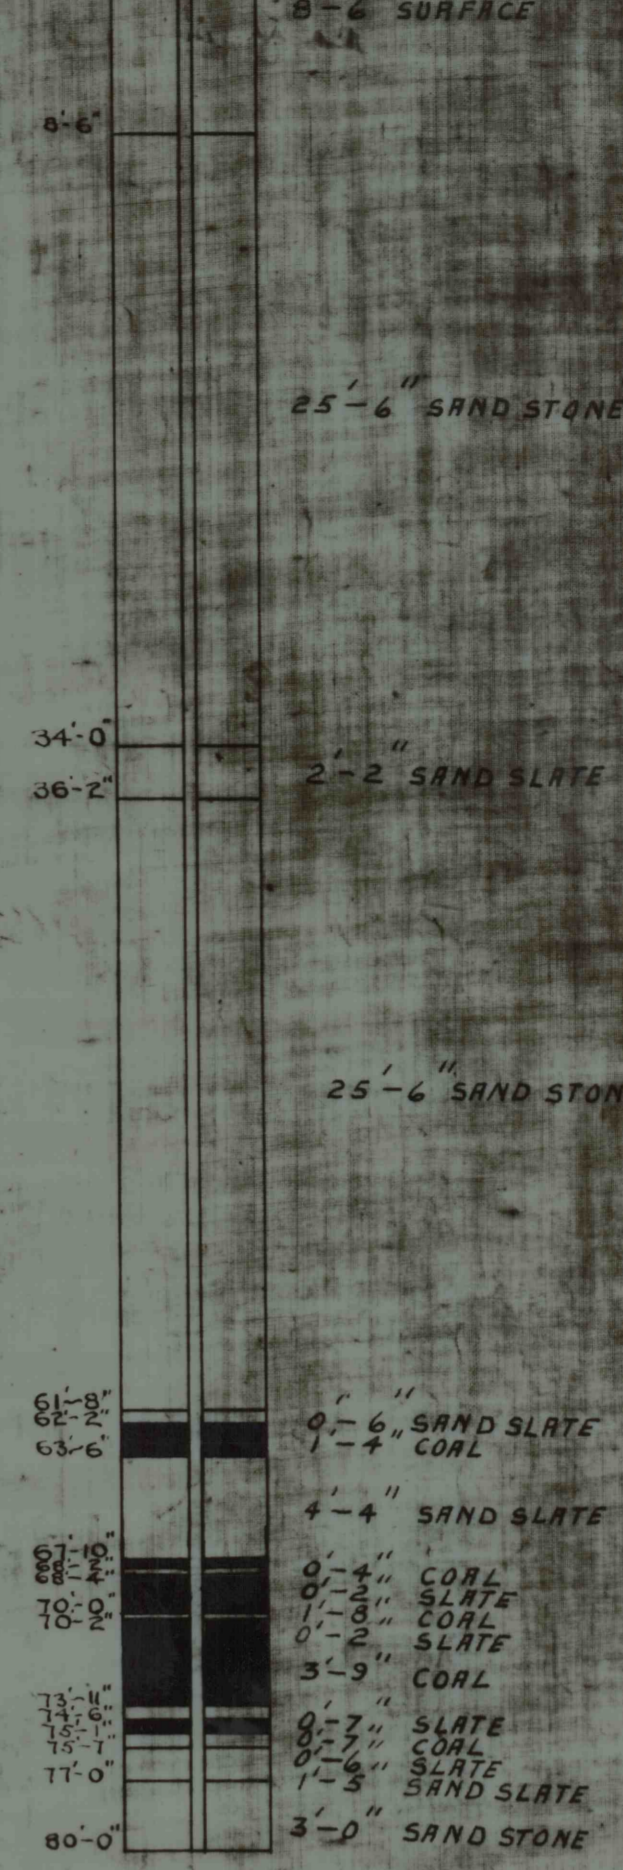


July 18th - 20th 1911
T. A. Toolan.


35

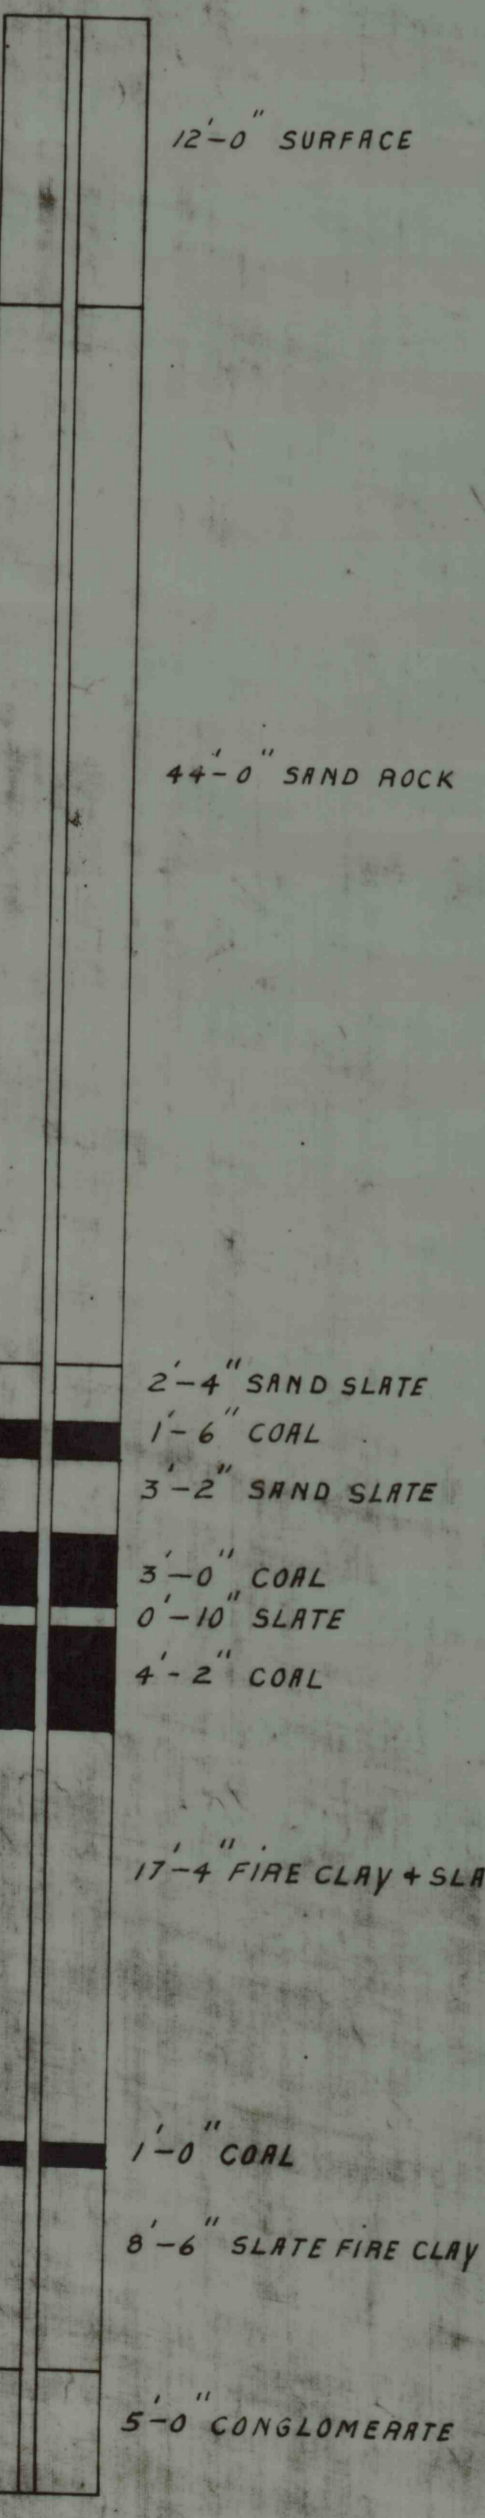

39

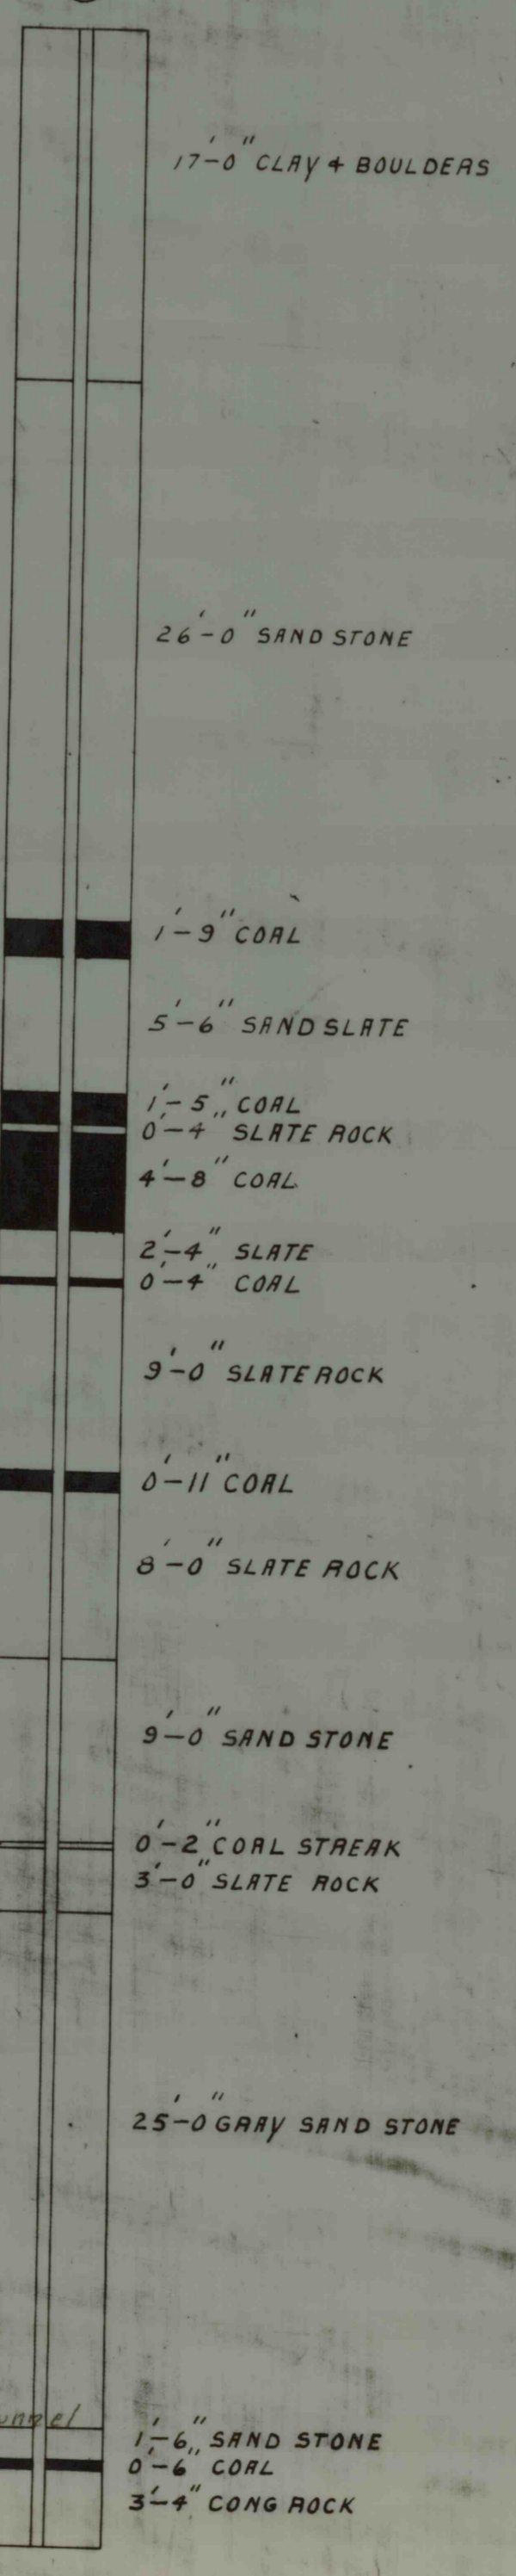

33

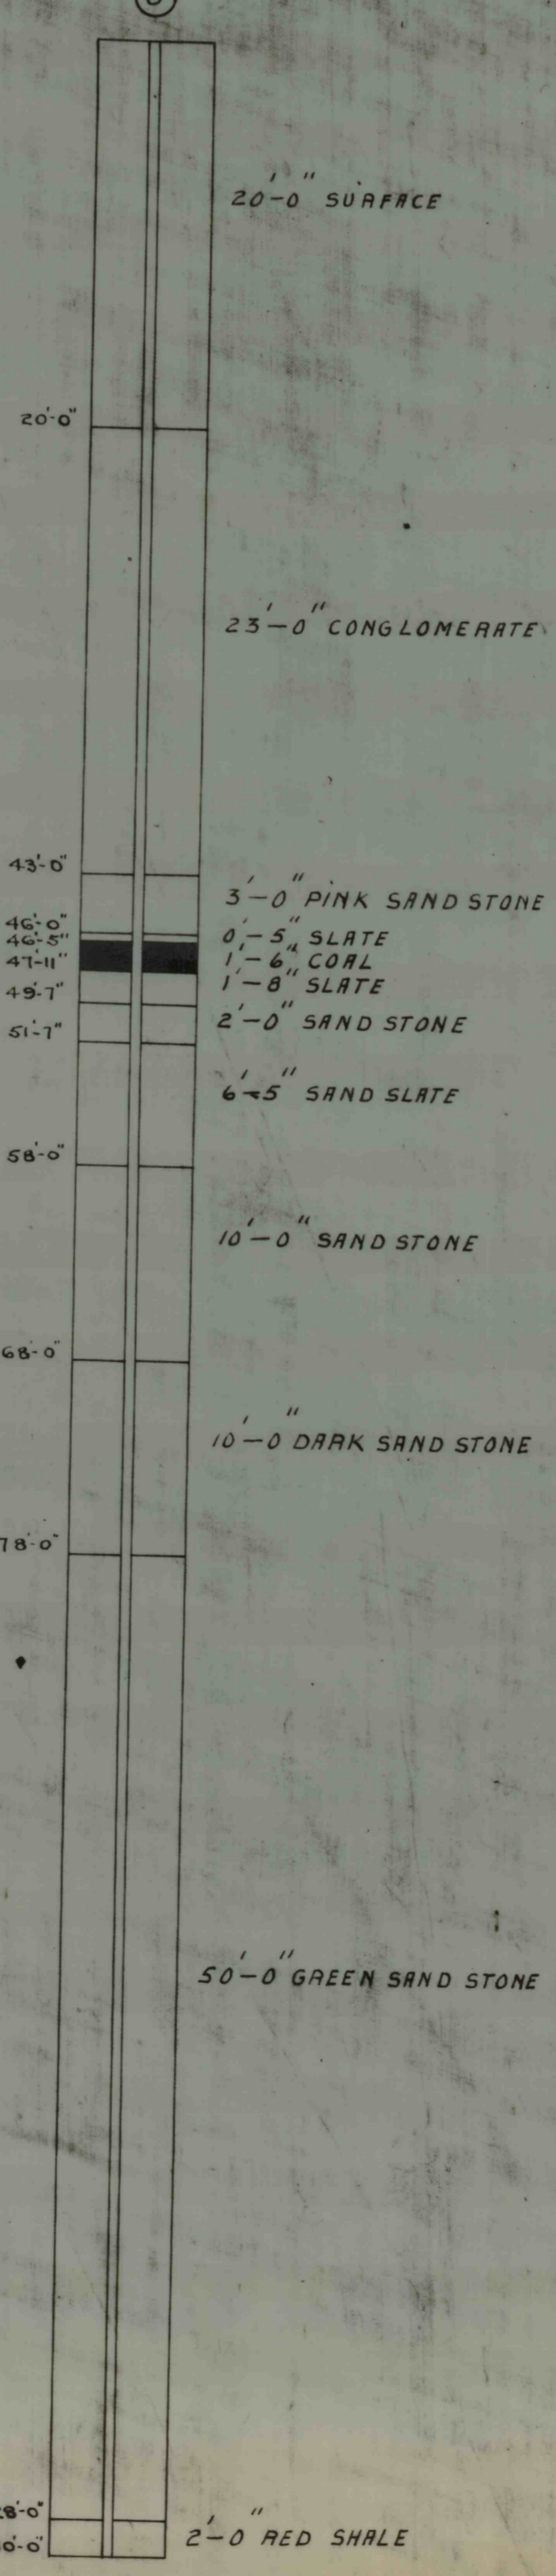

38

