
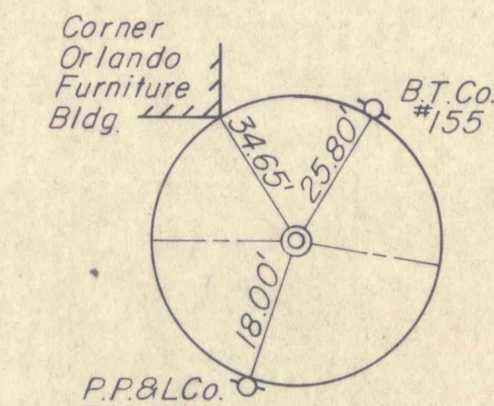



DISTRICT	COUNTY	ROUTE	SECTION	SHEET
4-0	LACKAWANNA	MAIN ST.		17 of 28
BLAKELY BOROUGH				
REVISION NUMBER	REVISIONS	DATE	BY	

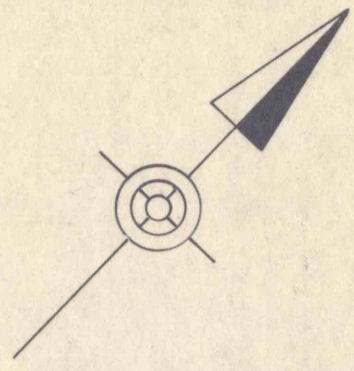


B.M. No. 4 Elev. 782.67
 Flange Nut on Fire Hydrant
 15' Right Sta. 26+62

PP&L Co. 58909
 N 48524
 P.I. STA. 27+93.32 Sur. & Constr. C

P.I. Sta. 27+93.32 Constr. C
 $\Delta = 10^\circ - 41' - 30''$ Rt.
 $D = 16^\circ - 00'$
 $T = 33.51'$
 $L = 66.82'$
 $R = 358.10'$
 P.C. Sta. 27+59.81
 P.T. Sta. 28+26.63 Bk. =
 P.T. Sta. 28+26.83 Ahd.

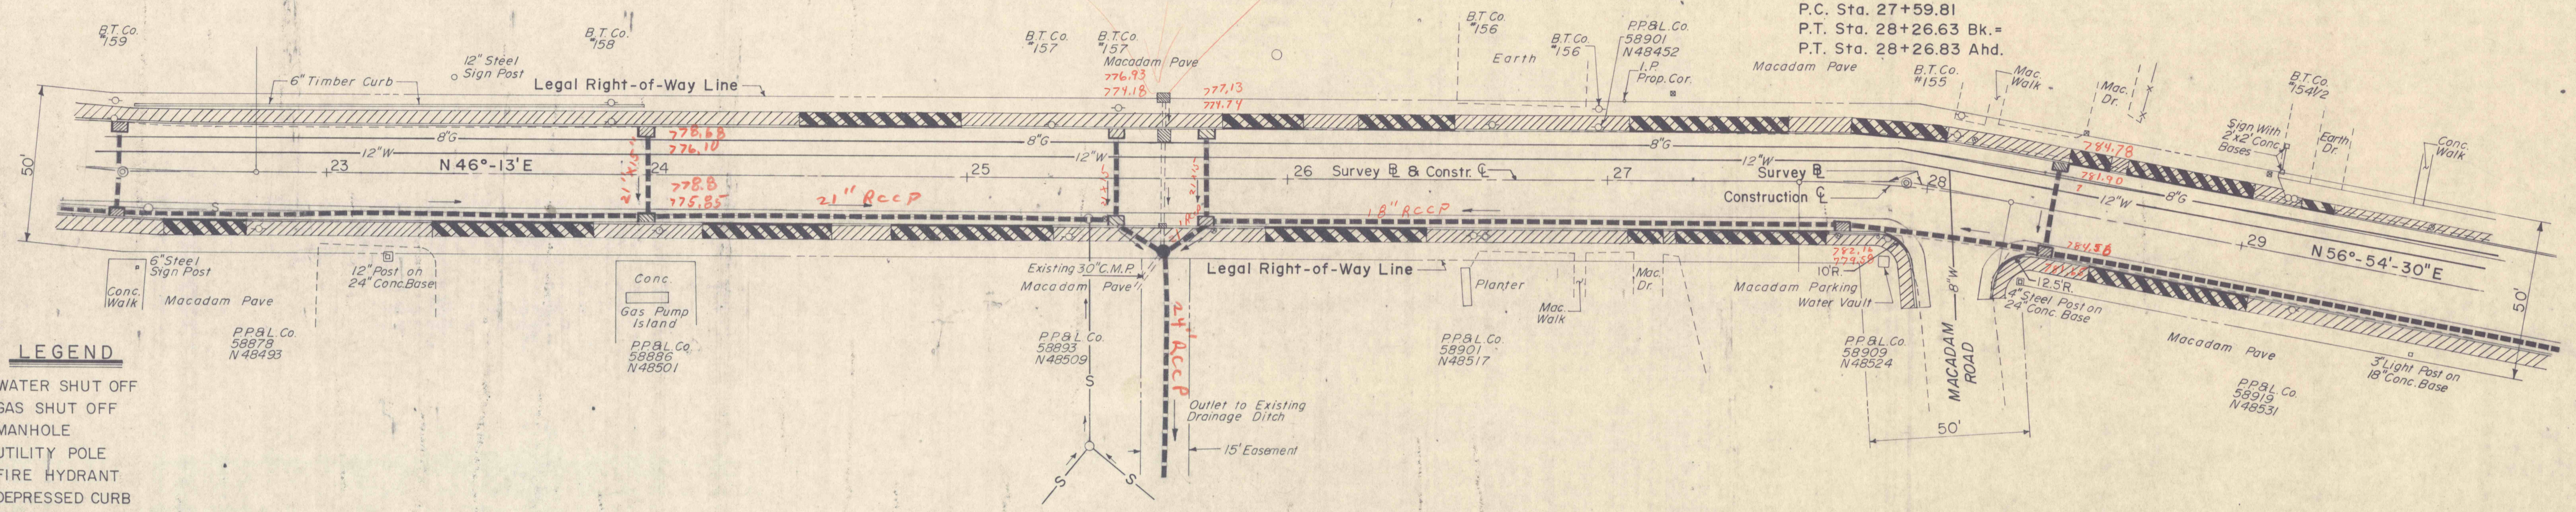

- LEGEND**
- WATER SHUT OFF
 - GAS SHUT OFF
 - MANHOLE
 - UTILITY POLE
 - FIRE HYDRANT
 - DEPRESSED CURB
 - ▨ REINFORCED CONCRETE SIDEWALK
 - ▨ BITUMINOUS WALK ADJUSTMENT
 - ▨ BITUMINOUS DRIVE ADJUSTMENT
 - STORM LINE
 - ▨ CEMENT CONCRETE SIDEWALK
 - ▨ SEEDING & MULCHING
 - TYPE A MANHOLE

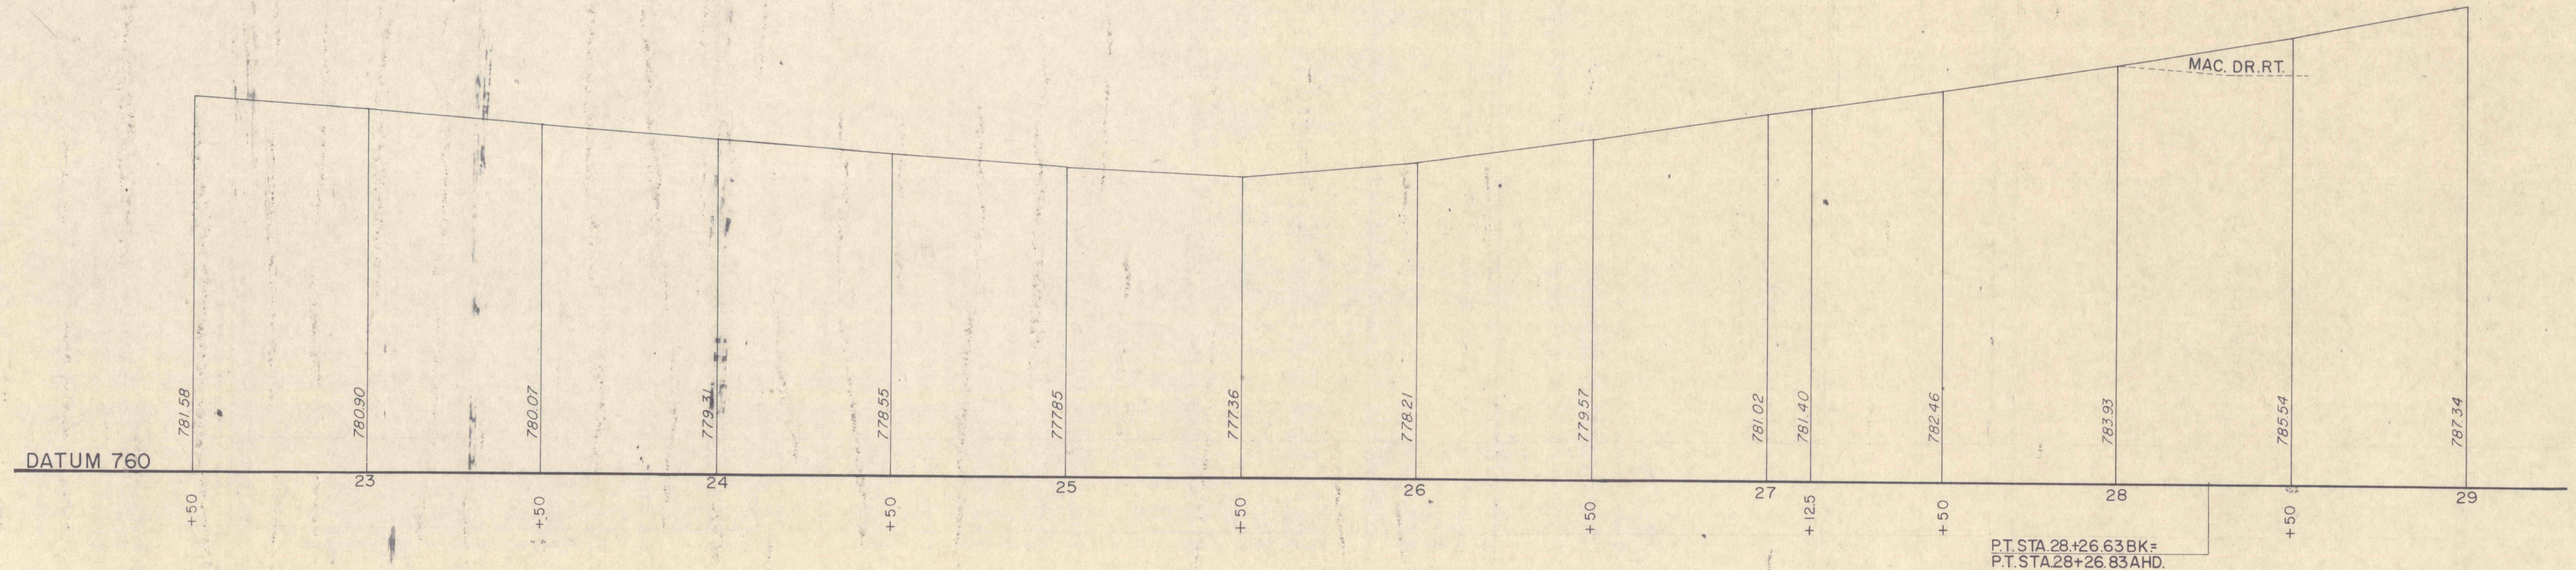

P.T. STA. 28+26.63 BK =
 P.T. STA. 28+26.83 AHD.