


DISTRICT	COUNTY	ROUTE	SECTION	SHEET
4-0	LACKAWANNA	MAIN ST.		21 of 28
BLAKELY BOROUGH				
REVISION NUMBER	REVISIONS	DATE	BY	

P.I. Sta. 36+86.64 Constr.  $\ell$   
 $\Delta = 5^{\circ}-14' Lt.$   
 $D = 9^{\circ}-00'$   
 $T = 29.09'$   
 $L = 58.15'$   
 $R = 636.62'$

P.I. STA. 36+86.64 SUR.  $\ell$  & CONSTR.  $\ell$   
 $\Delta = 5^{\circ}-14' Lt.$

P.O.T. STA. 43+60.00 SUR.  $\ell$  & CONSTR.  $\ell$

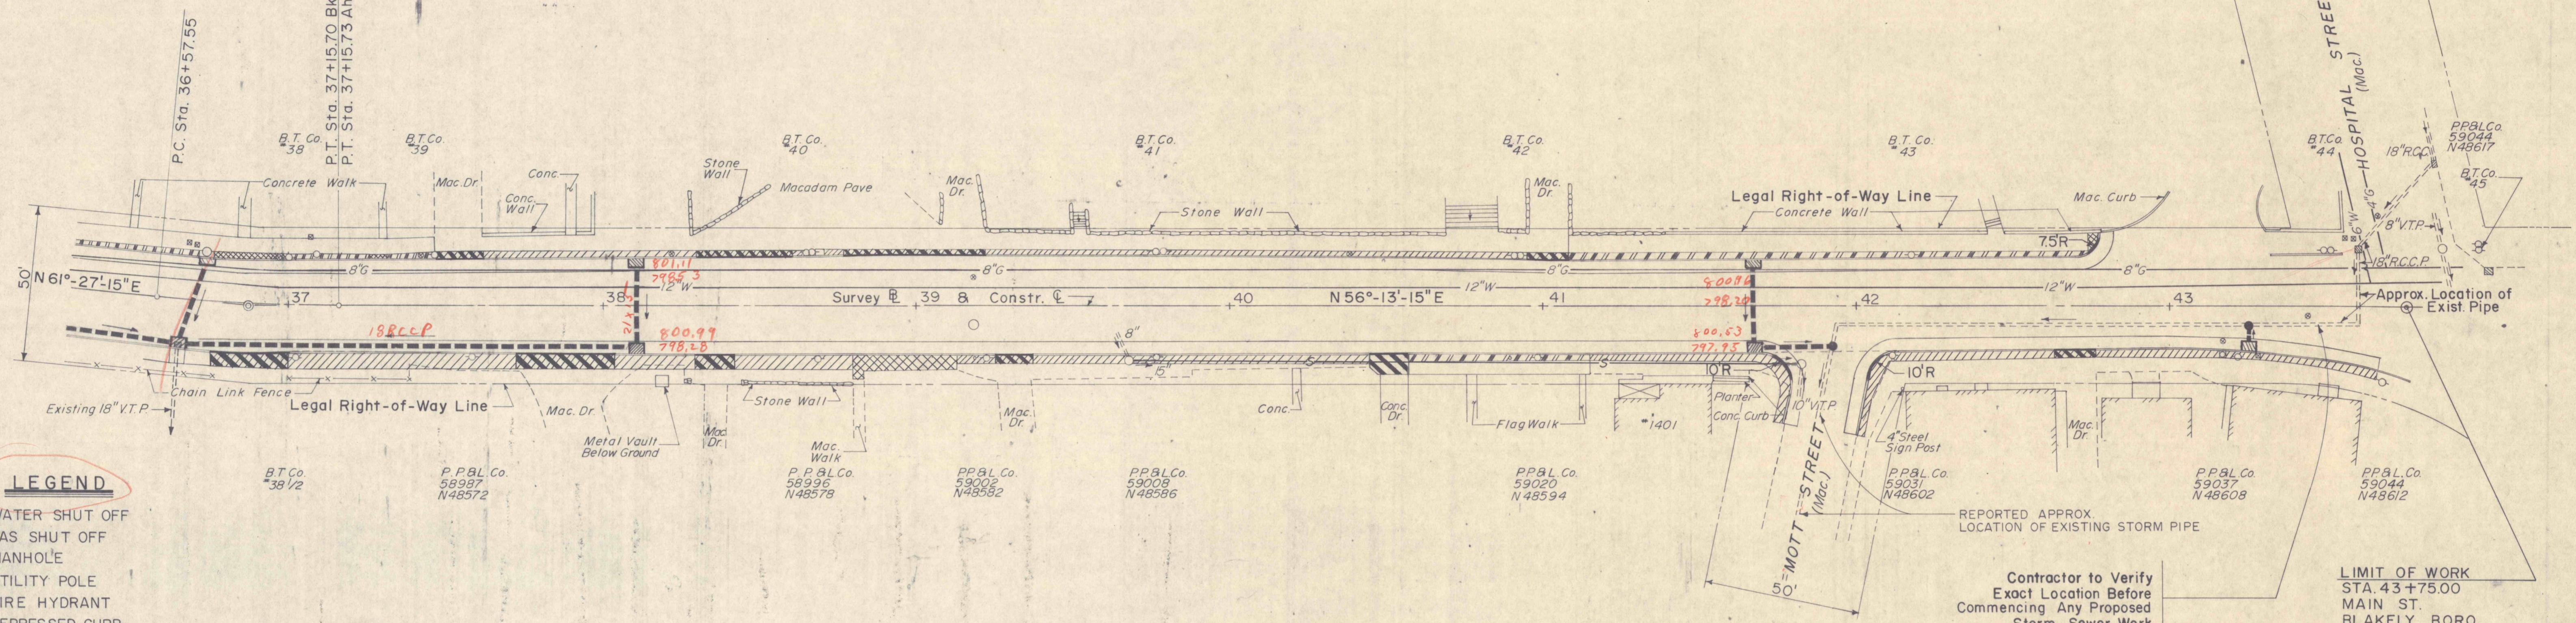

- LEGEND**
- WATER SHUT OFF
  - GAS SHUT OFF
  - MANHOLE
  - UTILITY POLE
  - FIRE HYDRANT
  - DEPRESSED CURB
  - ▨ REINFORCED CONCRETE SIDEWALK
  - ▨ BITUMINOUS WALK ADJUSTMENT
  - ▨ BITUMINOUS DRIVE ADJUSTMENT
  - STORM LINE
  - ▨ CEMENT CONCRETE SIDEWALK
  - ▨ SEEDING & MULCHING
  - TYPE A MANHOLE
  - ▨ SODDING

Contractor to Verify Exact Location Before Commencing Any Proposed Storm Sewer Work

LIMIT OF WORK STA. 43+75.00 MAIN ST. BLAKELY BORO. LACKAWANNA CO.

