


145-1

145-1

00
00

Excluded
CHINA OR A

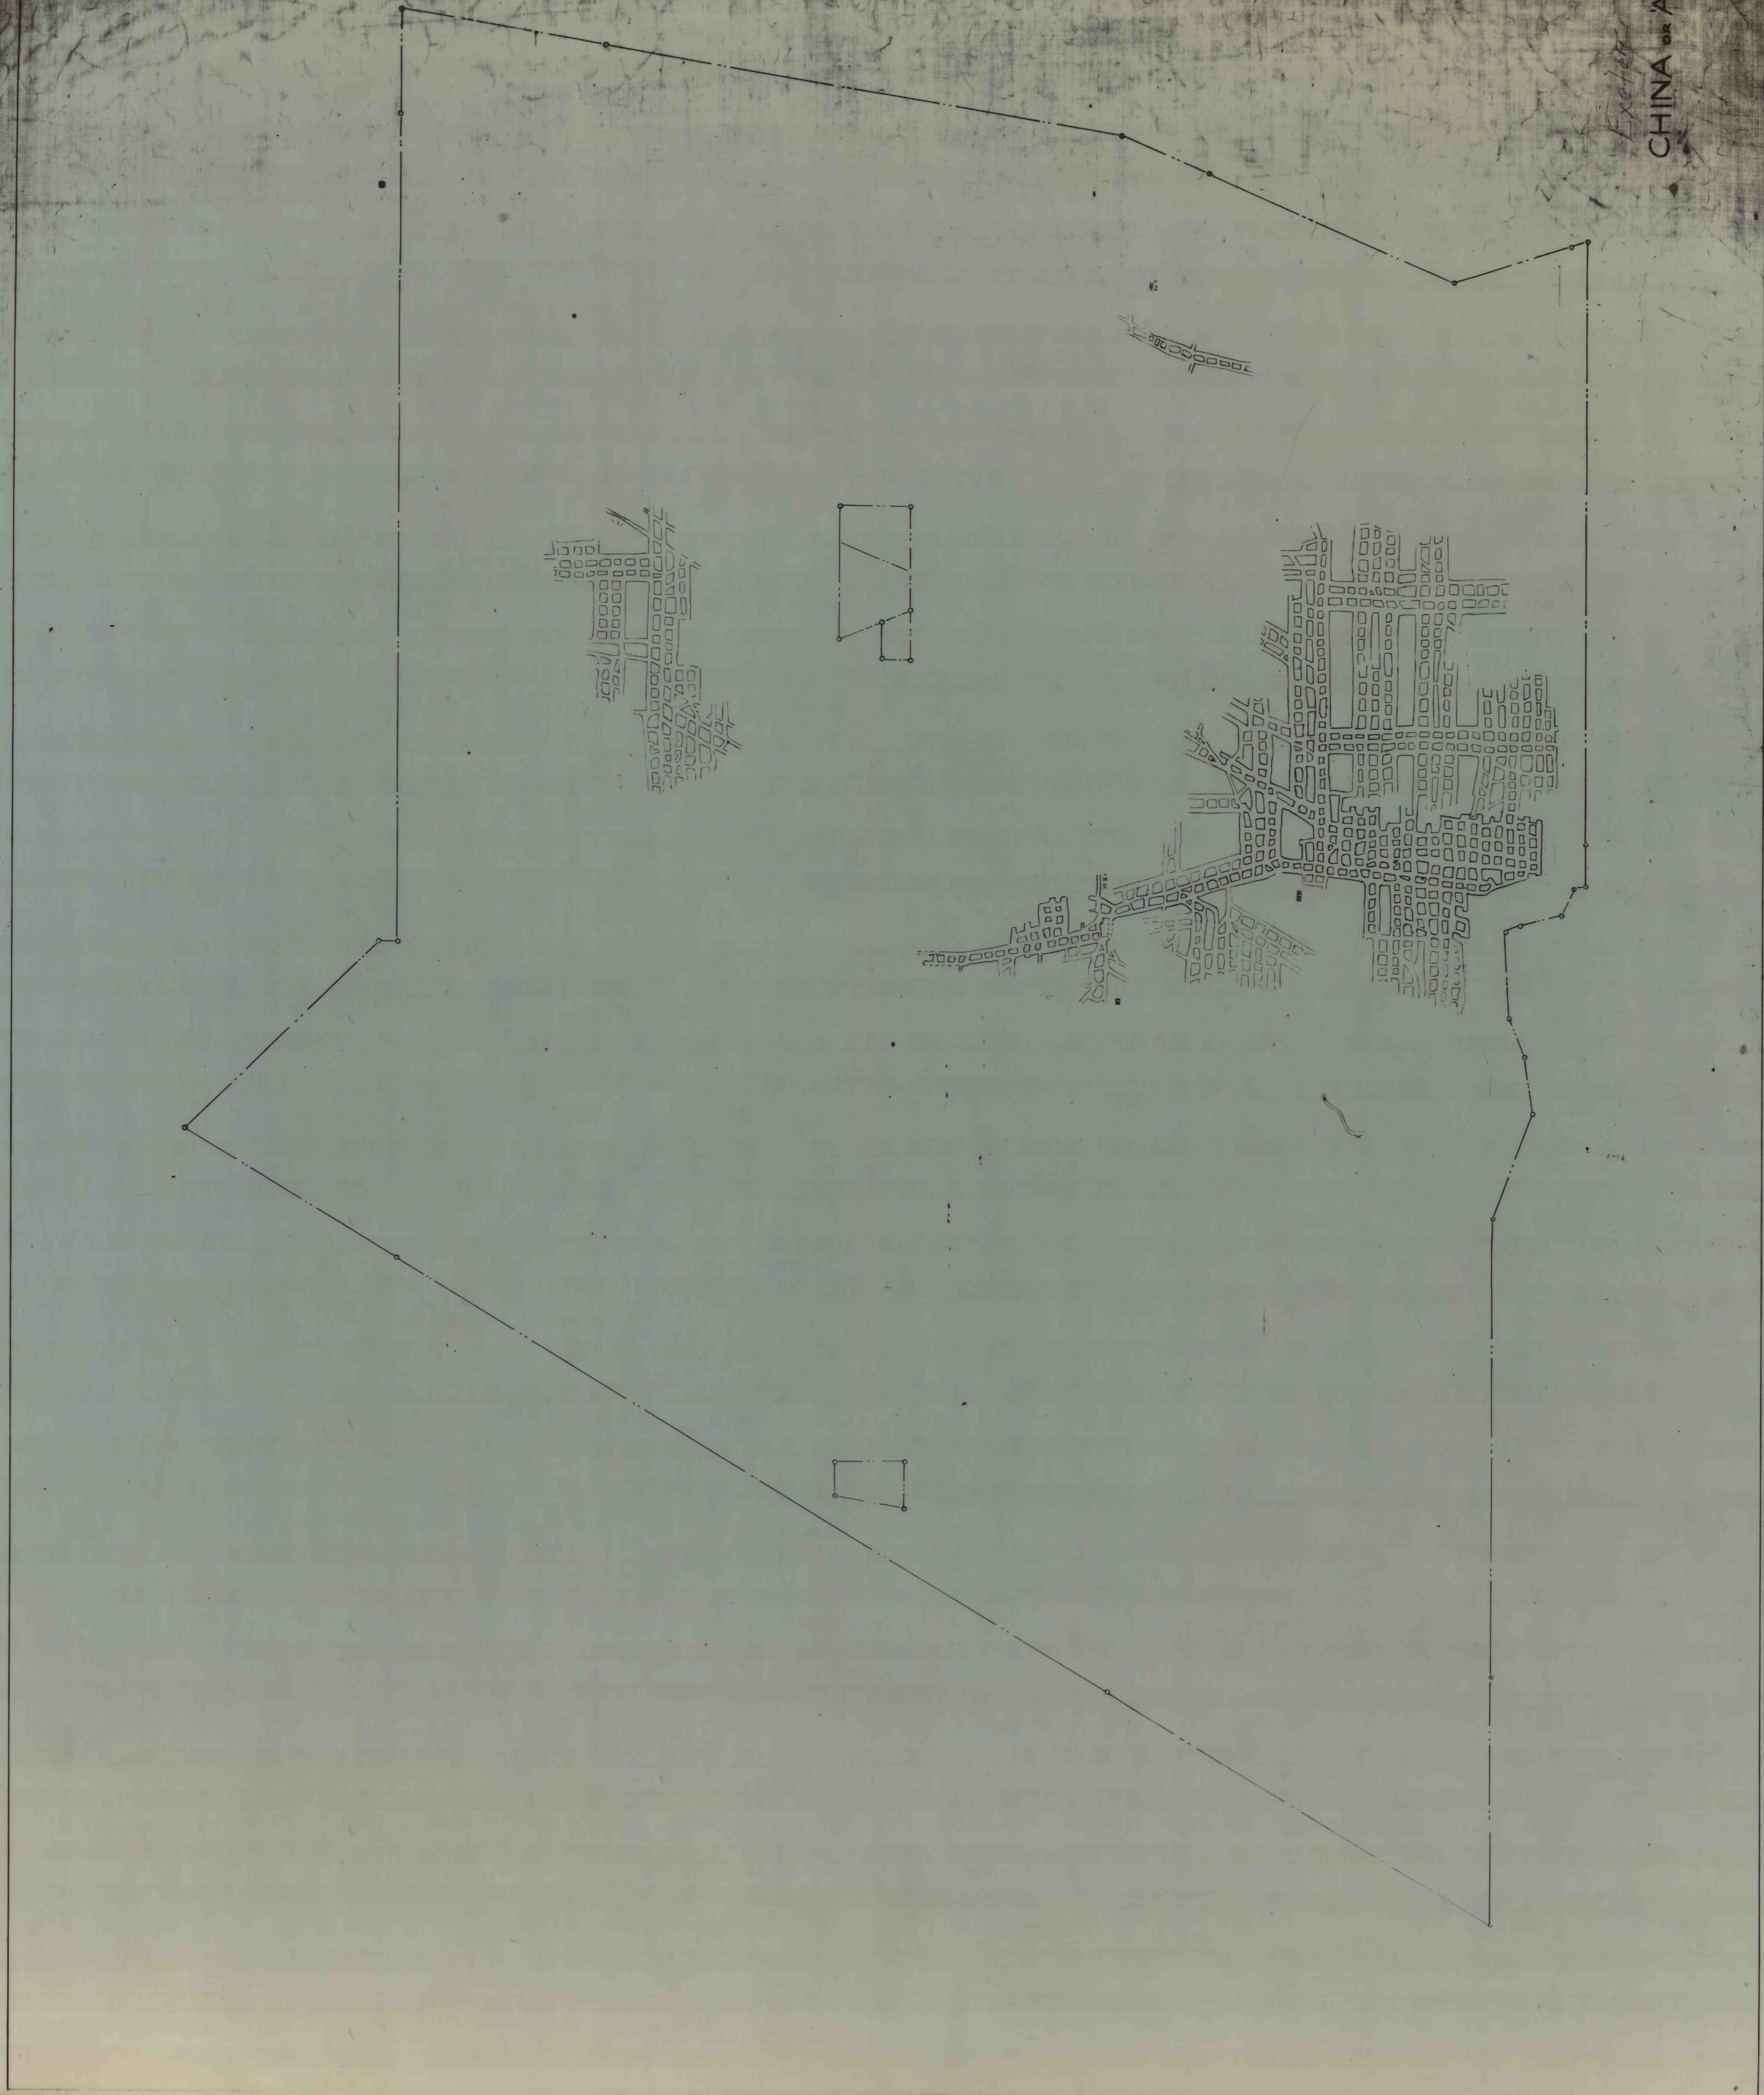

145-1