


145

EXTENSION OF MINE WORKINGS  
APPLIED HEREON BY [ ]  
ON [ ]

EXETER  
BANKTON  
TOP BED ASH  
LAST POSTING FILLING  
ROBBING

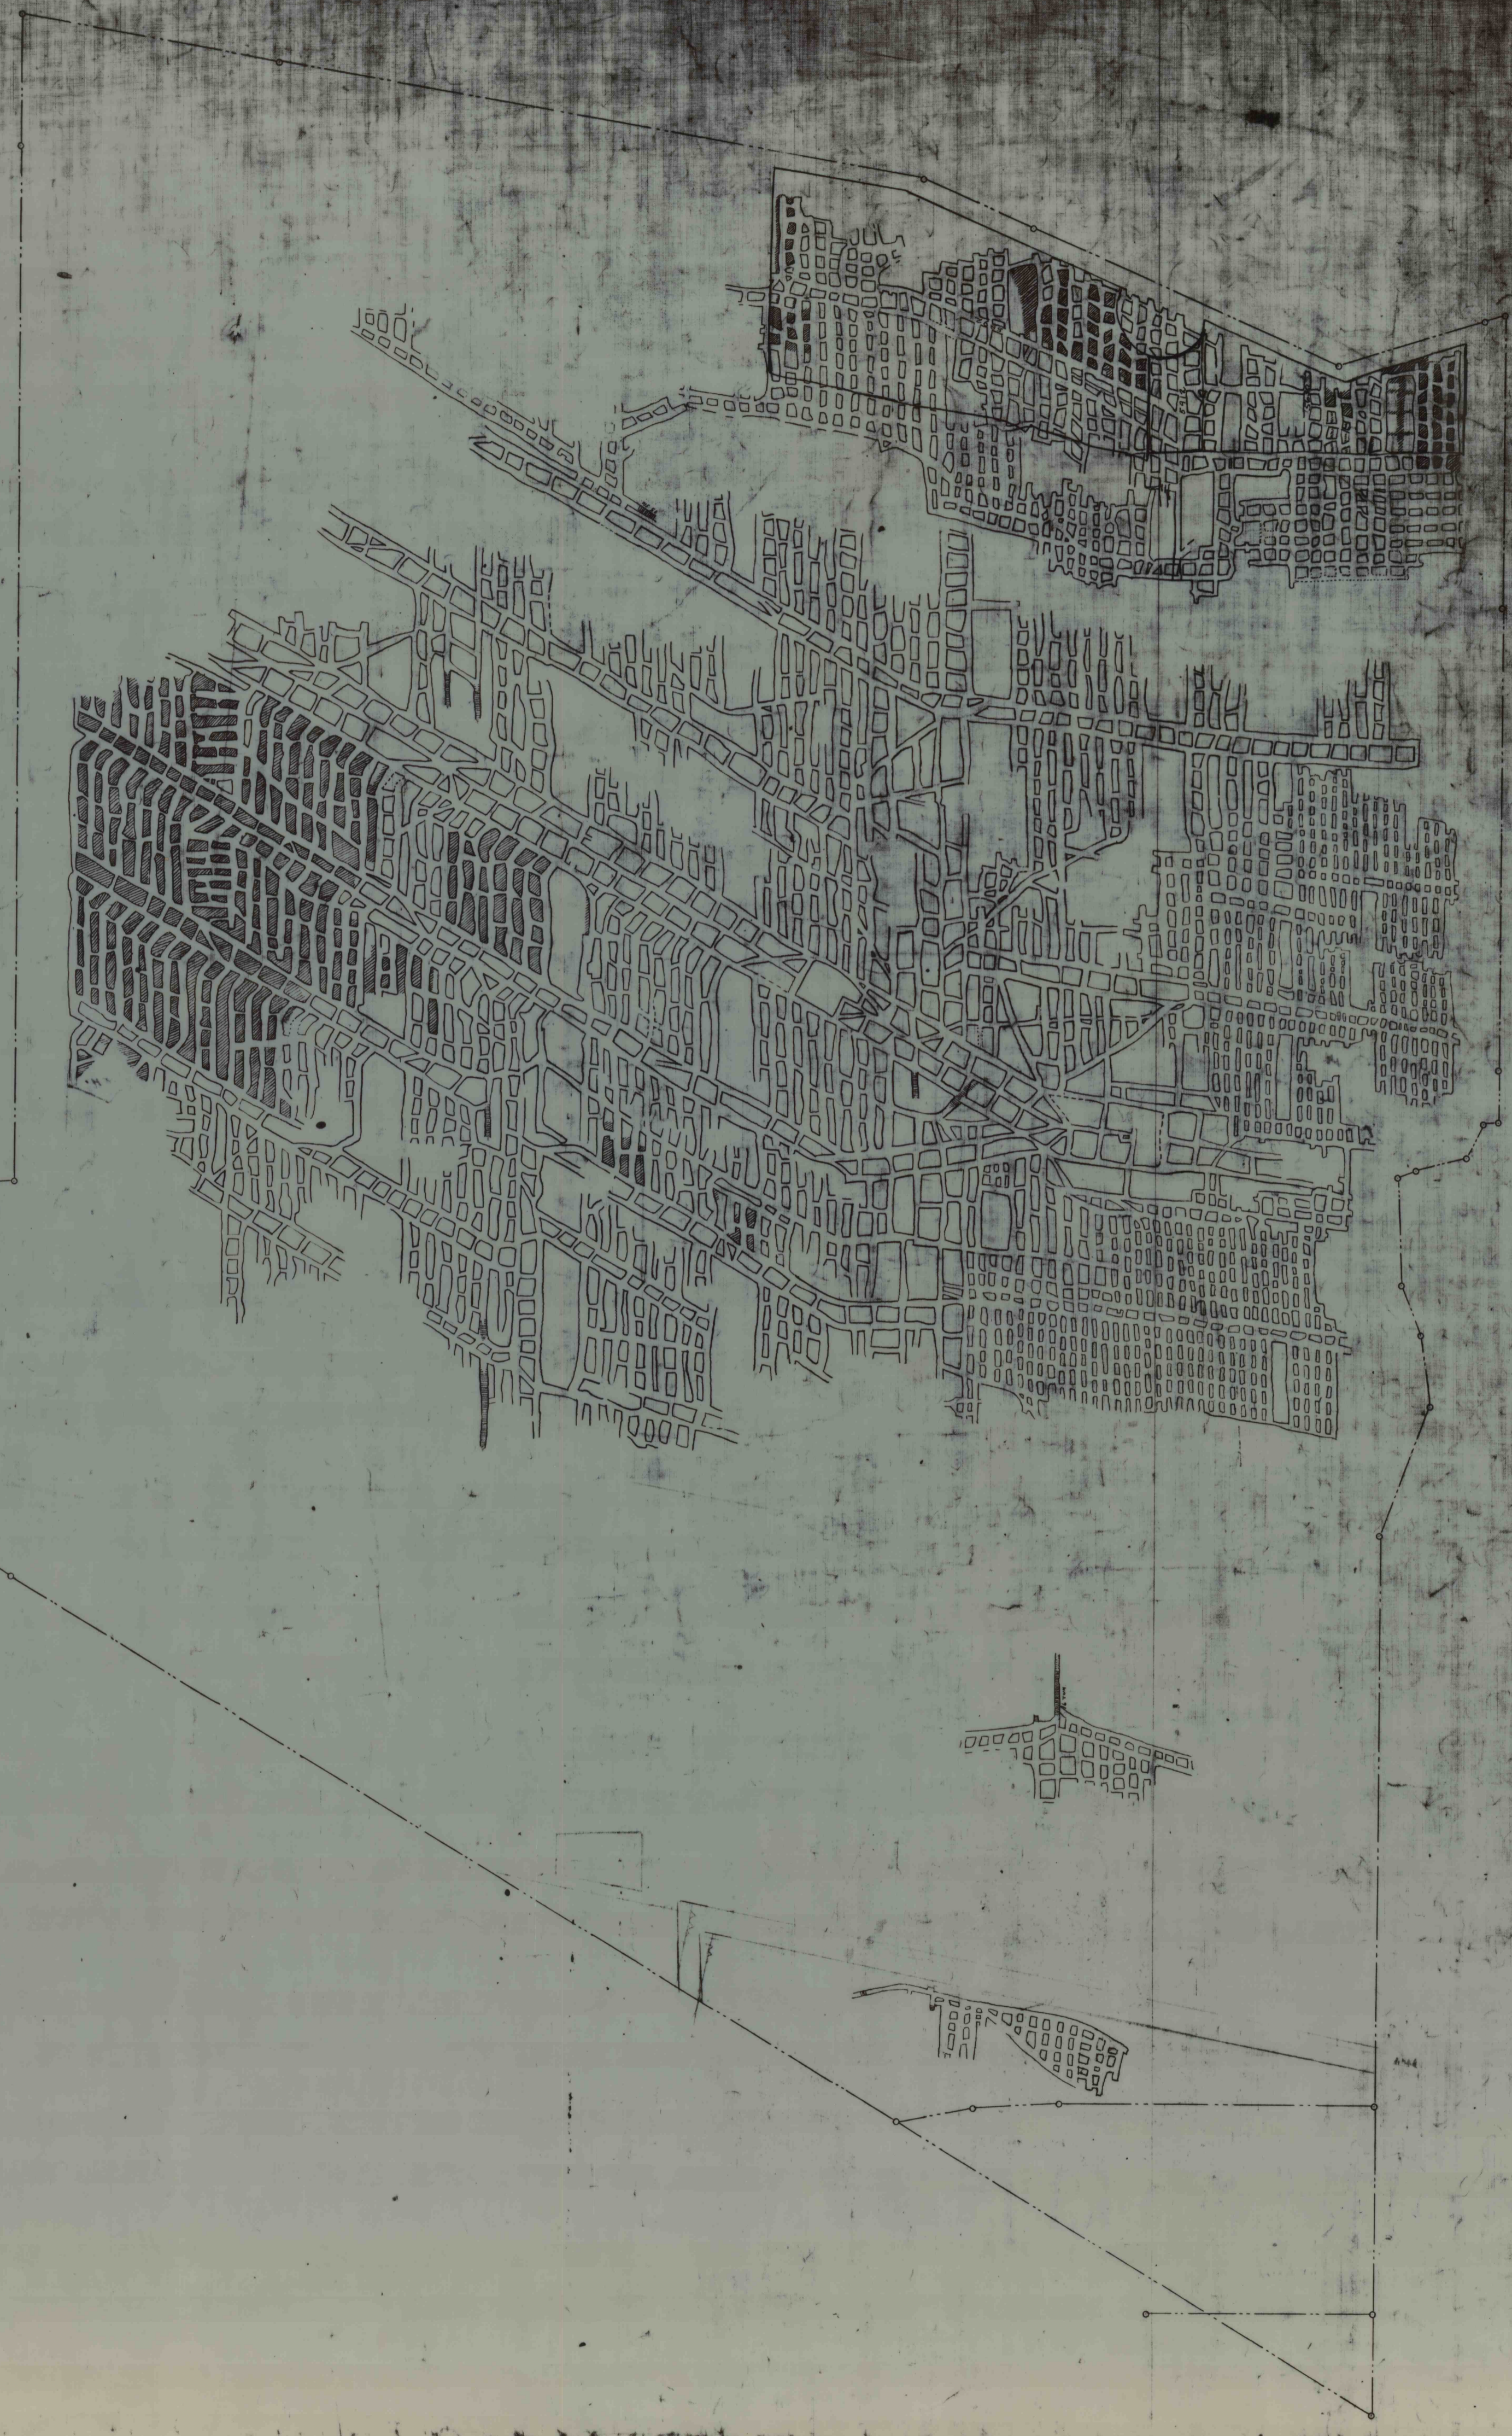

145-4