


1451

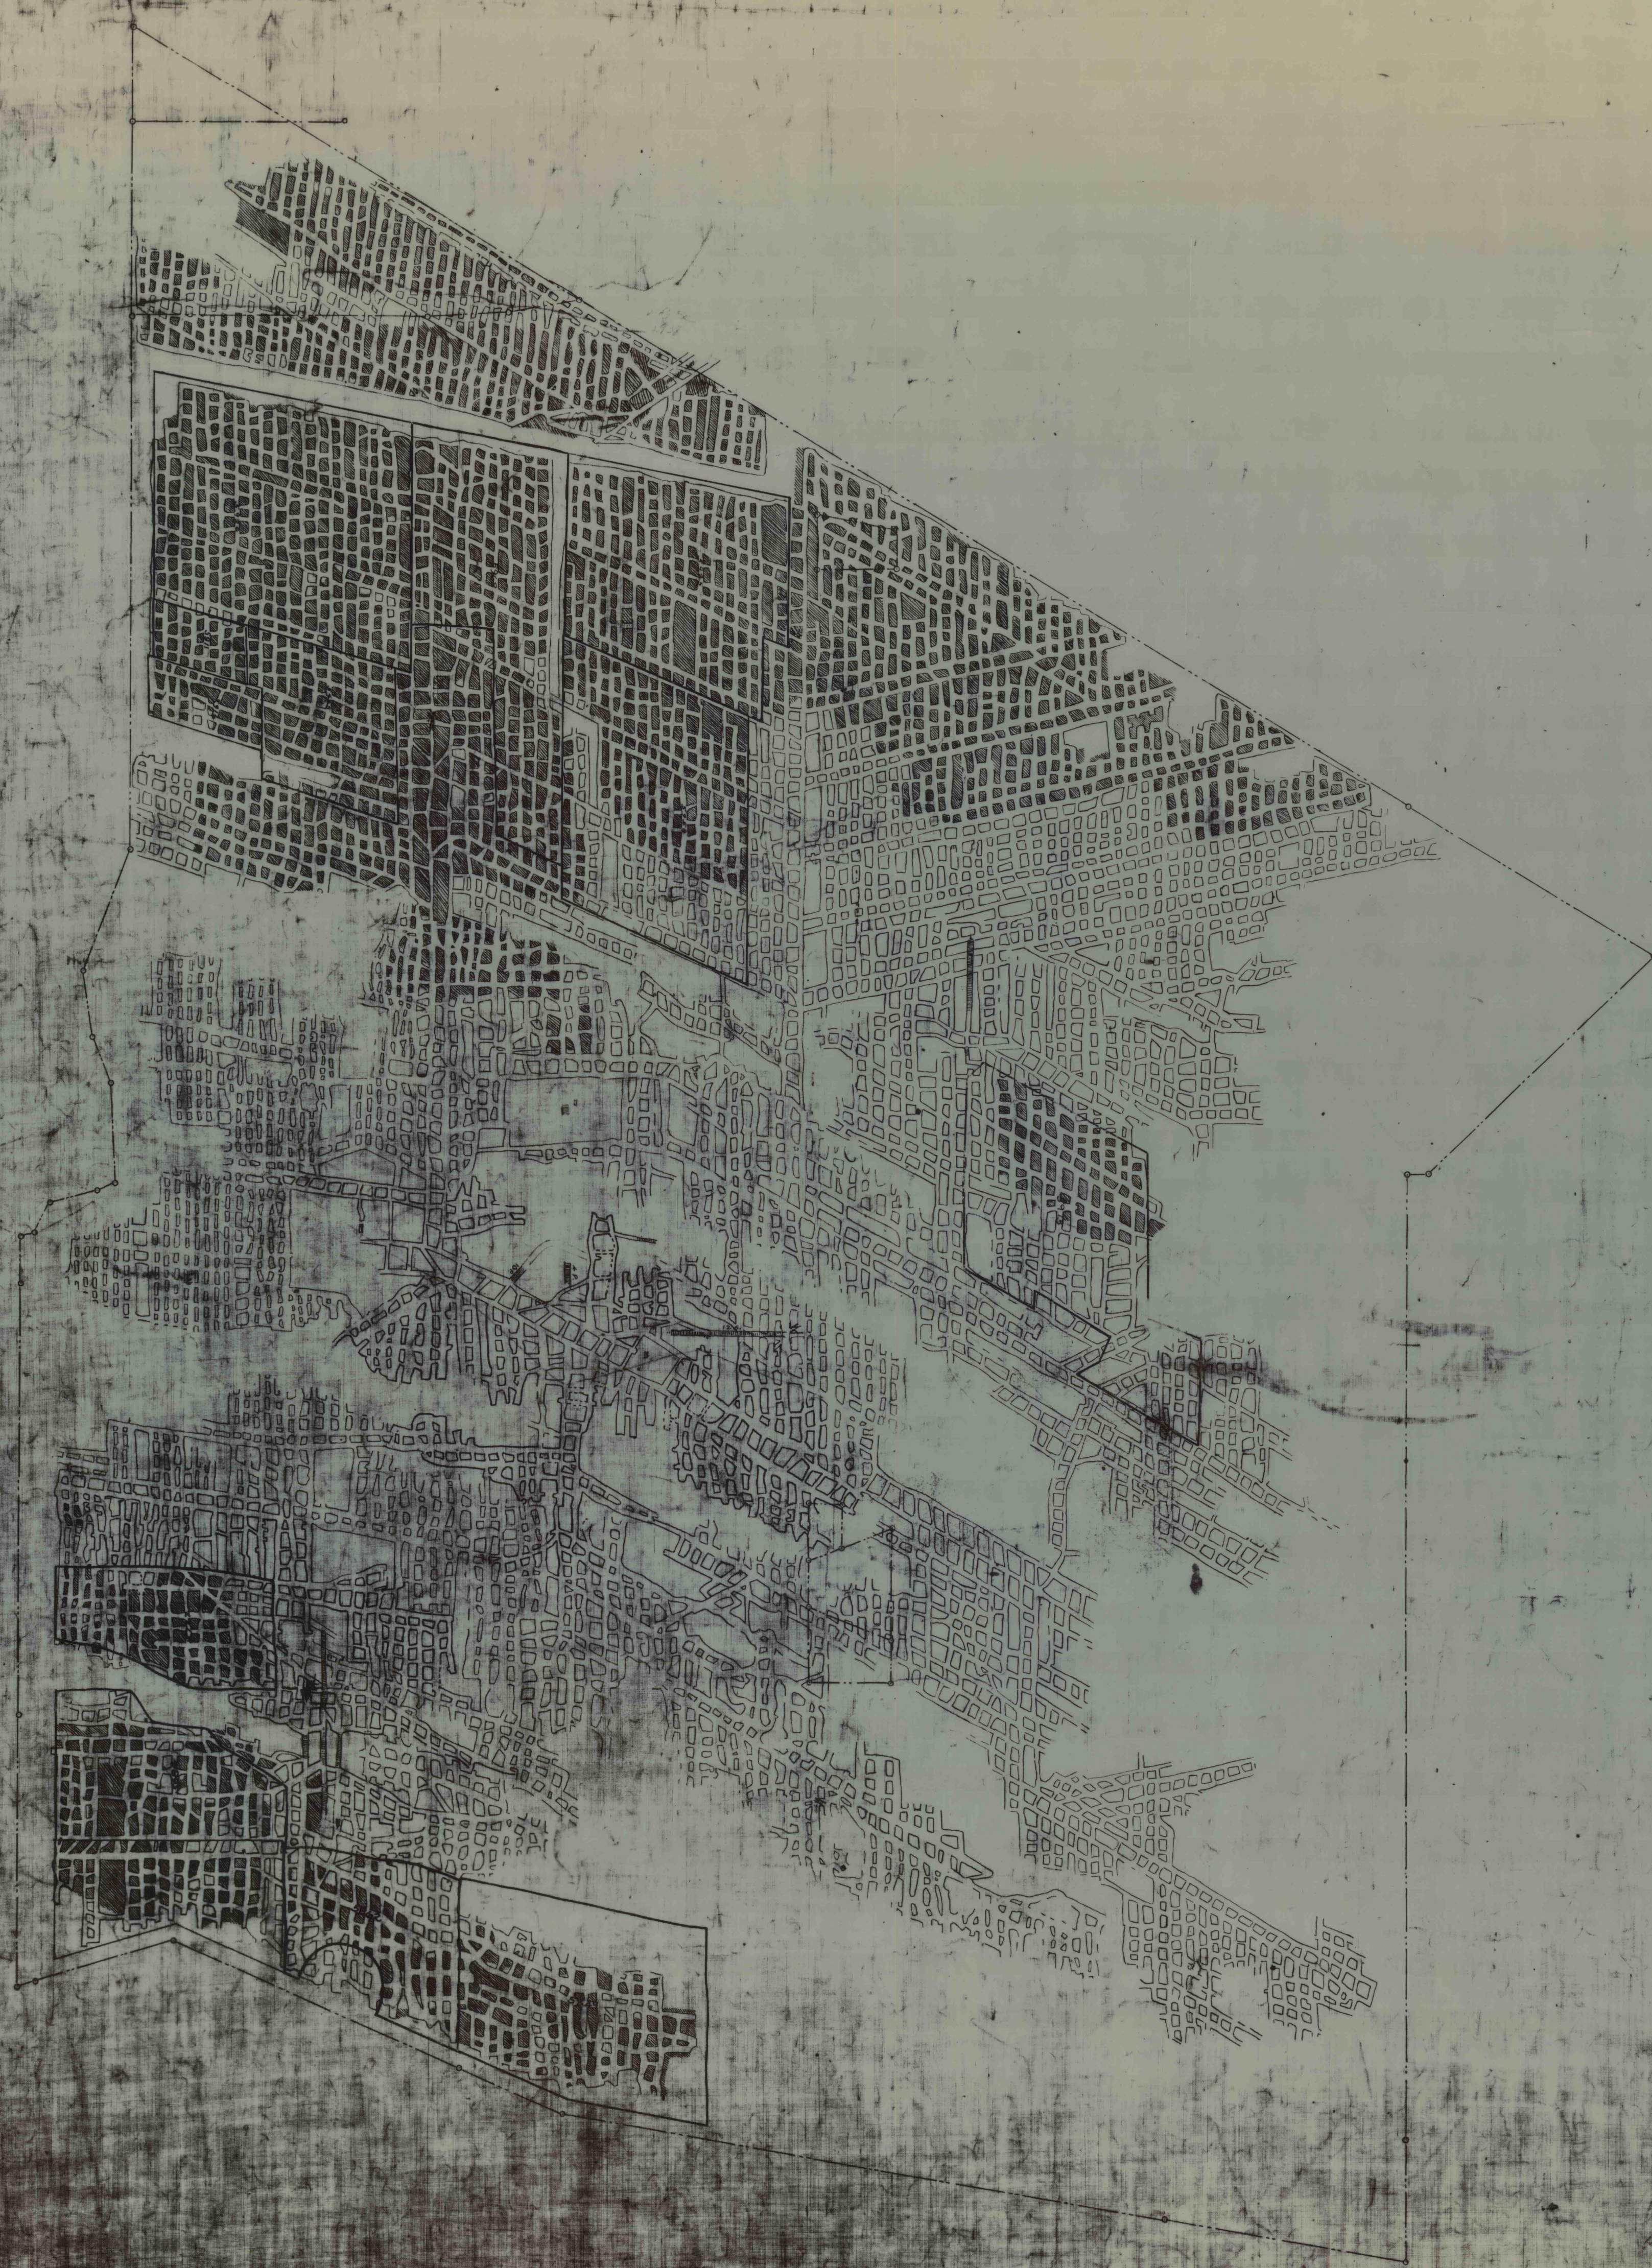

EXTENSION OF MINE WORKINGS
APPLIED HEREON BY []
ON []

CLARK

1451