



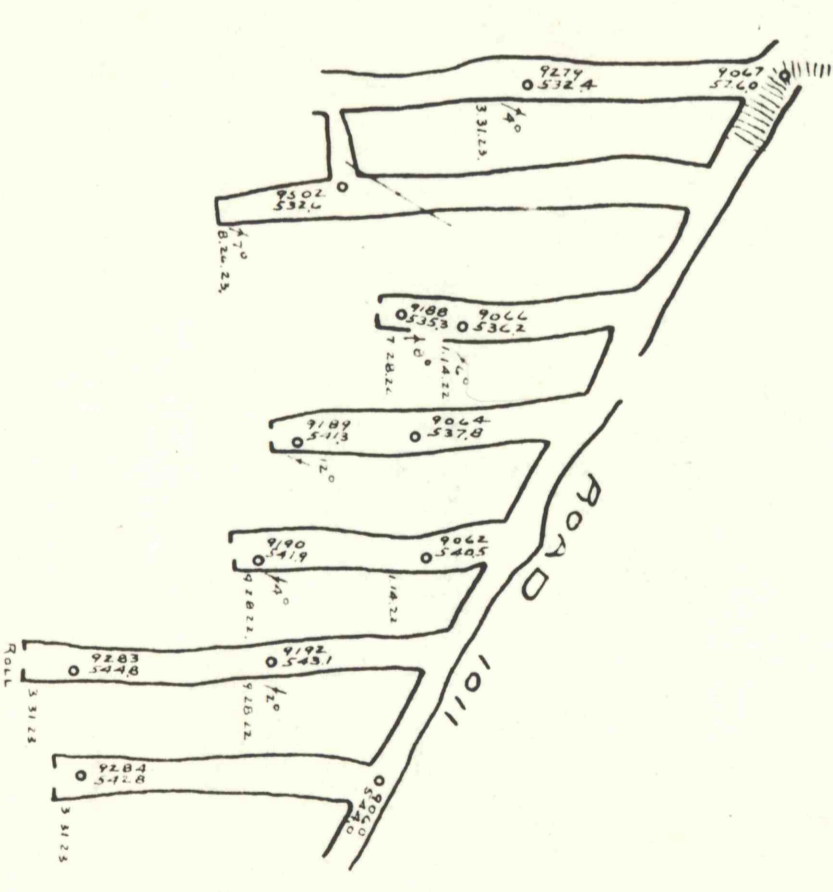

AGREEMENT BANKERS FILLS JULY 23 1941  
FIRST MINING ONLY

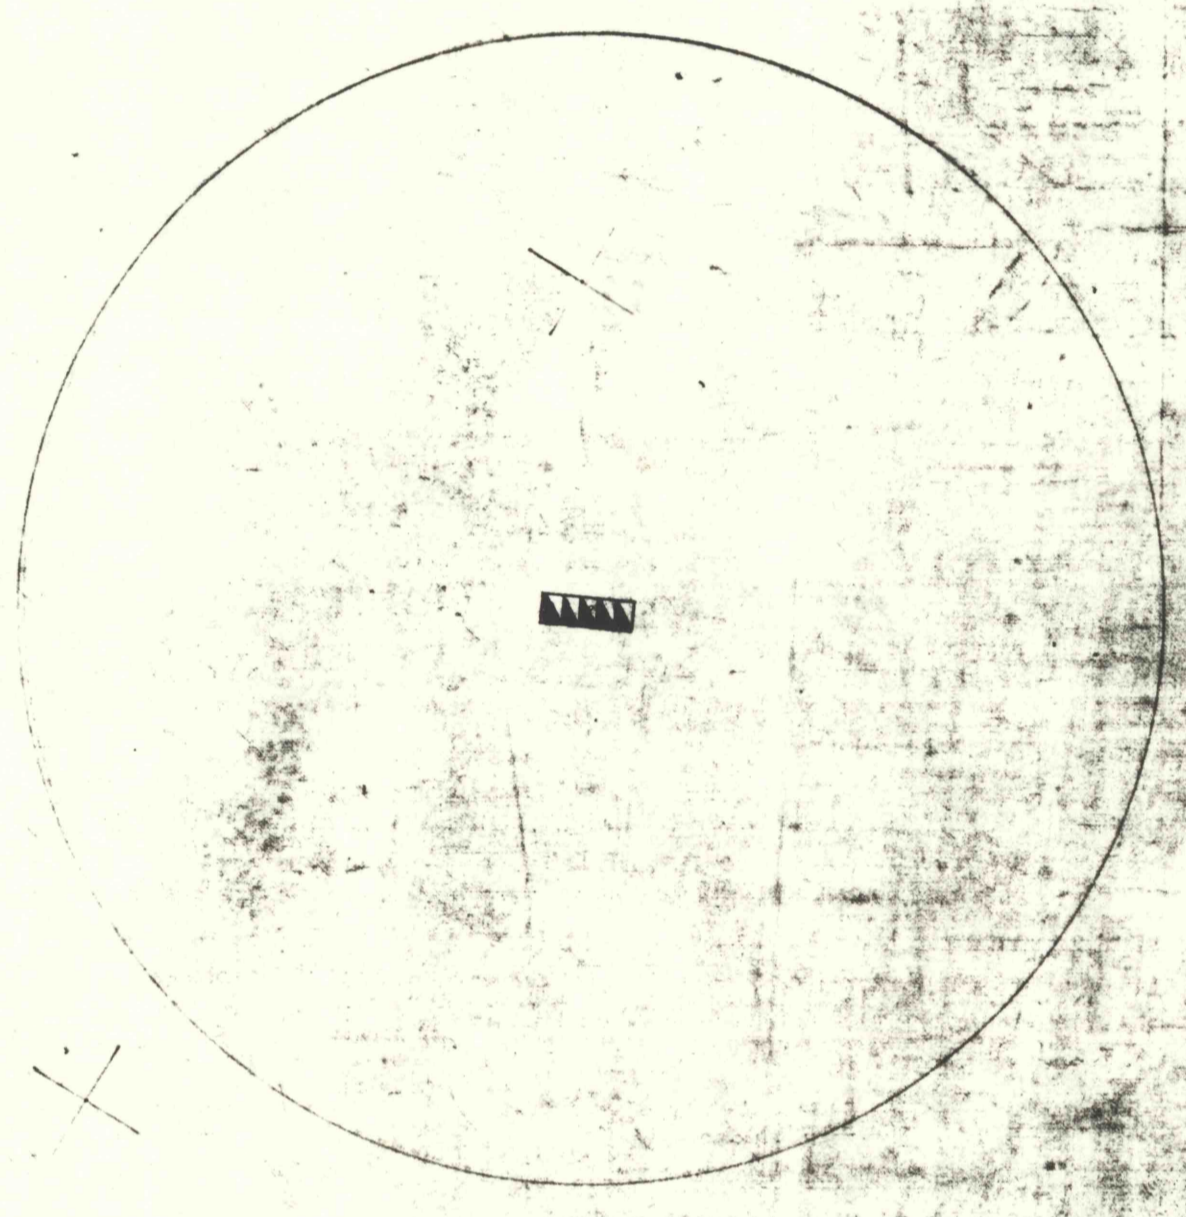

Exeter  
Fifth