


MAP SHOWING  
SURFACE ①  
EXETER COLLIERY-LVC CO.  
REPORT  
WYOMING AREA SCHOOL DISTRICT  
OUTLINED IN RED  
SCALE 1" = 100'  
OCT. 1967

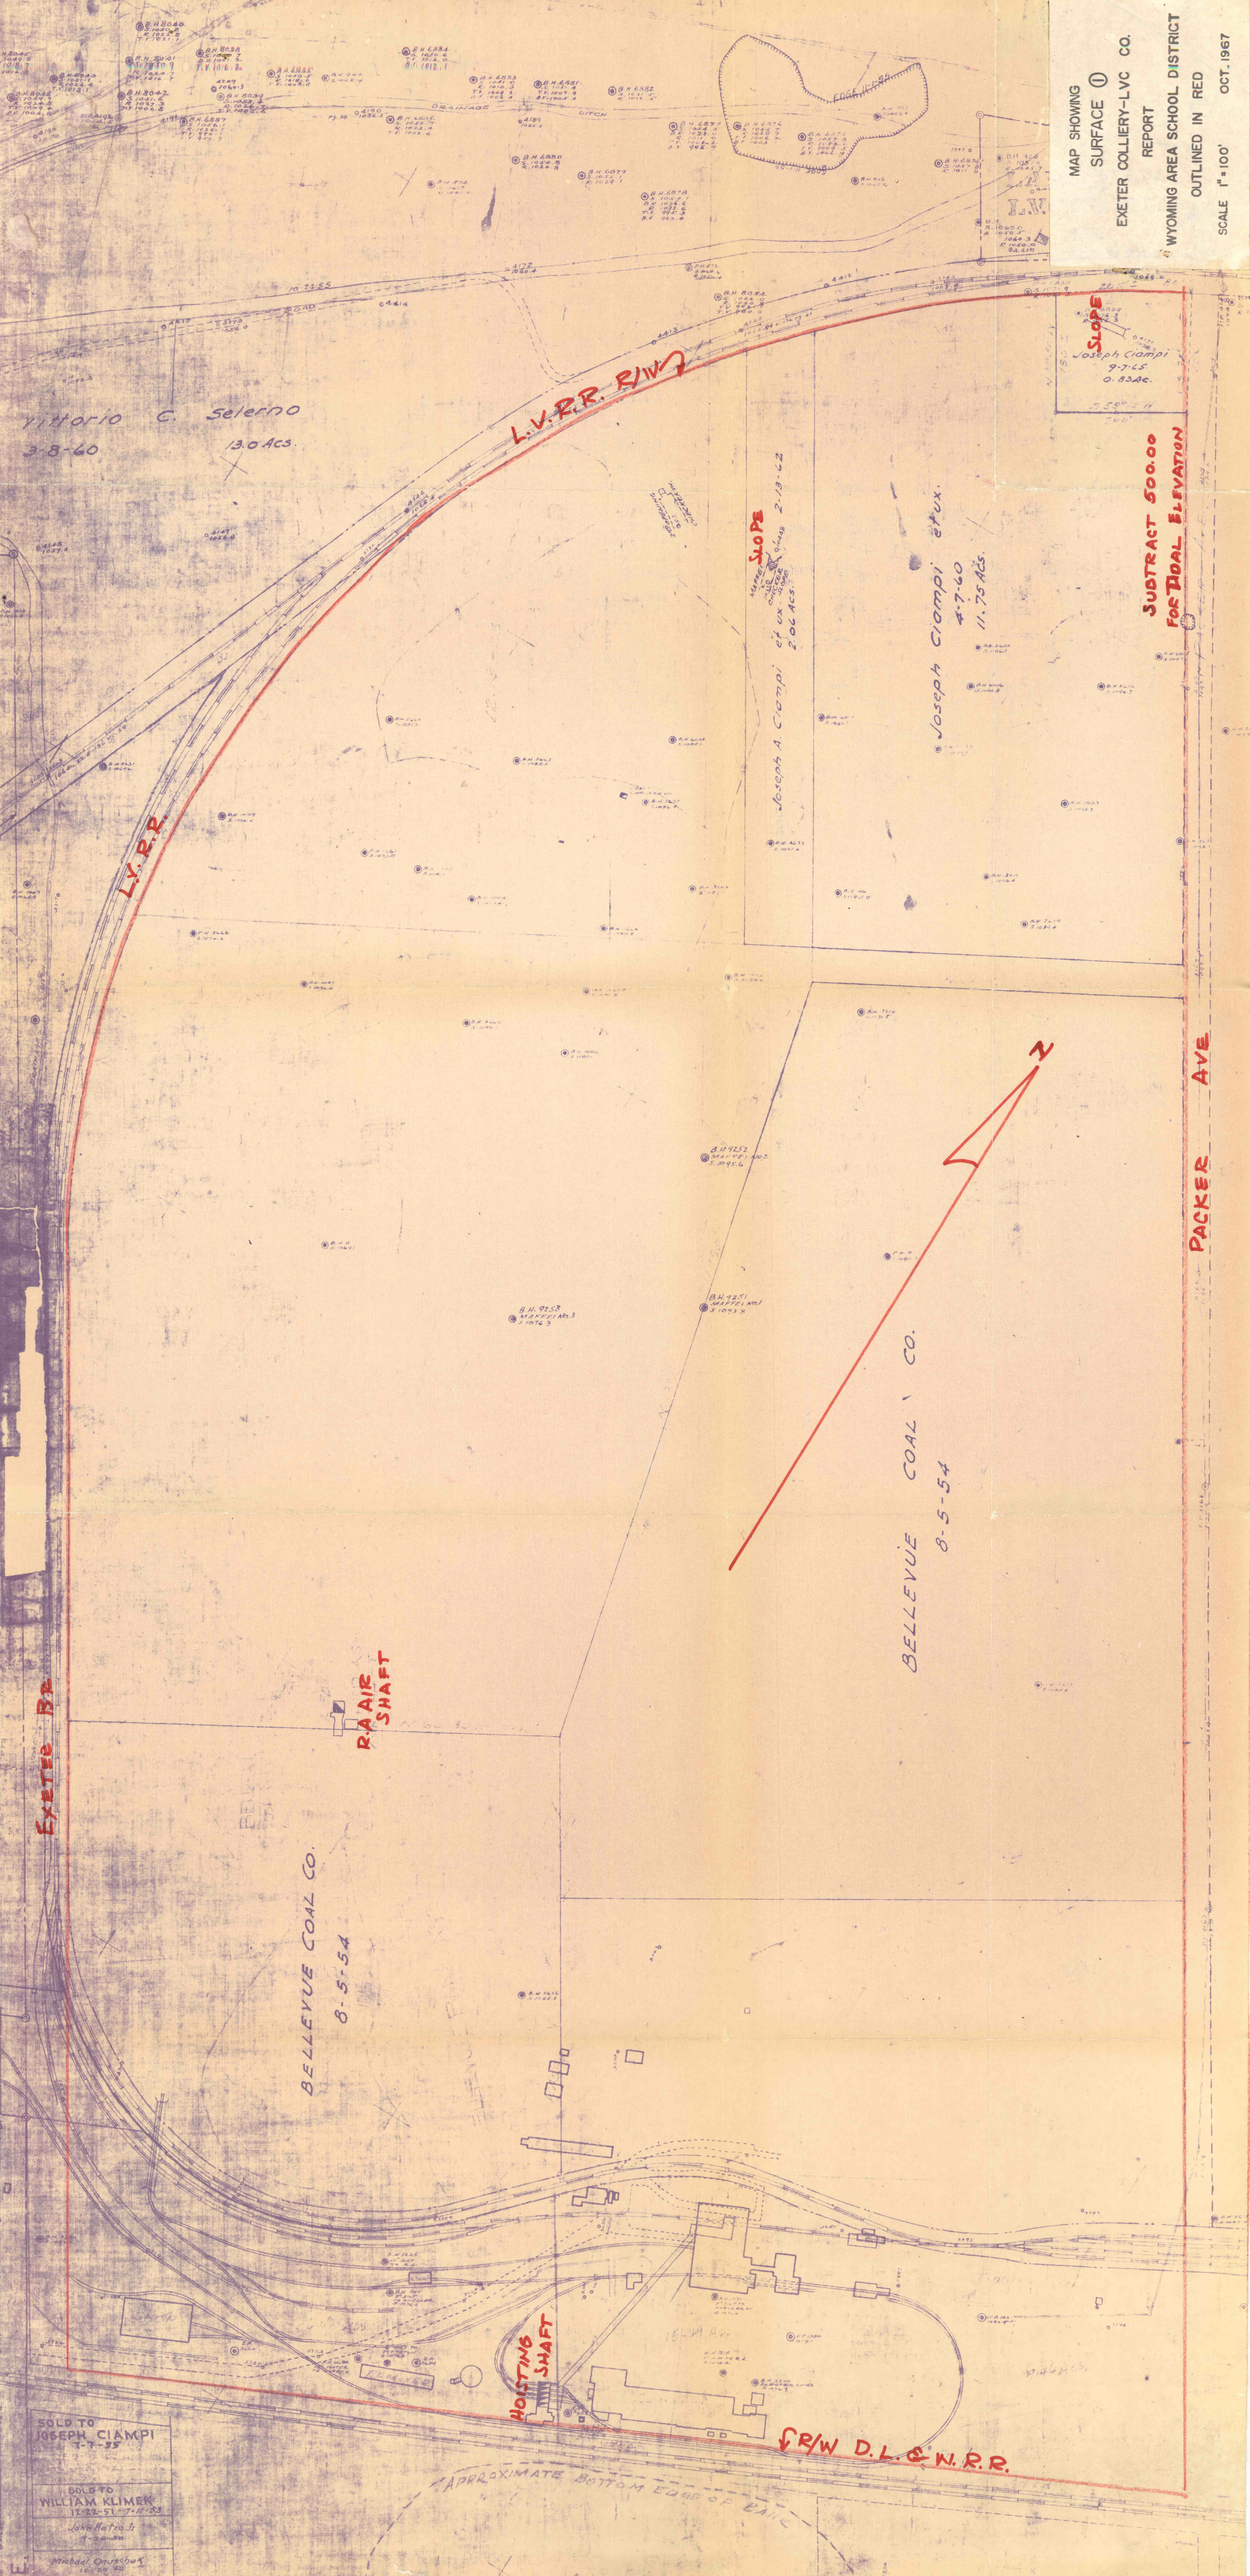

Vittorio C. Selerno  
3-8-60  
13.0 Acs.

L.V.P.R. R/W

SLOPE  
Joseph Ciampi  
9-7-65  
0.82 Acs.

SUBTRACT 500.00  
FOR TIDAL ELEVATION

SLOPE  
Joseph A. Ciampi et ux  
2-13-62  
2.06 Acs.

Joseph Ciampi et ux  
4-7-60  
11.75 Acs.

L.V.P.R.

BELLEVUE COAL CO.  
8-5-54

RAIR  
SHAFT

BELLEVUE COAL CO.  
8-5-54

HOISTING  
SHAFT

R/W D.L. & N.R.R.

APPROXIMATE BOTTOM EDGE OF BAIL

ASH BANK

SOLD TO  
JOSEPH CIAMPI  
7-7-55

SOLD TO  
WILLIAM KLIMEK  
12-22-51 - 7-17-53

John H. Trejo Jr.  
7-24-50

Michael Oruschoff  
10-20-50

Michael A. Quack