


BH<sup>s</sup> 9-12

PENNA. COAL CO. LANDS  
Part of Lilla  
Pittston, Pa.  
DB 1922 P 404  
Doris Frazer  
Lilla  
Avoca Pa.  
DB 1923 P 275  
Lilla  
Avoca Pa.  
DB 1923 P 275  
Poppa Brothers  
205 Lippi Building  
Pittston, Pa.  
DB 1988 P 676  
DB 2016 P 667

170.00  
85.00  
100.00  
85.00  
60.00  
75.00  
240.00  
795.00  
940.00  
795.00  
145.00

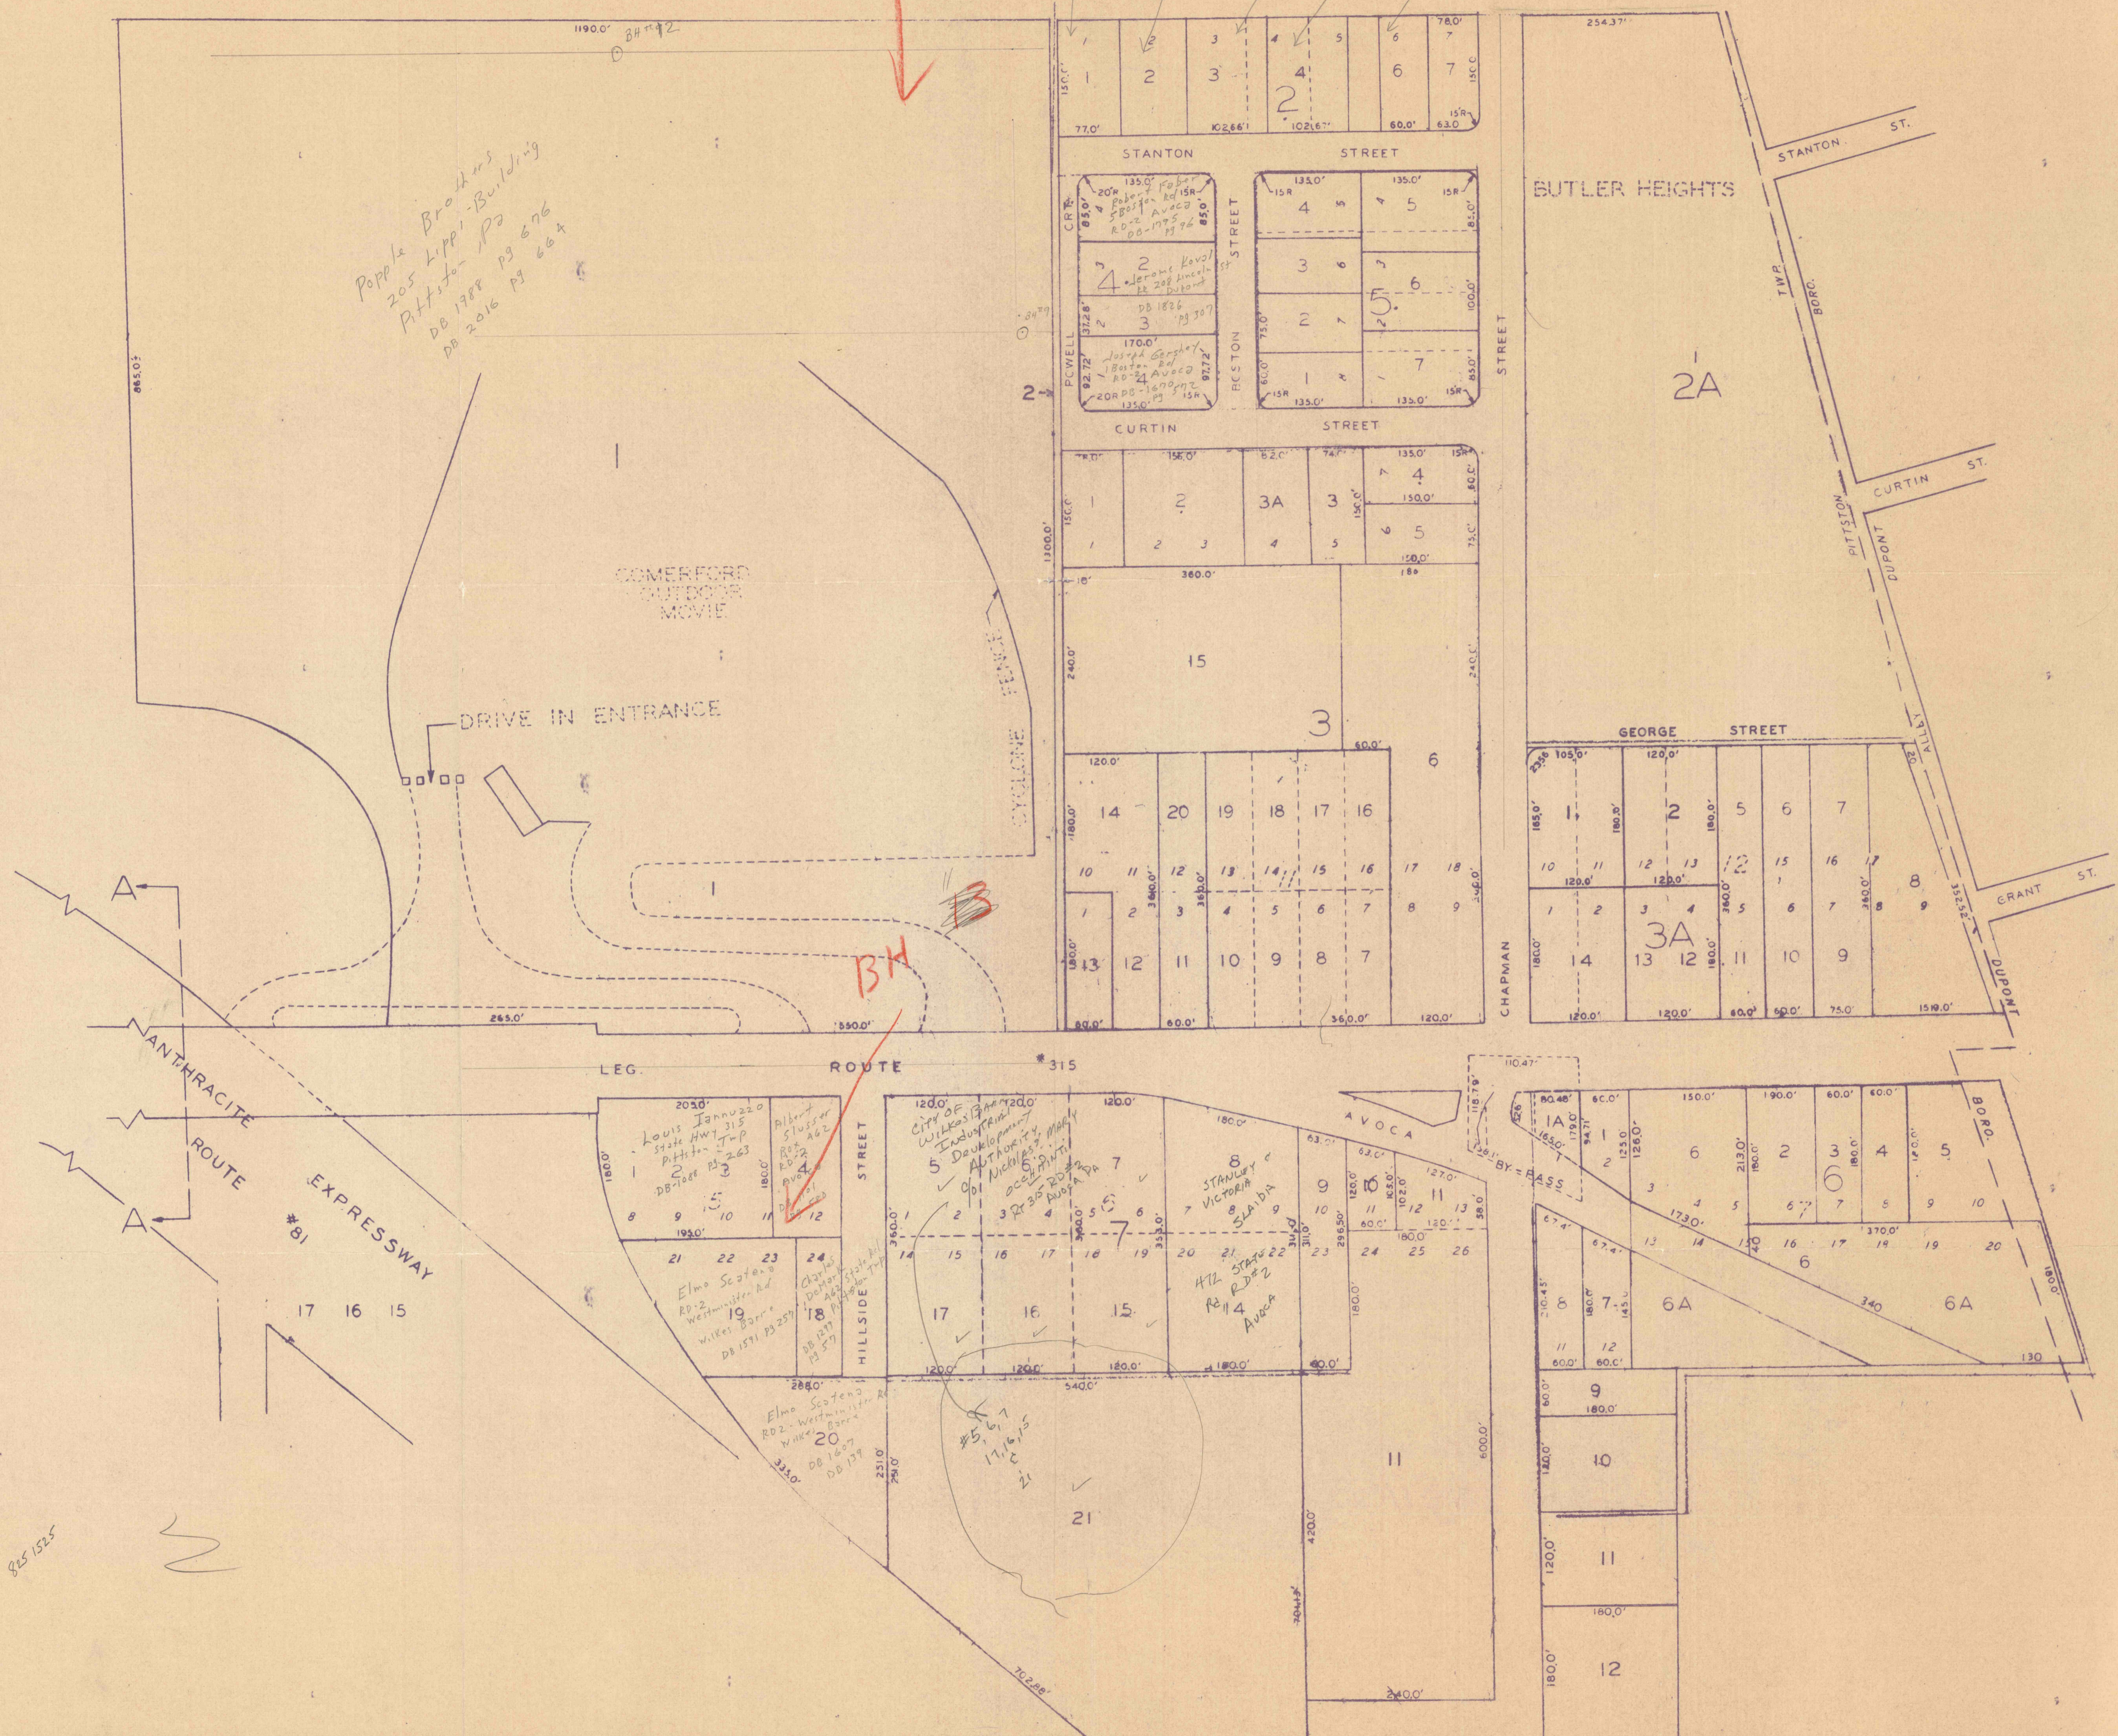

THIS MAP PREPARED FOR ASSESSMENT PURPOSES ONLY, AND IS NOT DESIGNED TO PROVIDE ENGINEERING DATA.

