


THIS MAP PREPARED FOR ASSESSMENT PURPOSES ONLY AND IS NOT DESIGNED TO PROVIDE ENGINEERING DATA.

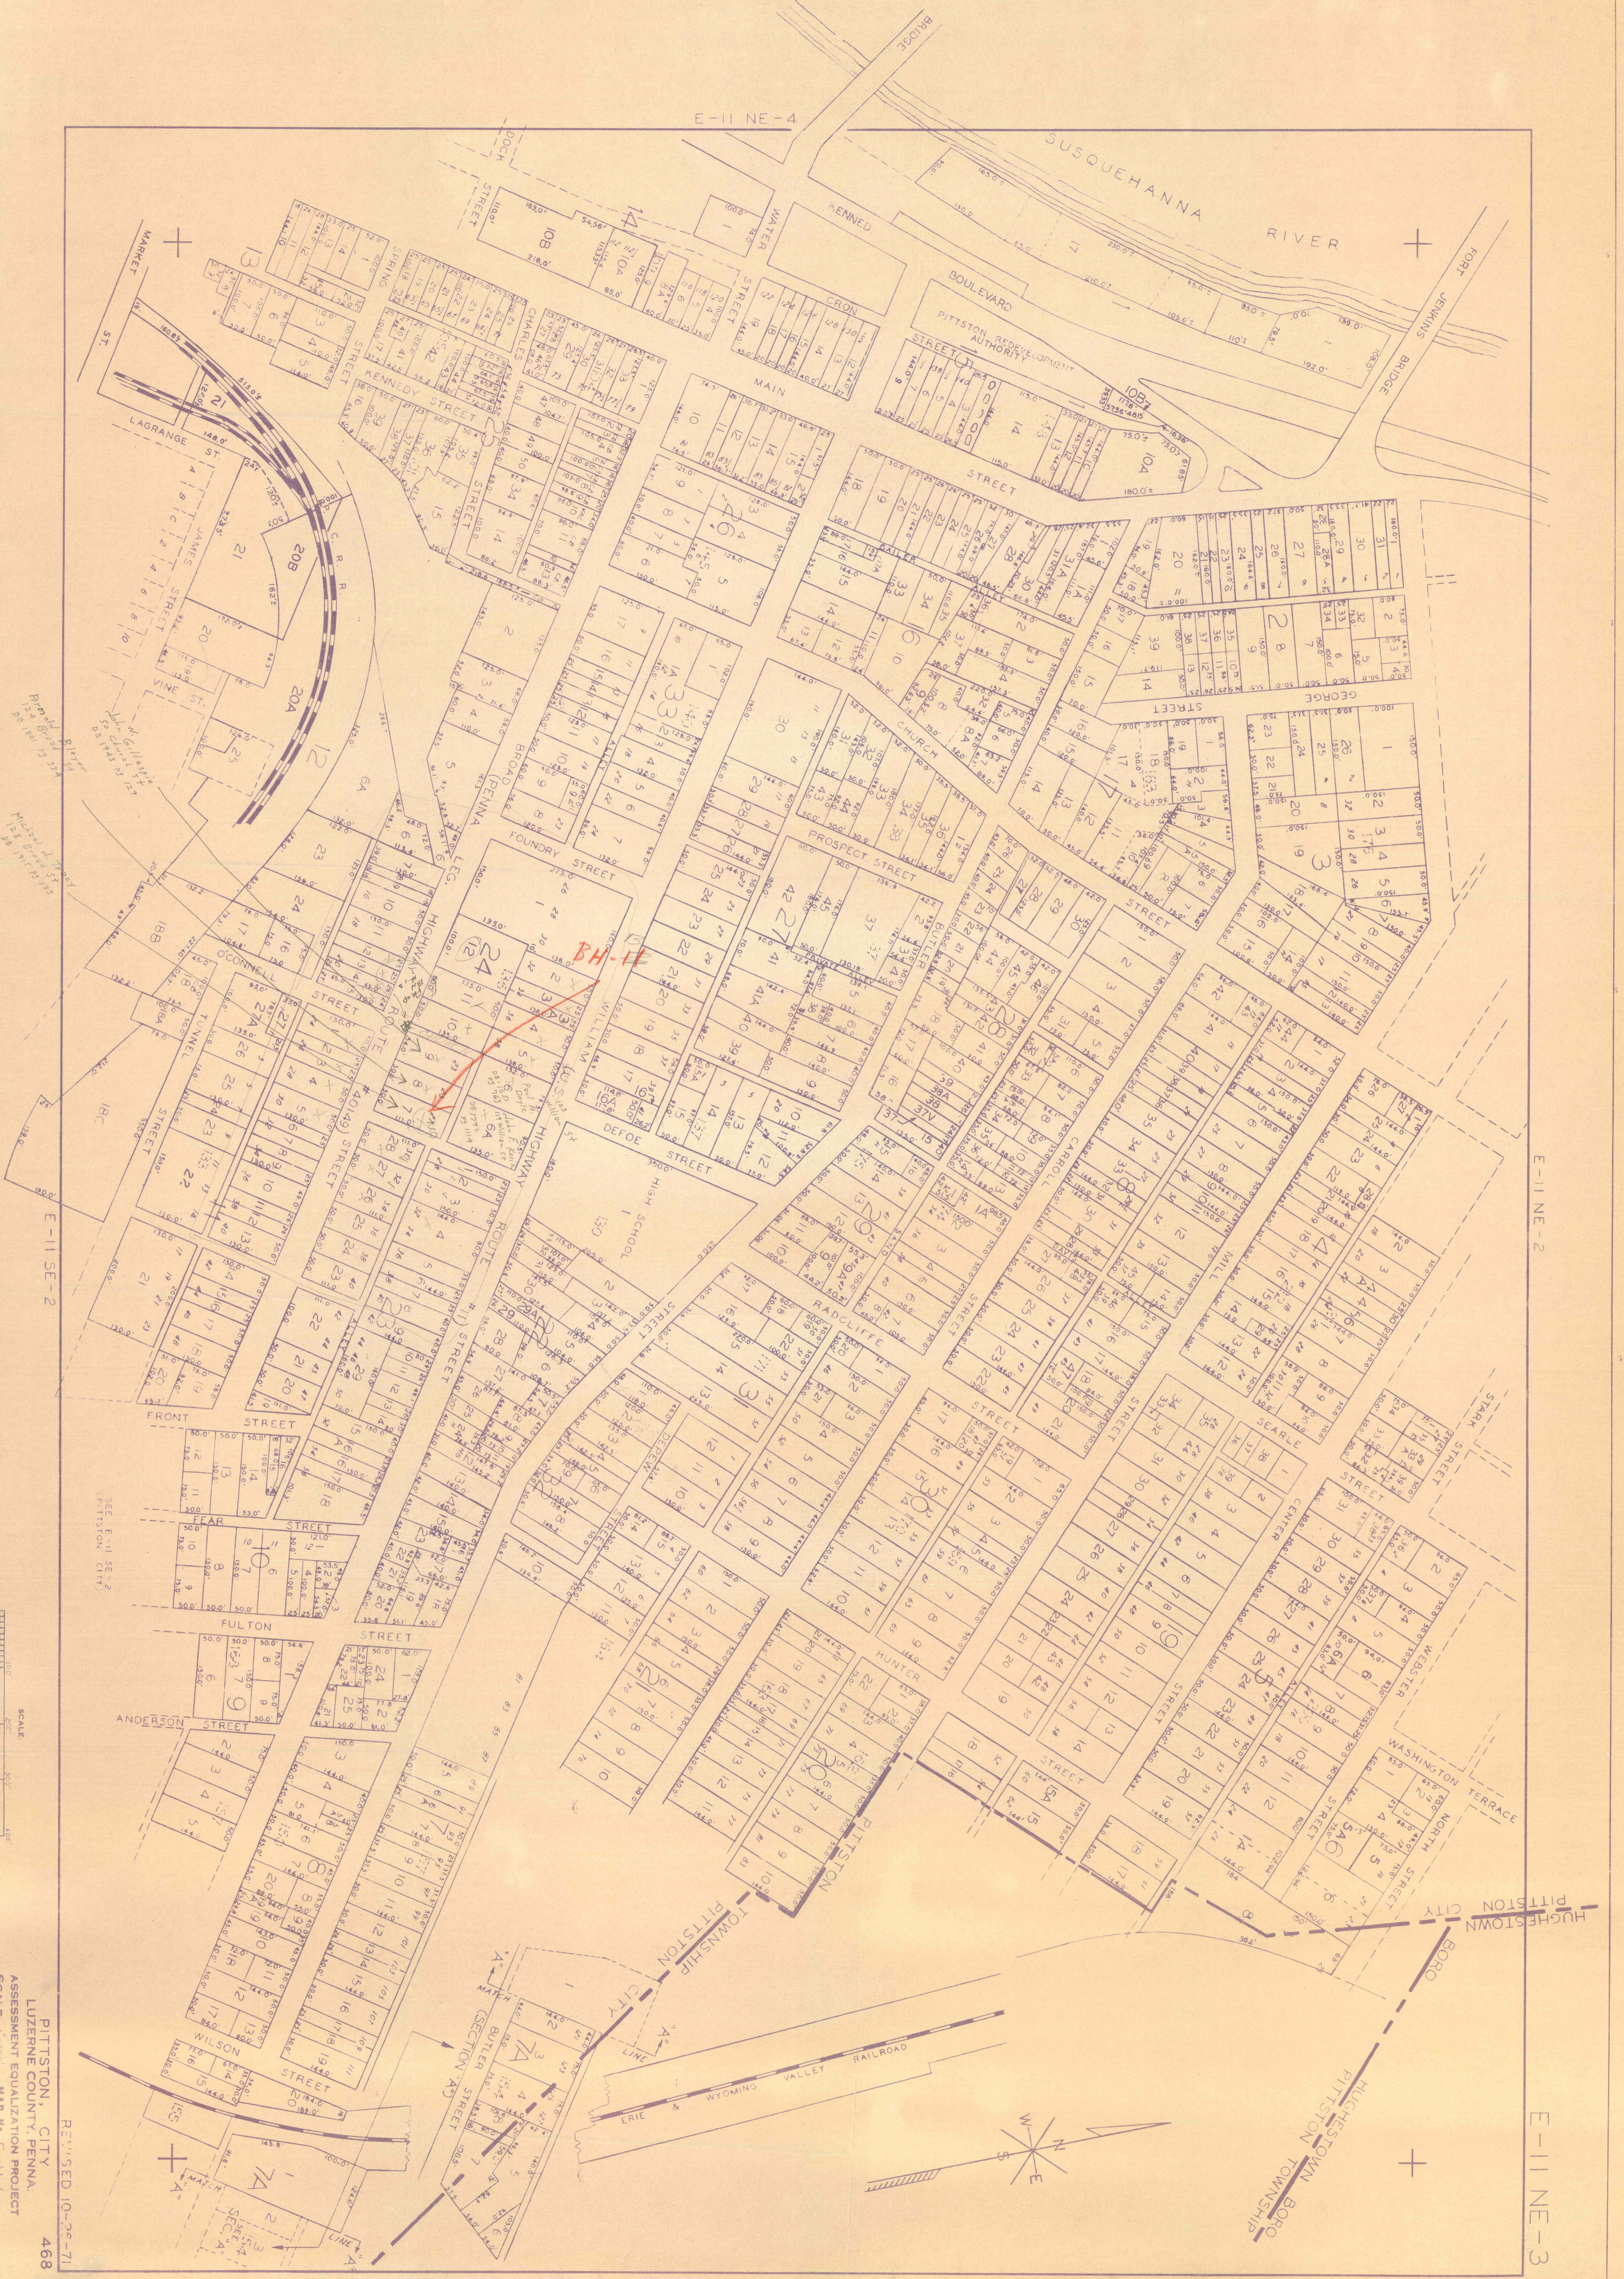

E-11 NE-4

E-11 NE-2

E-11 NE-3

SCALE
1" = 100'

LUZERNE COUNTY, PENNA.
ASSESSMENT EQUALIZATION PROJECT
SCALE 1" = 100'
MAP NO. E-11/NE-3
REVISED 10-26-71
468