
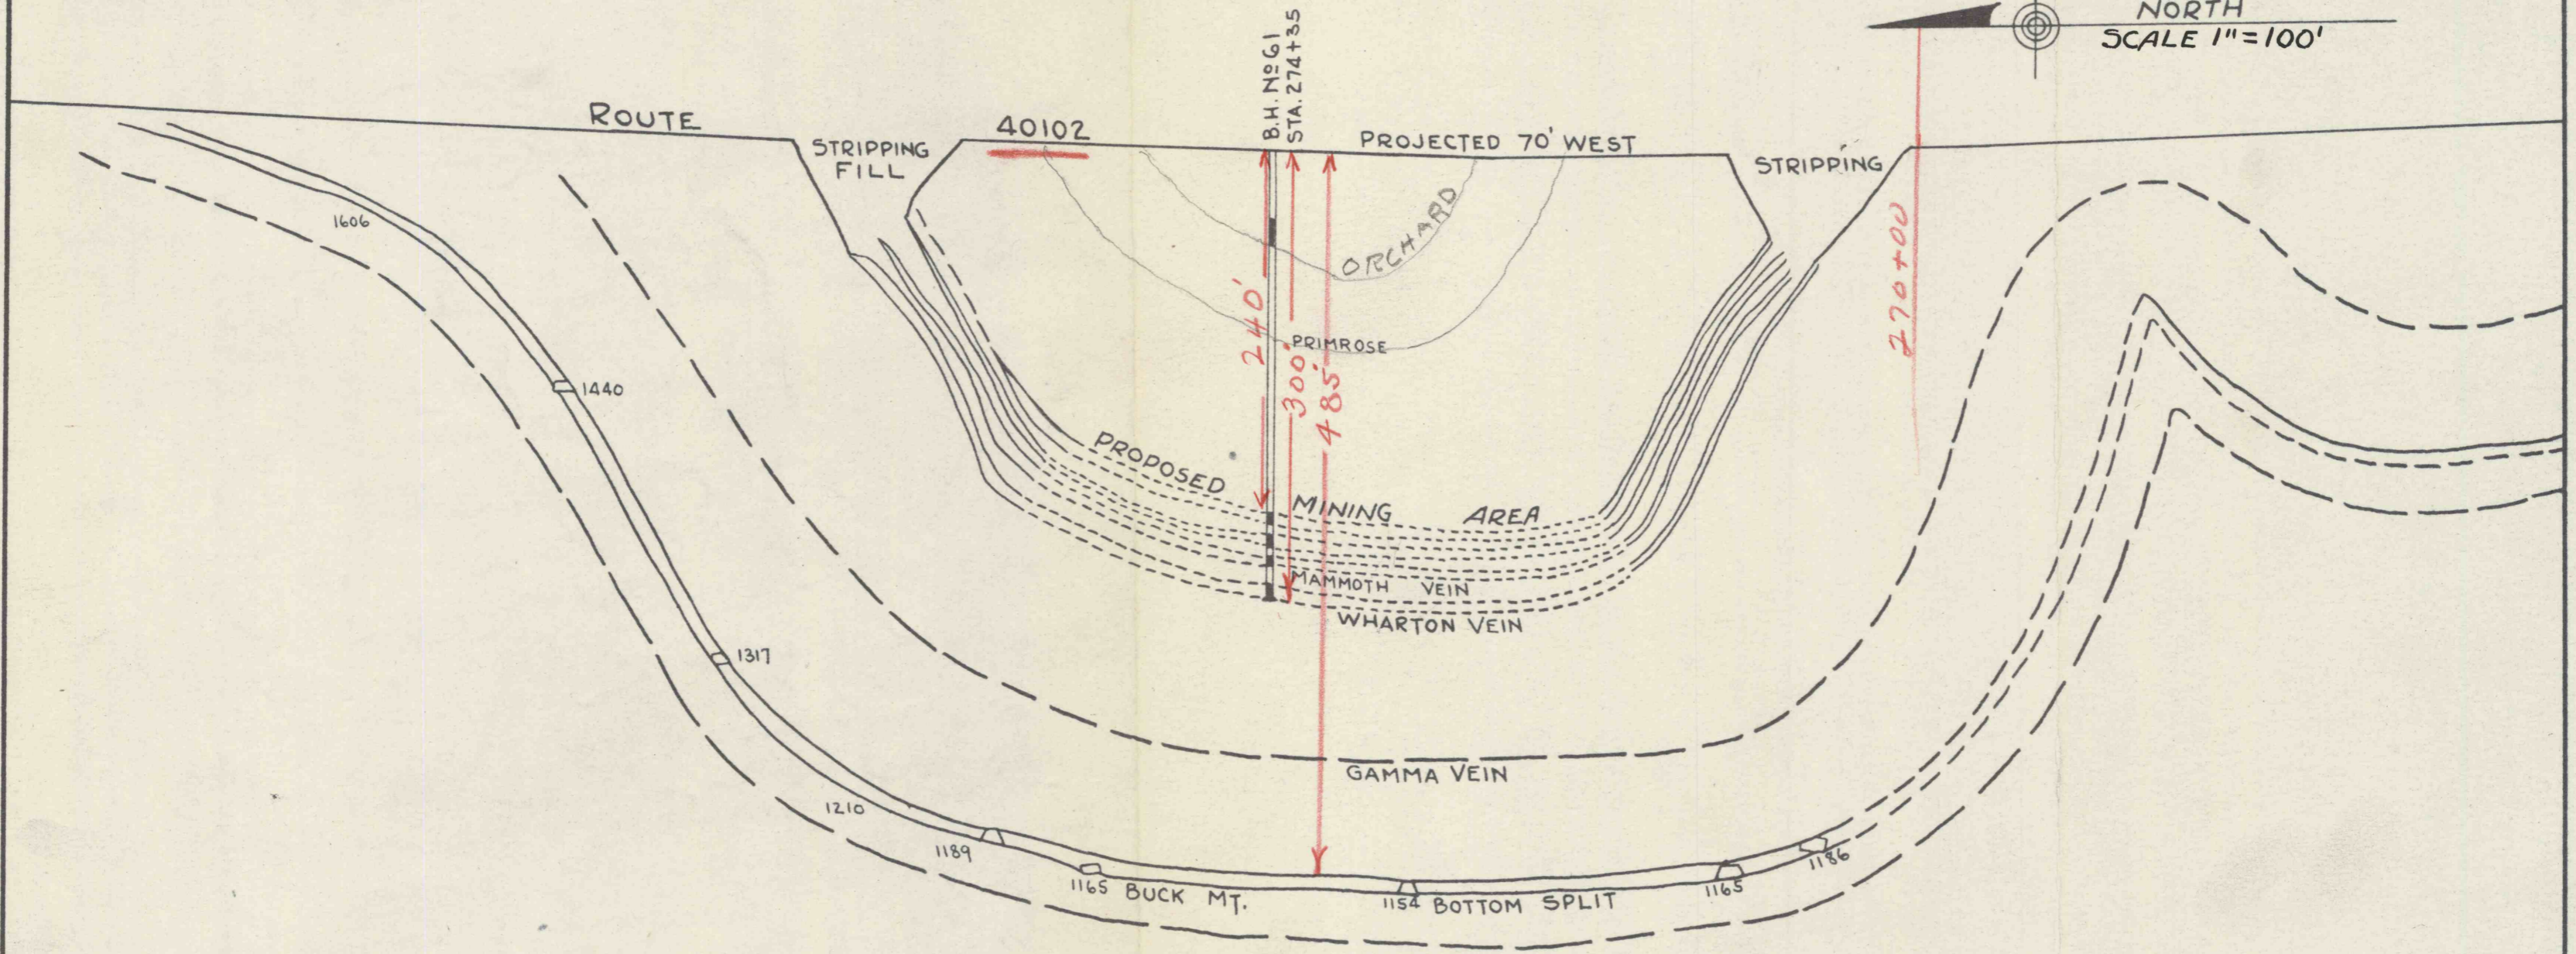


DRIFTON

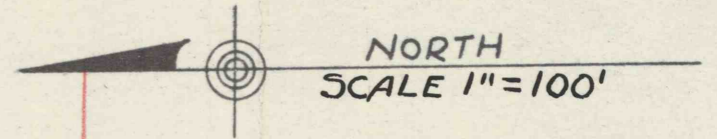

SECTION LINE NO 11 JEDDO-HIGHLAND COAL CO., LESSEE COXE ESTATE, LESSOR