
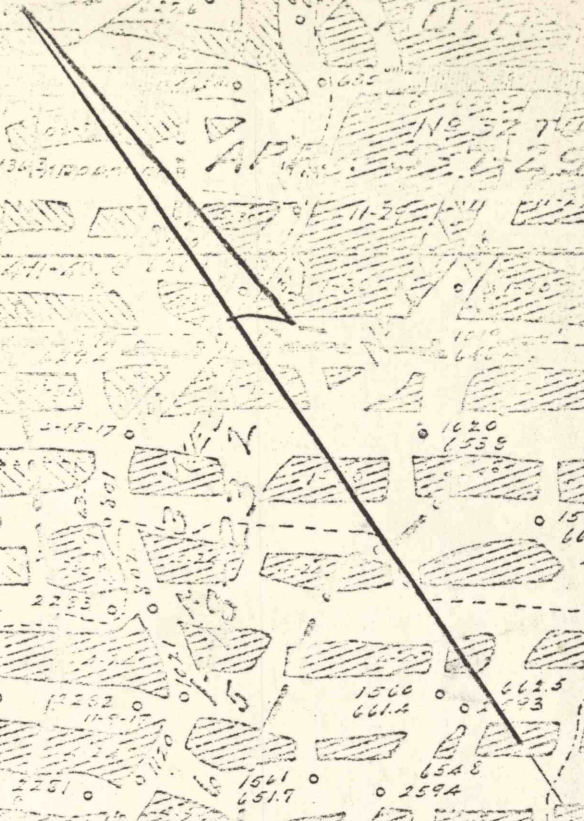


P-11-40

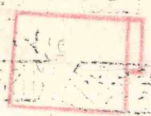

D.O.H. # 22145  
Sur. Pt. 736.9  
Bed El. 670.2

AUTH.

DELAWARE Coll'y  
CHECKER VEIN  
1" = 100'