

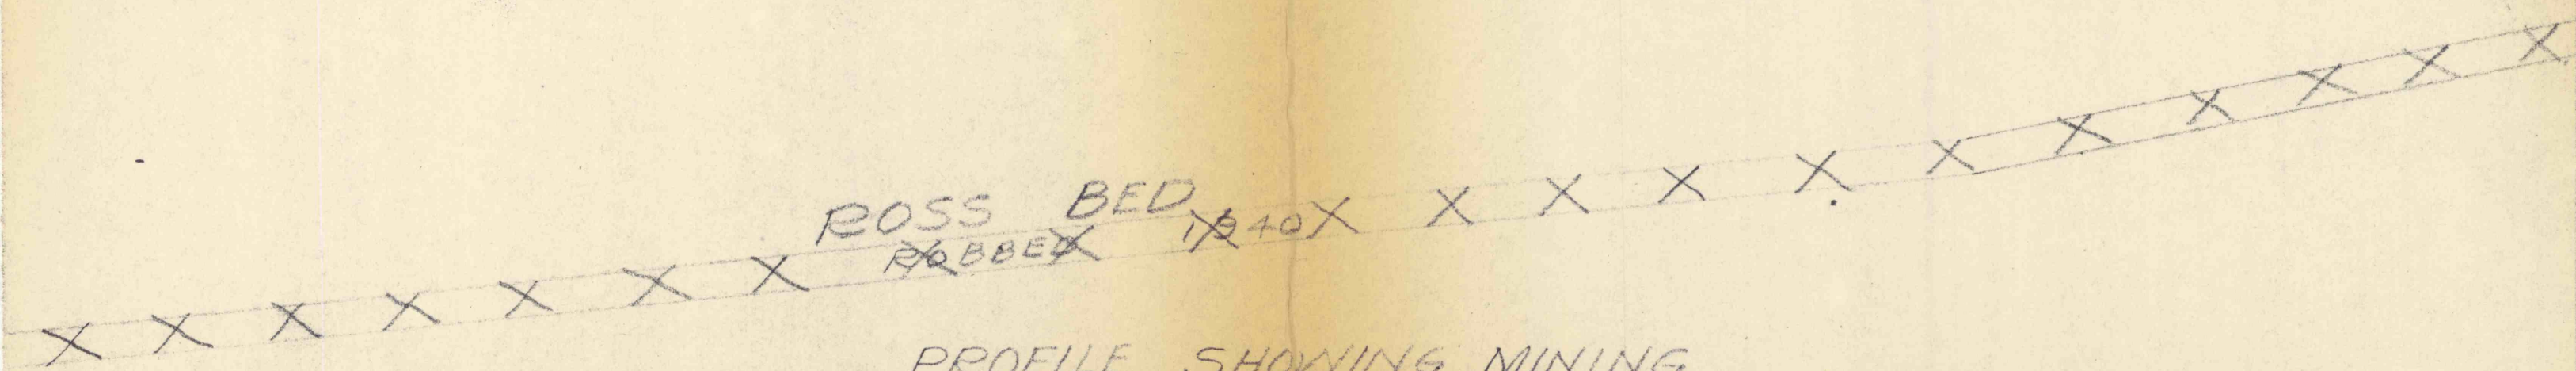


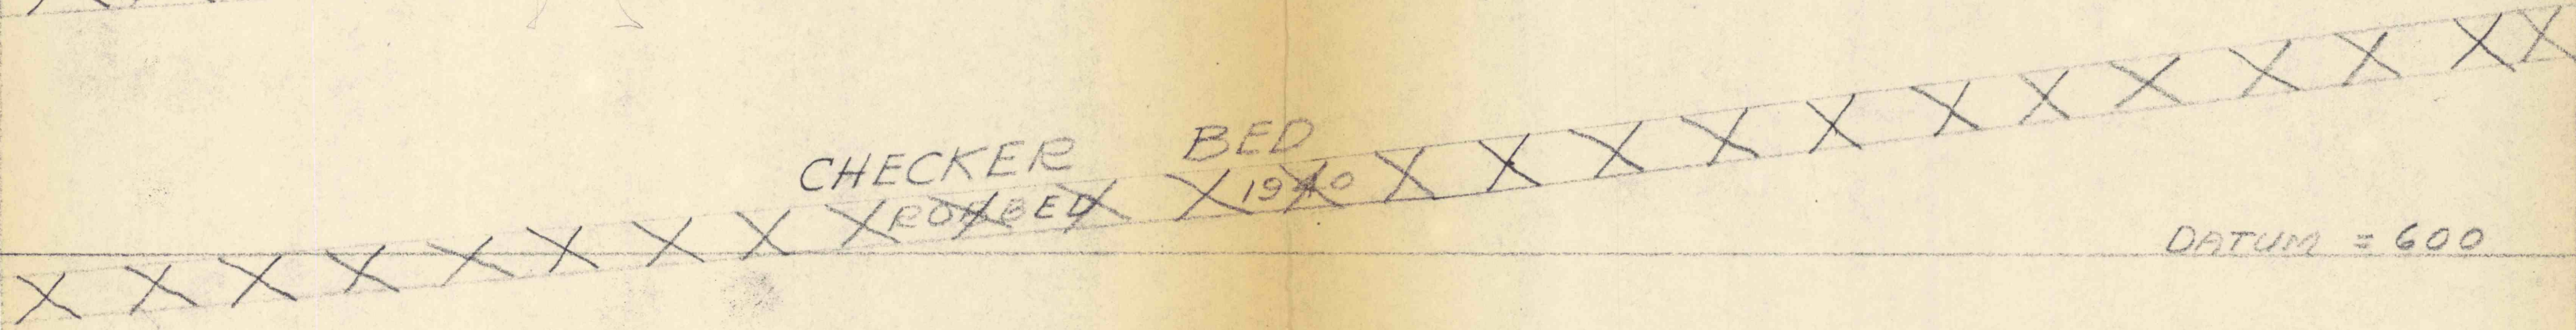

R/W LINE

L.R. 315

R/W LINE

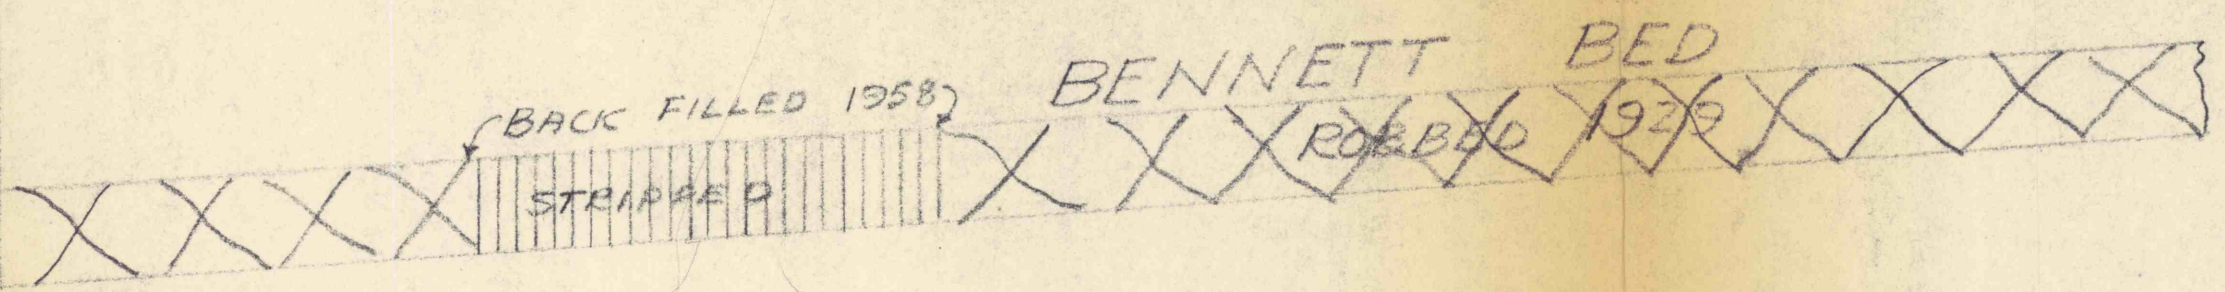

LEGEND
 [Vertical Hatching] STRIPPING
 [Diagonal Hatching] EXHAUSTED

PROFILE SHOWING MINING
CONDITION UNDERLYING
COLOR STUDIO INC.
SACLE HOR } 1" = 20'
VER }