


4

ROUTE

#515

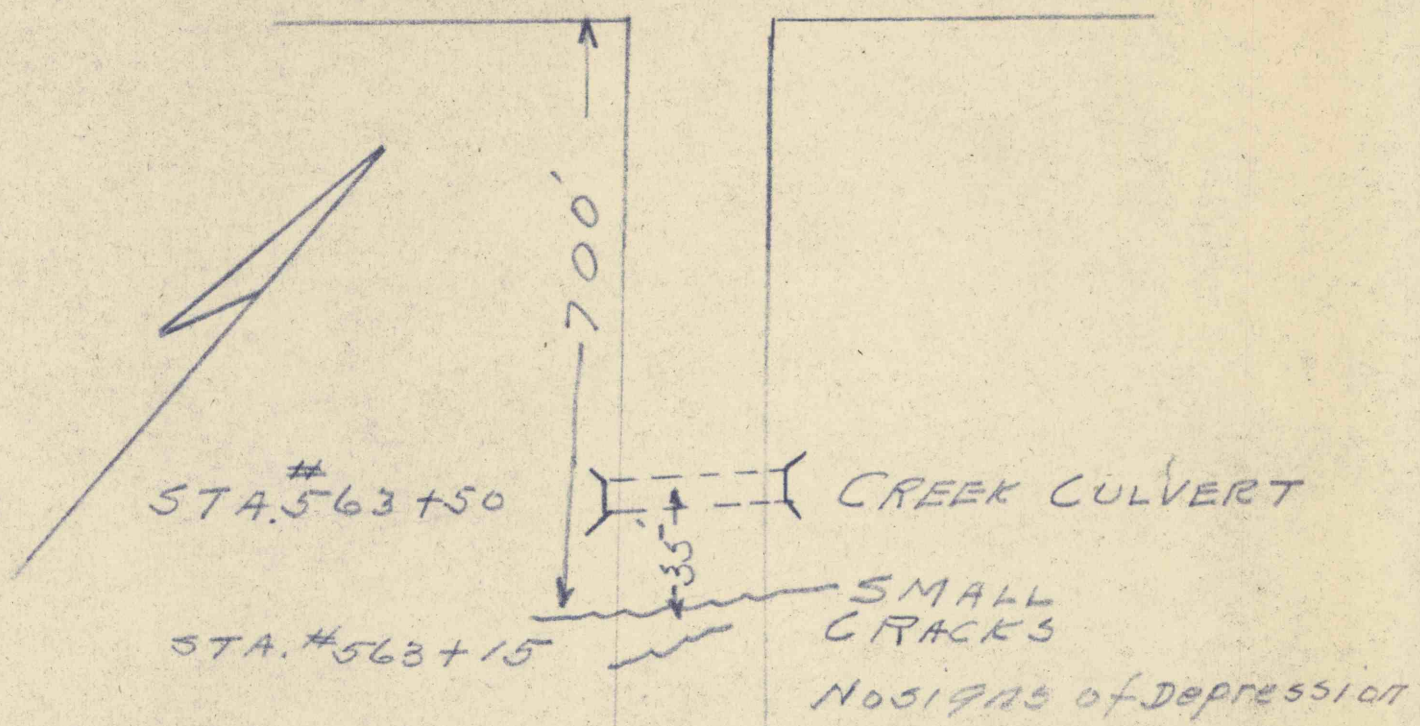

AUGUST 13, 1947

ROUTE #665

STA. 563+15

DUPONT BORO.

LUZ. COUNTY

REY