

AVE.


HOUSE  
No 798



"POT HOLE" 12'X10'X21'DEEP

STA. 11+00±

150'±

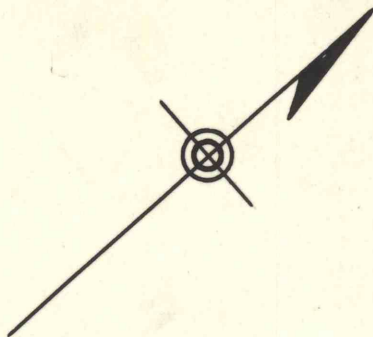

PERRY

ST.

NORTH

SUBSIDENCE:- DEC. 19, 1947

ROSS VEIN

RAUB & FULLER TRACT

LUZERNE BOROUGH

LUZERNE COUNTY

SKETCH - DO NOT SCALE

12-19-47 5.