


Stephens Tract
Parcel-A-

Blakely Boro.

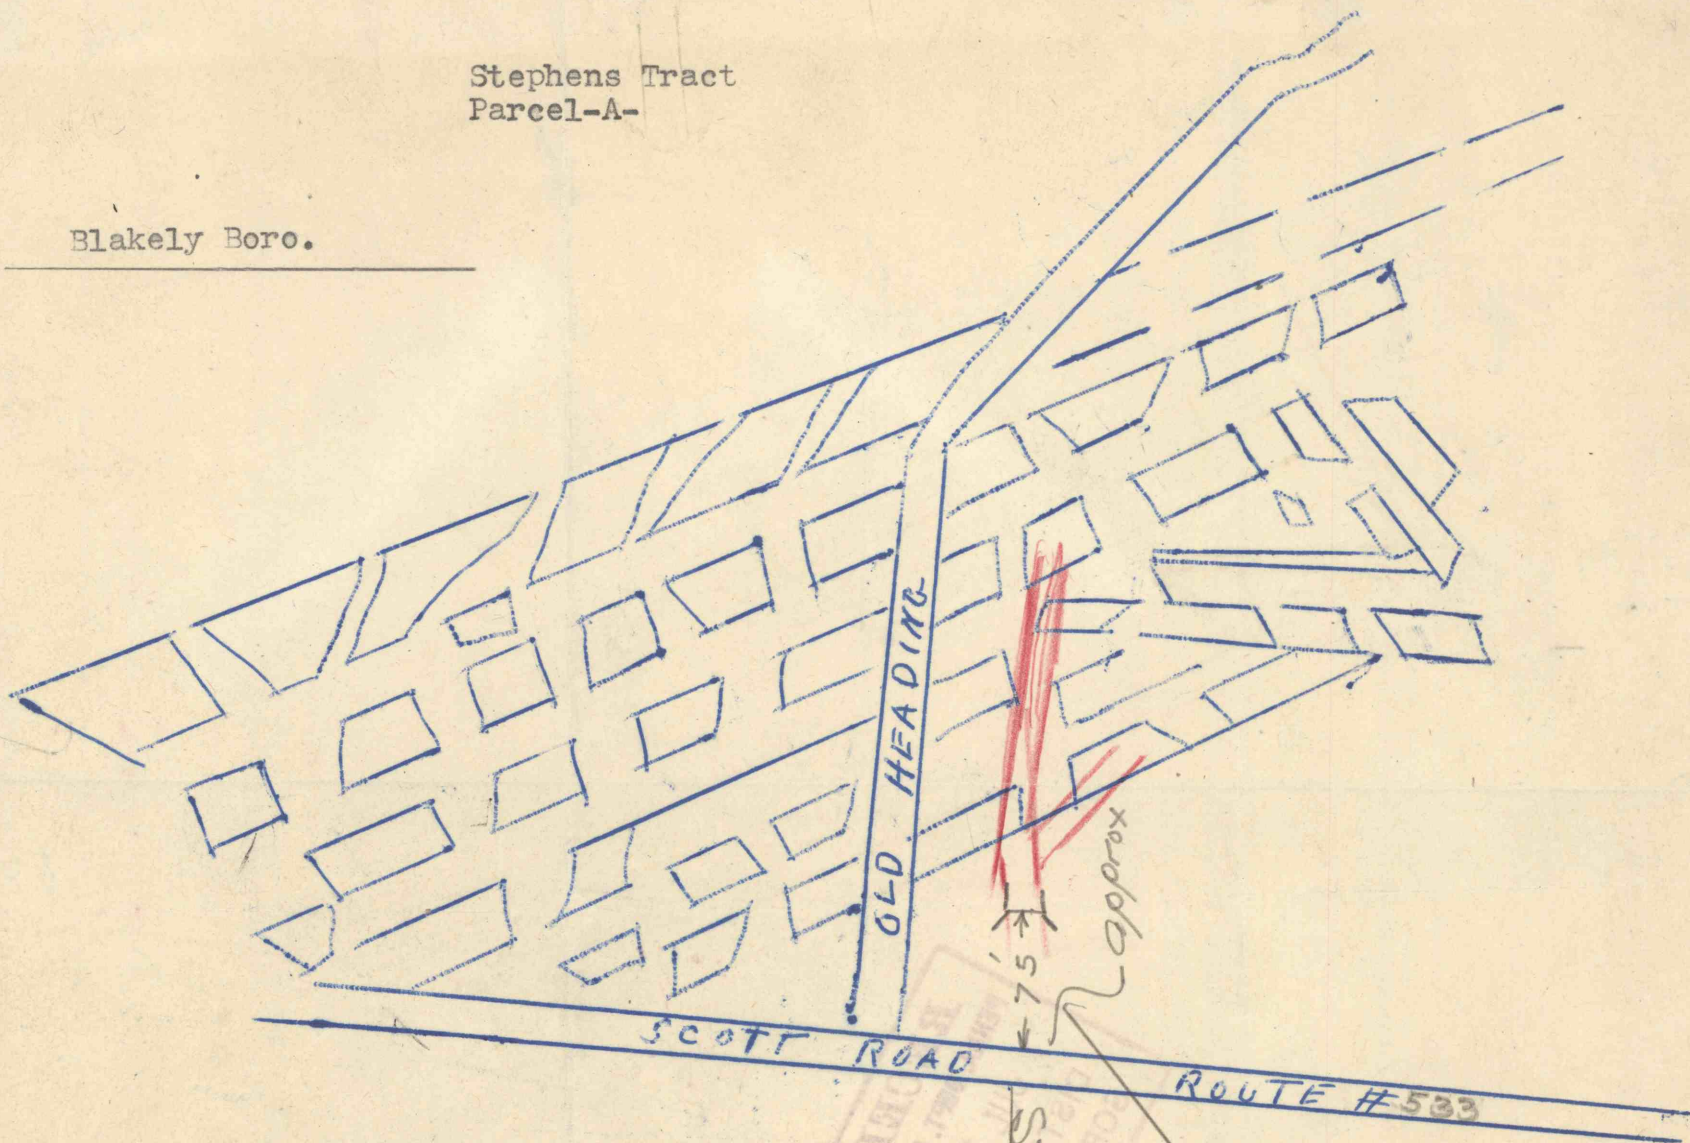

Traced from original map
Proposed mining in red

Scale 100 to the inch

Rec'd 7-15-49

ANDREW Piccioli
124 Broad Street
Beckville, Pa