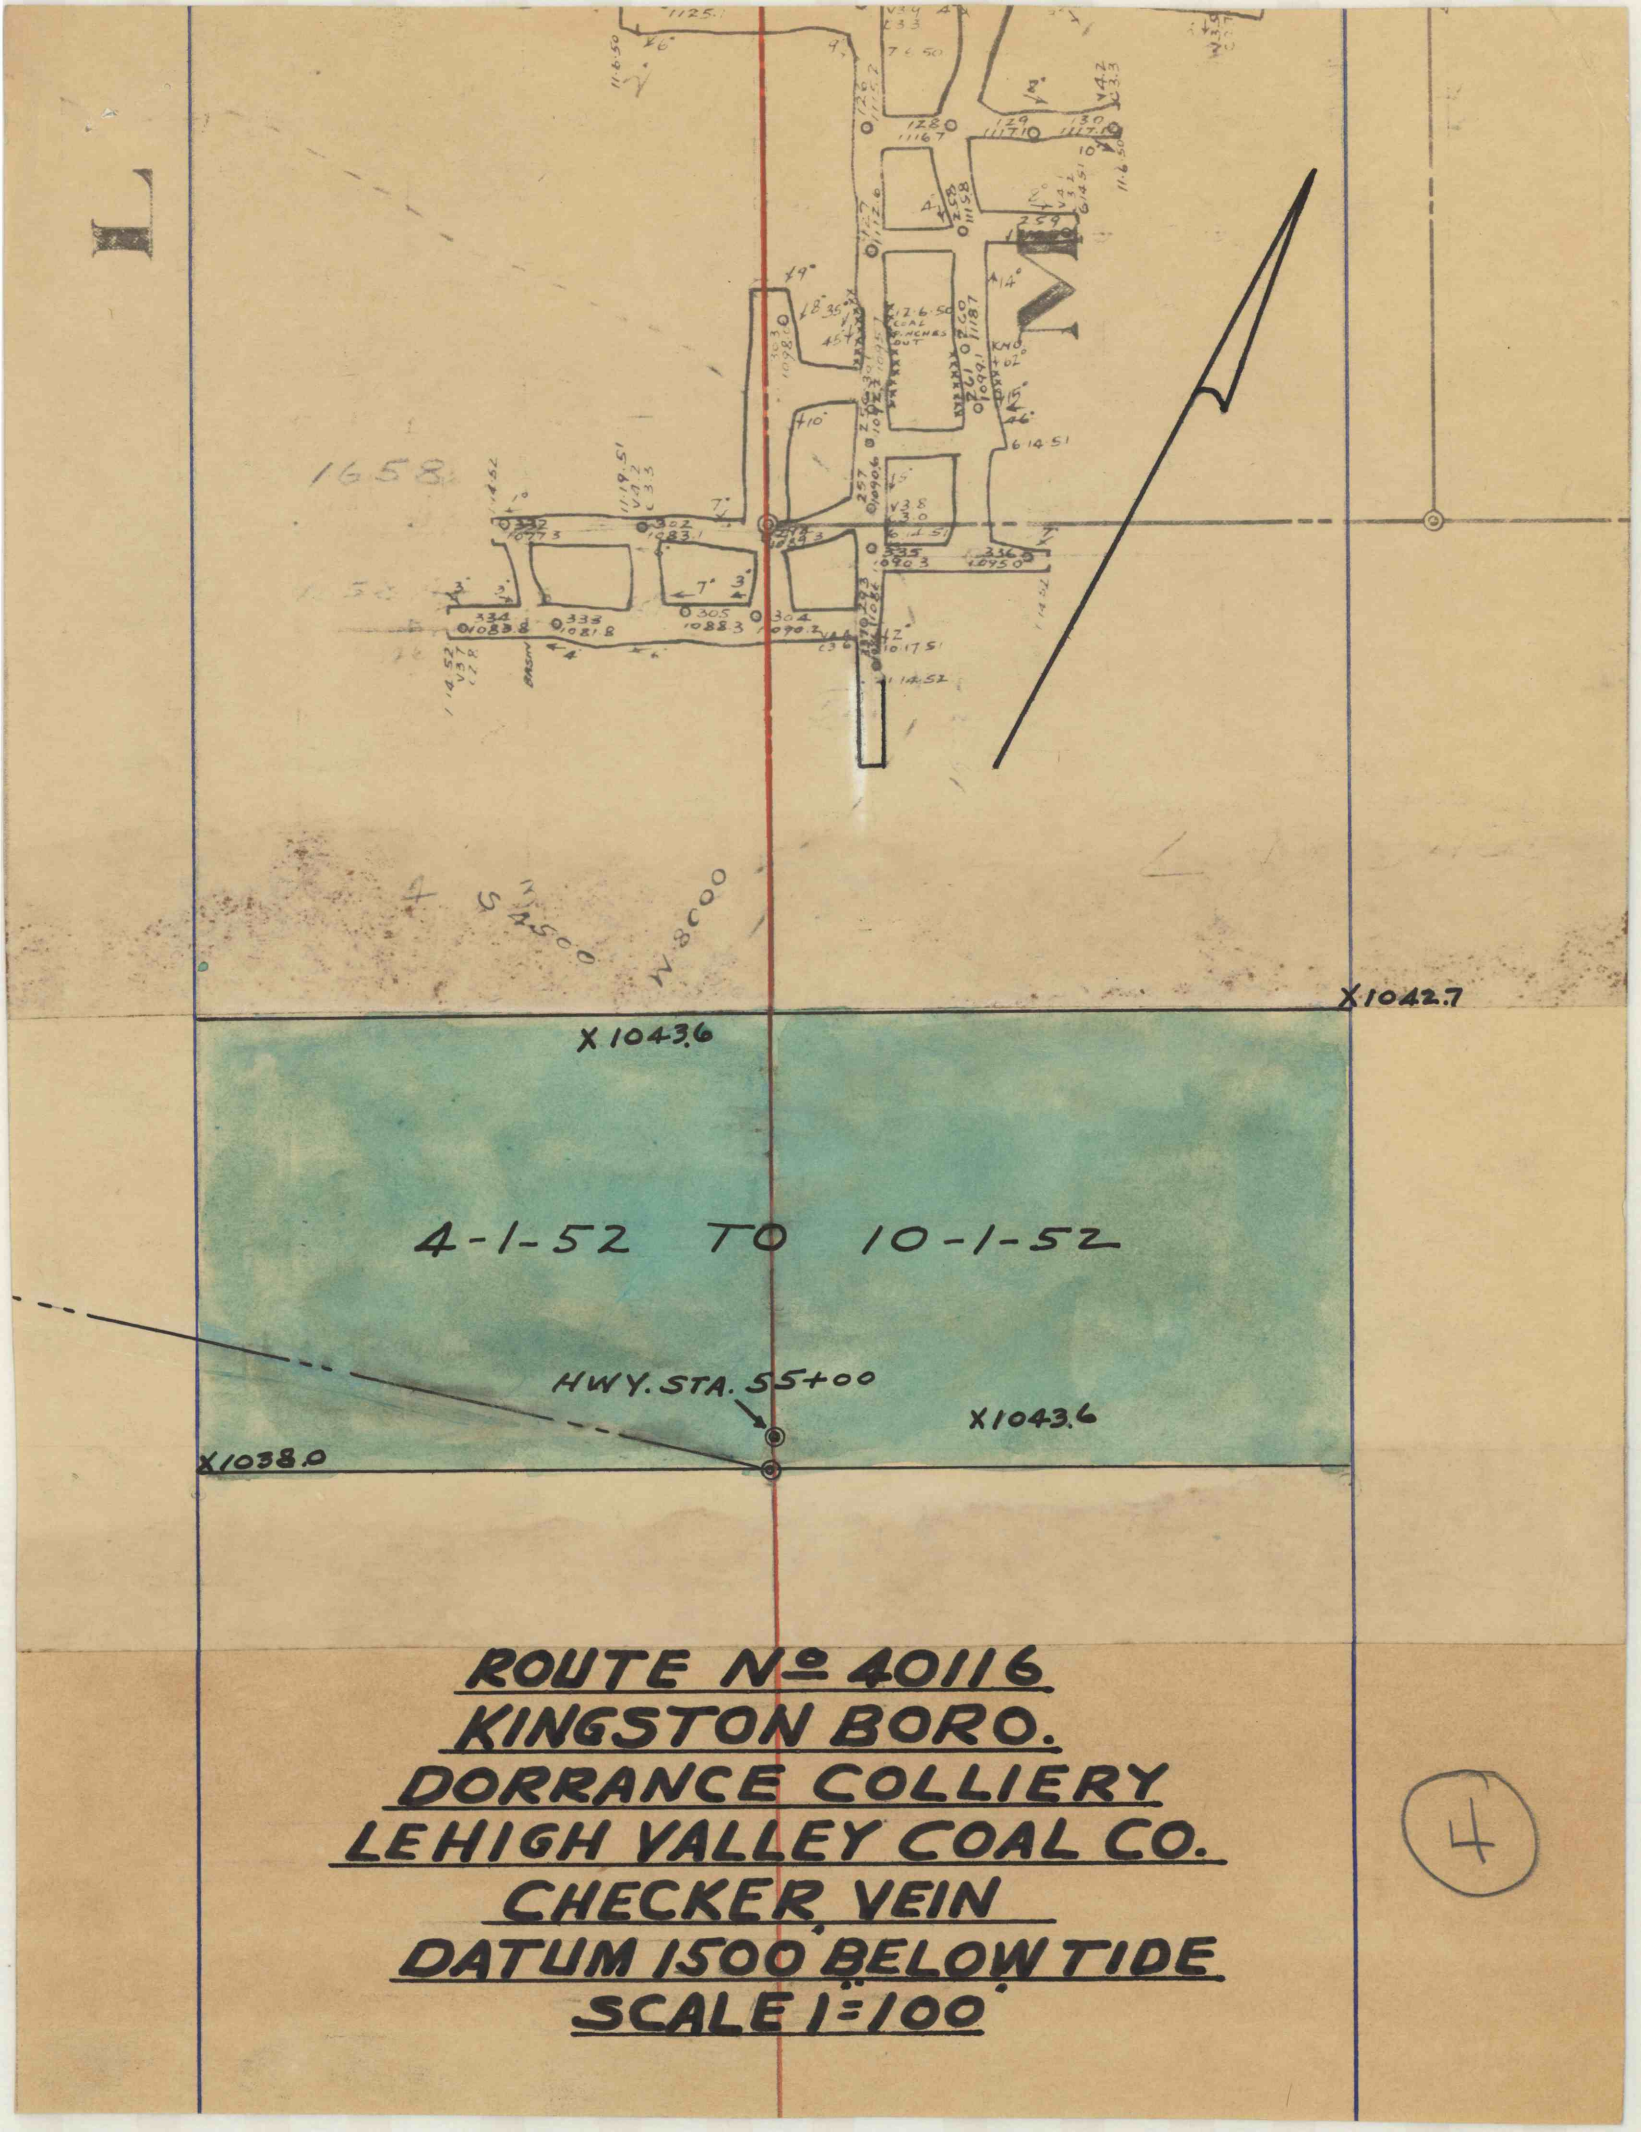

ROUTE No. 40116
KINGSTON BORO.
DORRANCE COLLIERY
LEHIGH VALLEY COAL CO.
CHECKER VEIN
DATUM 1500' BELOW TIDE
SCALE 1"=100'

(4)