

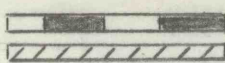


LEGEND

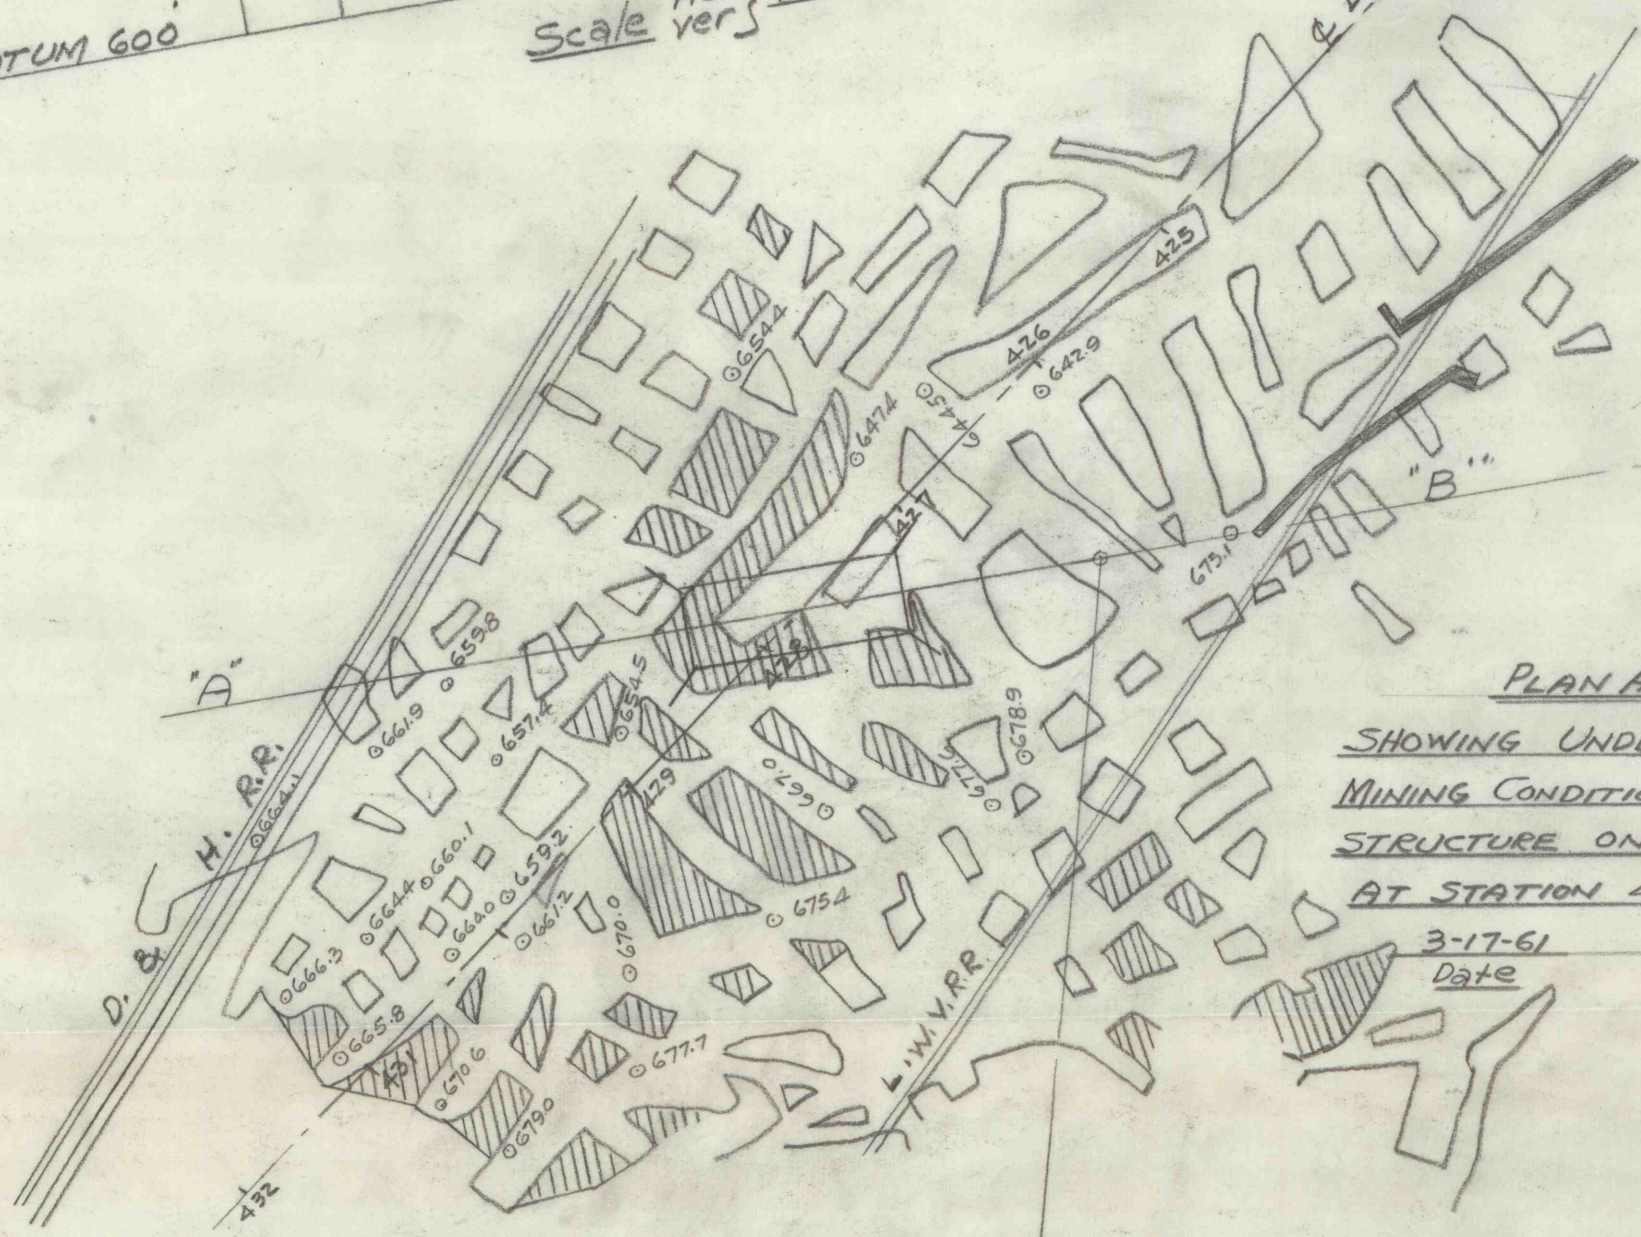

PILLAR IN PLACE

PILLAR REMOVED

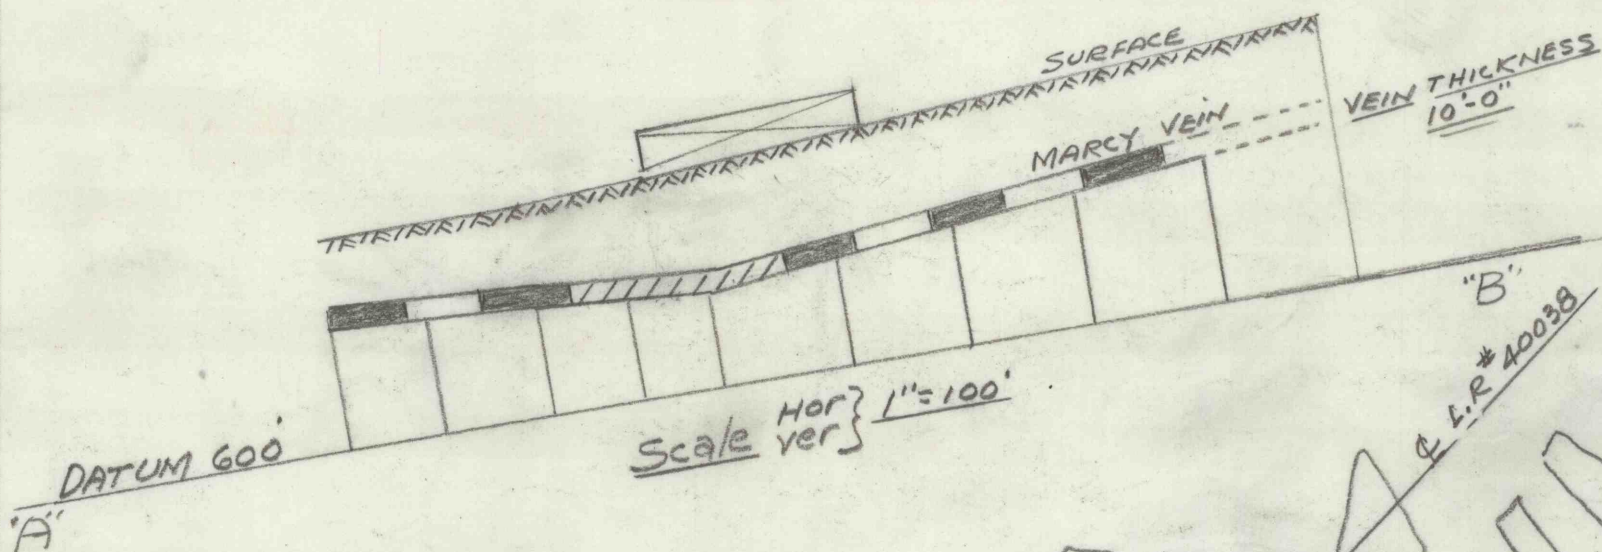

PLAN AND PROFILE

SHOWING UNDERGROUND  
MINING CONDITION BENEATH  
STRUCTURE ON L.R. # 40038

AT STATION 427+80

3-17-61  
Date

1" = 100'  
Scale