




CLARK VEIN  
SCALE 1" = 100'

CLARK

17.6  
7.3  
528  
1232  
128.48  
4.3  
375.44  
51392  
255 x 44  
54 | 20.42  
114  
108  
66

749.00  
7.84  
371.66  
715.00  
711.66  
8.46  
713.20  
9.33  
712.53  
710.03  
0.19  
710.22  
3.91  
716.31  
78.81  
78.58  
12.58  
73070

0+0  
Elevation #  
Surf = 780.0  
Depth = 47.0  
Roof = 729.0  
W-H Box 716.2  
#1 = 11 x 13  
#2 = 11 x 12  
#3 = 13 x 16  
#4 = 26 x 15  
#5 = 10 x 13  
#6 = 10 x 15  
#7 = 13 x 12.5  
#8 = 11 x 13.5  
#9 = 12 x 14  
#10 = 8 x 10  
#11 = 15 x 15  
#12 = 13 x 13.5  
#13 = 11 x 12  
Ch.D. 22 x 13

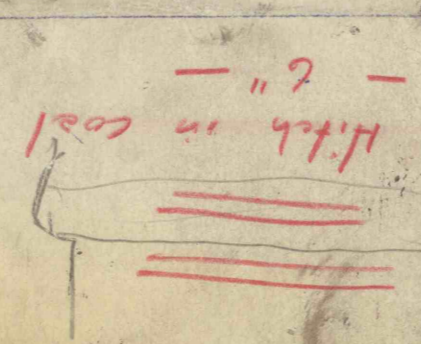

Wedge = Top  
Hit in Bottom

PERSON AVE 4734

ARM'S AVE

ROOF

600

8-12

28" ESCAPE

ACCESS

FLUSH

B-13

B-76

B-74

B-71

B-2

B-1

B-2

9766.2 = SURF  
620 = Approx. Clark

7010

+708.7

608.0

601.0








603.0

603.0

