


4

ROUTE 40046

STA. 24+00

PLAINS TOWNSHIP

SEPT. 5, 1947

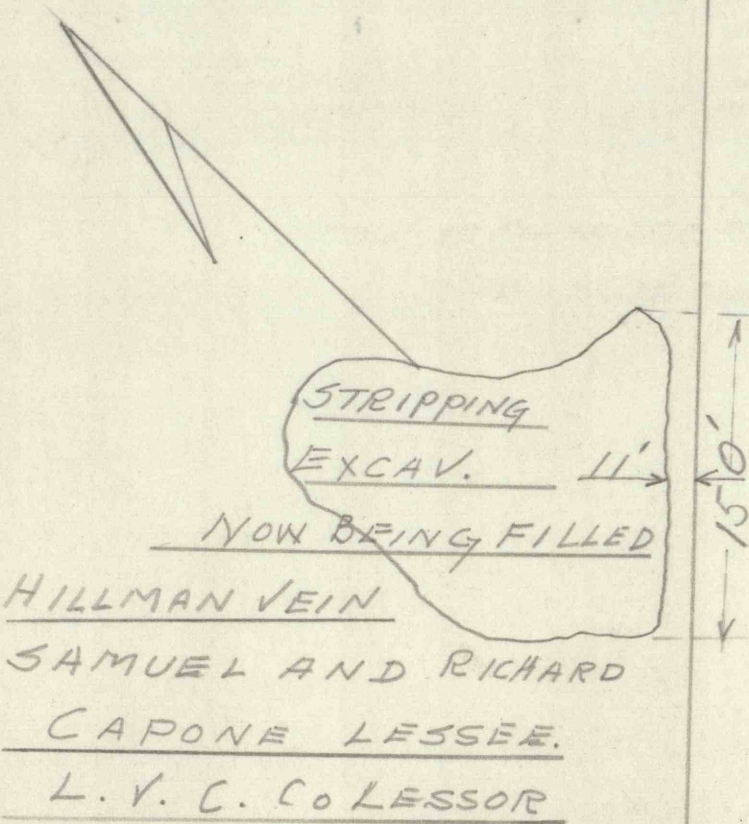

CURB  
ROUTE #40046  
MOFFET ST.

