


Rock 37-9
V. 10-1
C. 6-4
Elev. 412.57

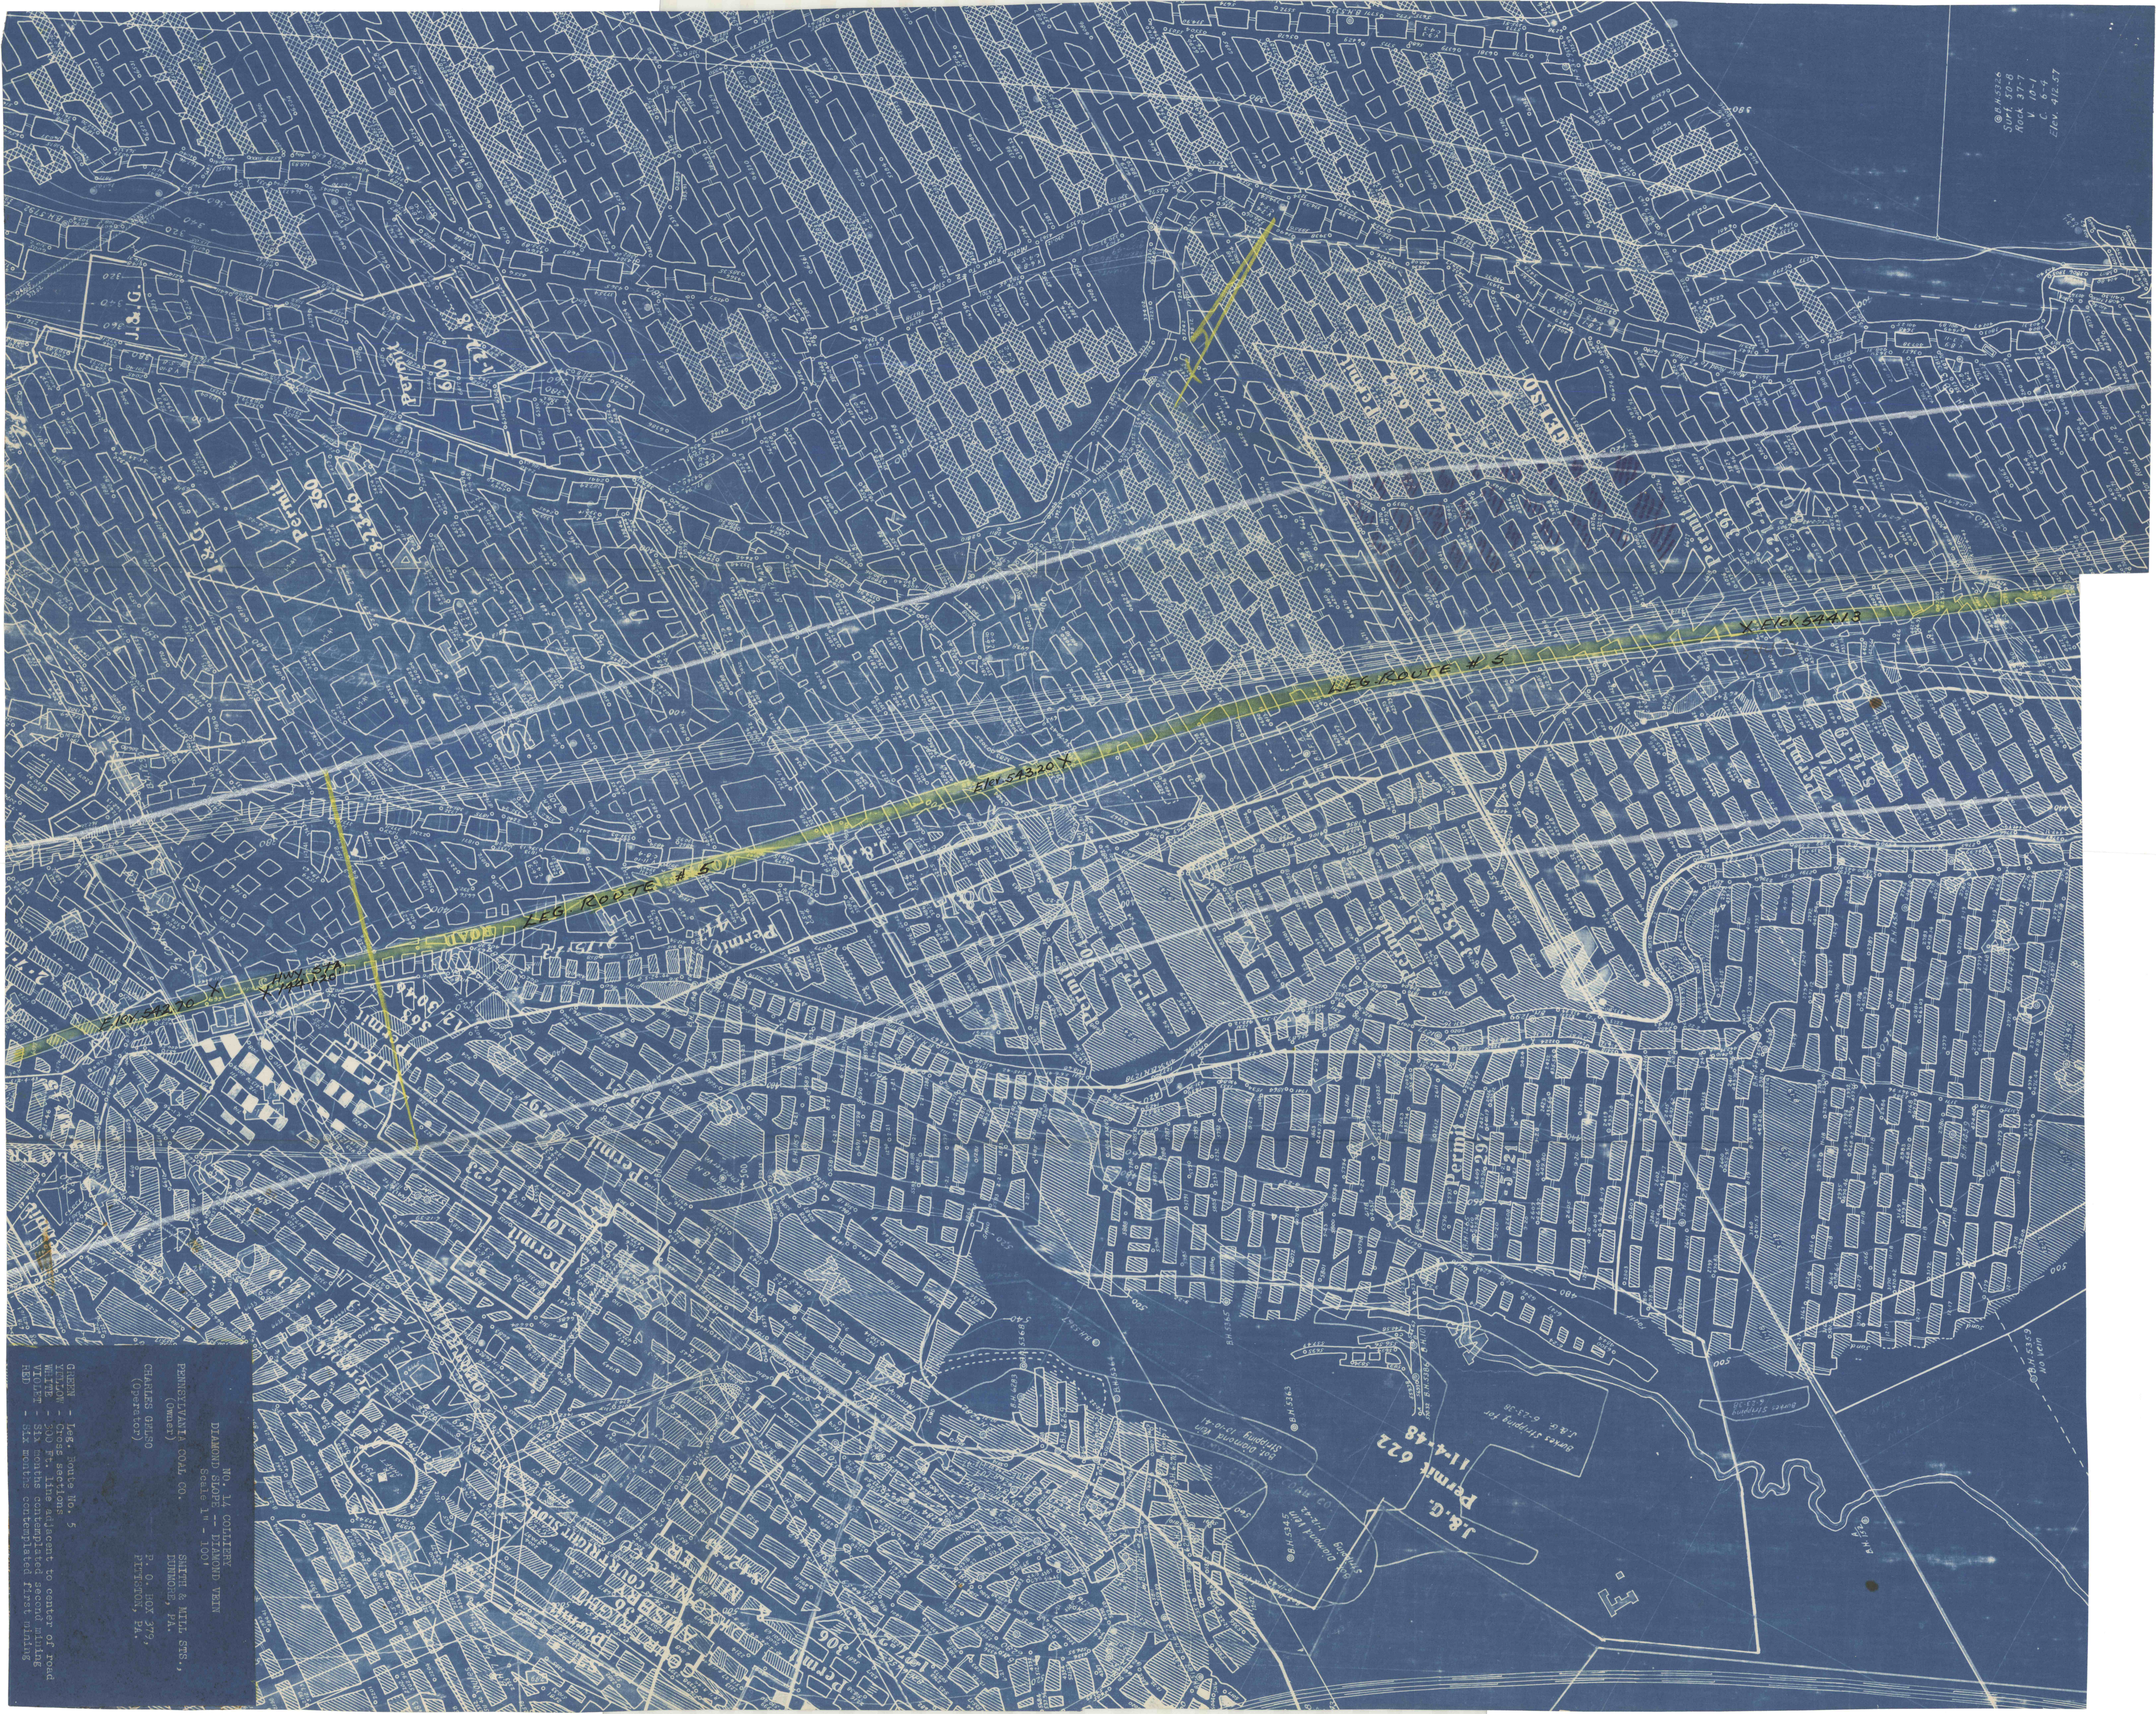

GREEN - Leg. route No. 5
YELLOW - Cross sections
RED - Six months contemplated first riding

NO. 14 COLLIER
DIAMOND SLOPE -- DIAMOND VEIN
Scale 1" = 100'

(owner)
CHARLES GRISO
(Operator)

