


Section A-B

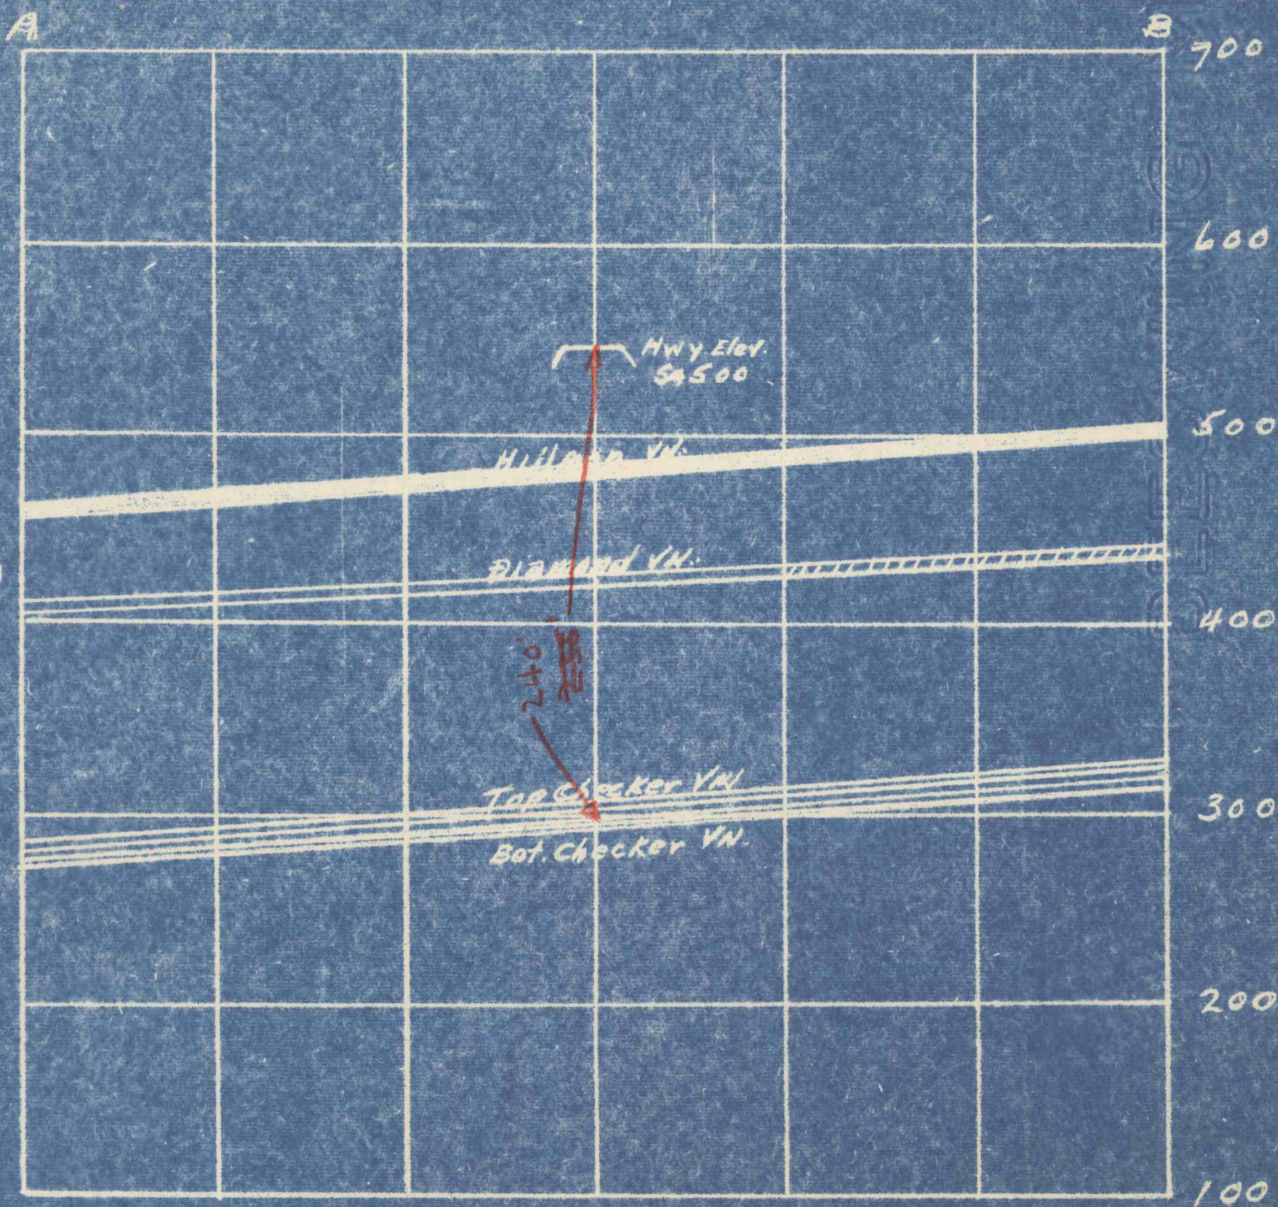

NO. 14 COLLIERY
 No. 14 Shaft - - Bot. Checker Vein
 Scale 1" = 100'

Cross section of Bot. Checker Vein
 underlying Leg. Route No. 5 in
 Jenkins Township, Luzerne County,
 Penna.

- Virgin coal
- First mined
- Complete mining

4