


SECTION A-B

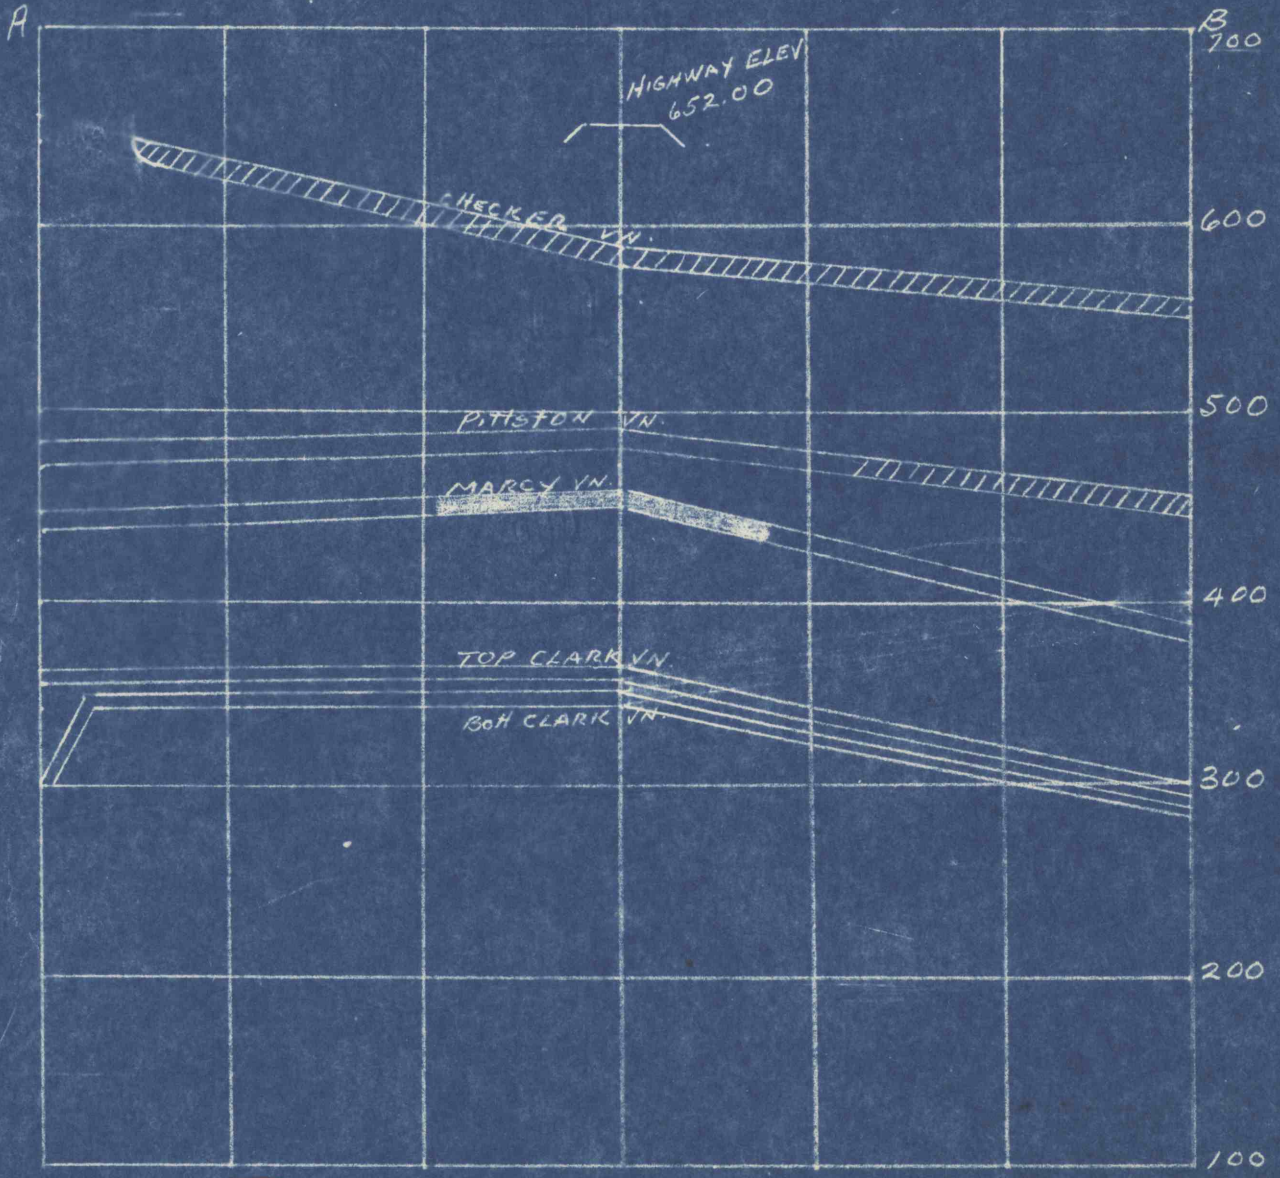

2

Sta. 286+50 to 291+50 - First and second mining under + within 300 feet of Highway

EWEN COLLIERY  
 Hoyt Shaft ----- Bot. Clark Vein  
 Scale 1" = 100'

Cross section of Bot. Clark Vein underlying Leg. Route No. 5 in Jenkins Township, Luzerne County, Pa.

- Virgin coal
- First mined
- Mining completed