


SECTION A - B.

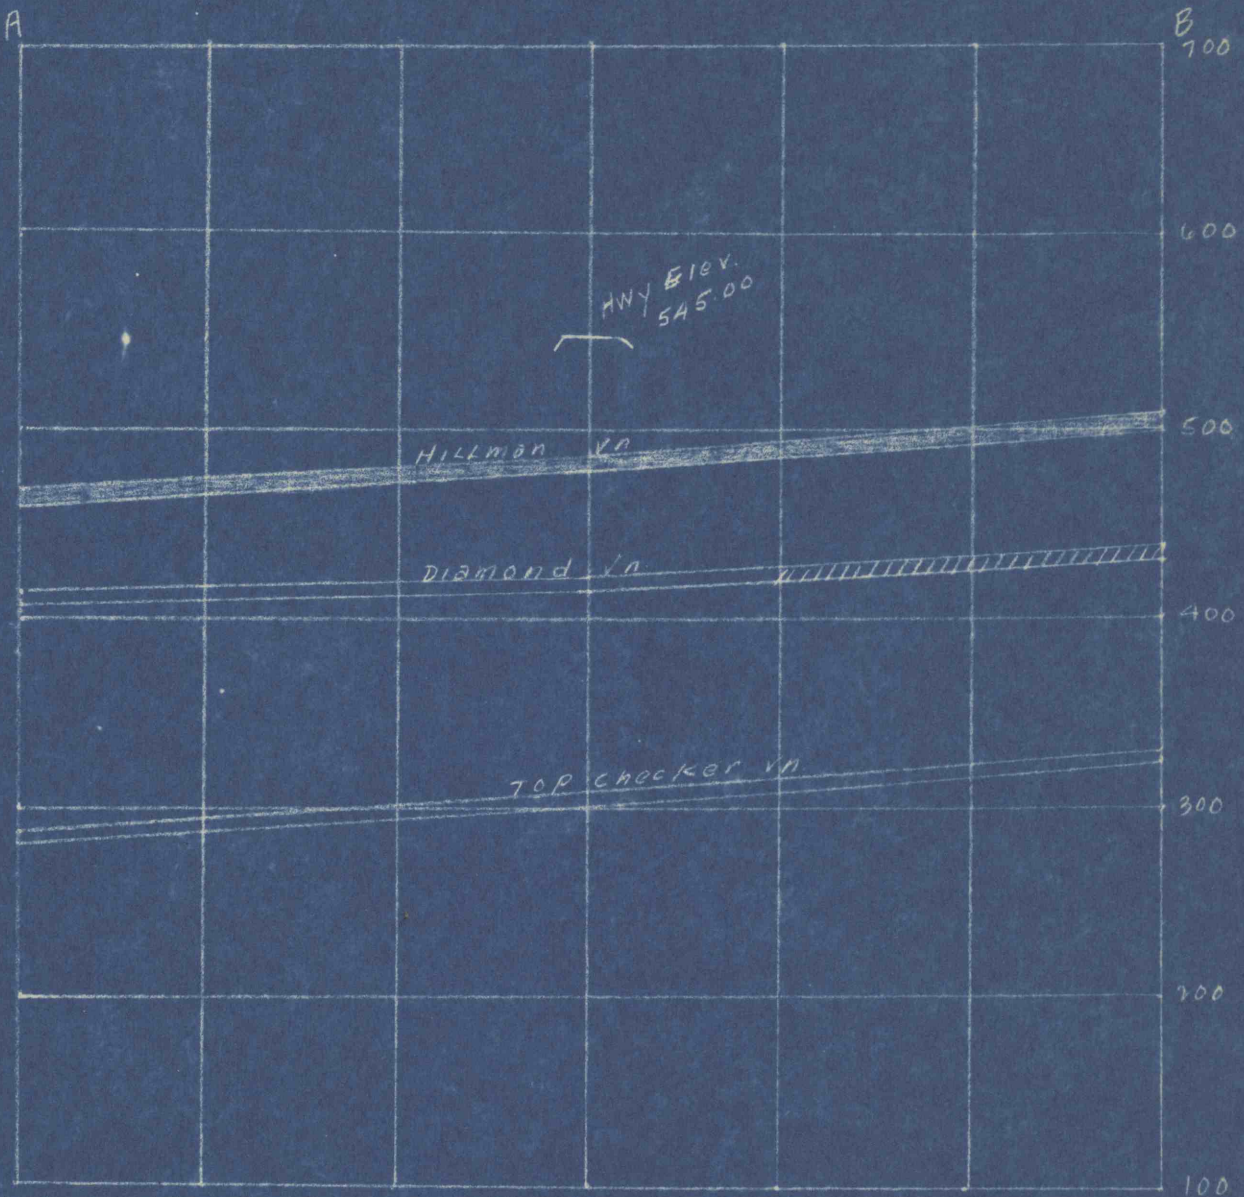




2

1st mining under + within 300'  
adjacent to Sta 181+00

NO. 14 COLLIERY  
No. 14 Shaft - Top Checker Vein  
Scale 1" = 100'

Cross section of Top Checker Vein  
underlying Leg. Route No. 5 in  
JENKINS Township, Luzerne County,  
Penna.

-  Virgin coal
-  First mined
-  Complete mining