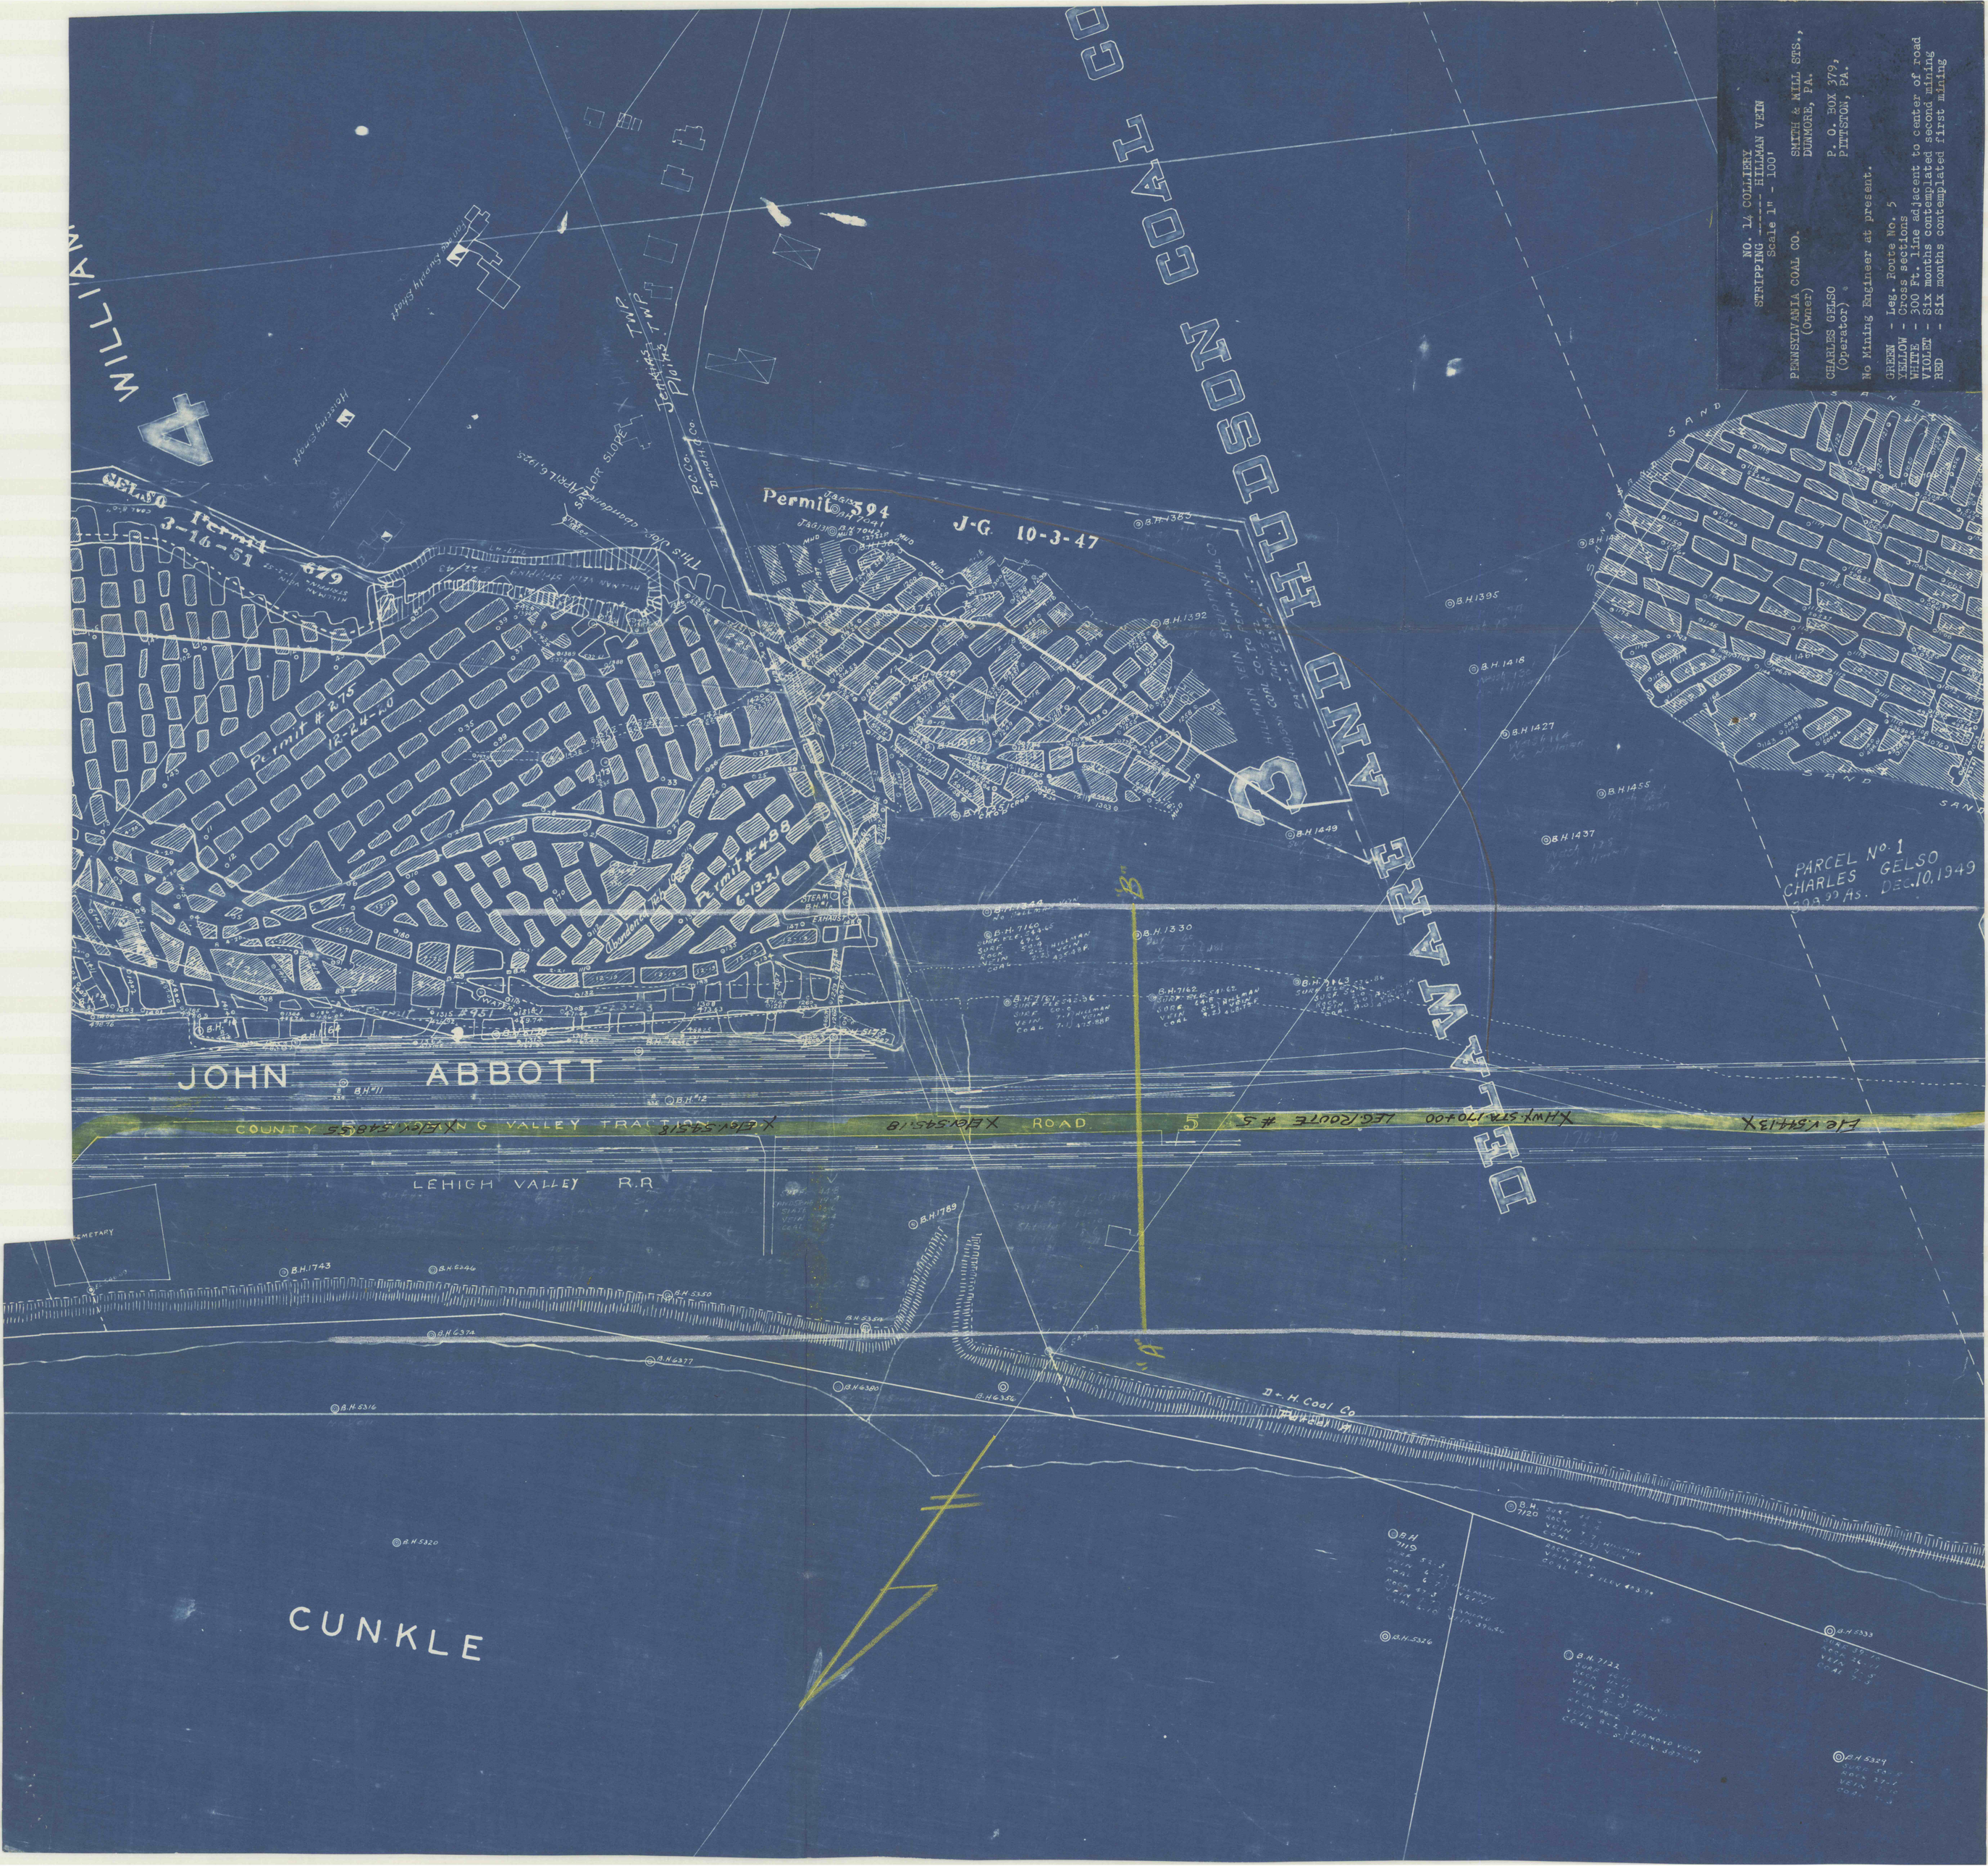
NO. 14 COLLIERY
STRIPPING ----- HILLMAN VEIN
Scale 1" - 100'
PENNSYLVANIA COAL CO. (Owner)
SMITH & MILL STS., DUNMORE, PA.
CHARLES GELSO (Operator)
P. O. BOX 379, PITTSTON, PA.
No Mining Engineer at present.
GREEN - Leg. Route No. 5
YELLOW - Cross sections
WHITE - 300 Ft. line adjacent to center of road
VIOLET - Six months contemplated second mining
RED - Six months contemplated first mining
HUDSON COAL CO
WILLIAMS
GELSO Permit 3-16-51 679
Permit 594 J-G 10-3-47
Permit # 275 12-24-40
Permit #488 6-13-21
Permit #451
Abandoned Tipple
JOHN ABBOTT
COUNTY
ROAD
LEHIGH VALLEY R.R
CEMETERY
CUNKLE
D. H. Coal Co
PARCEL No. 1
CHARLES GELSO
DEC. 10, 1949