


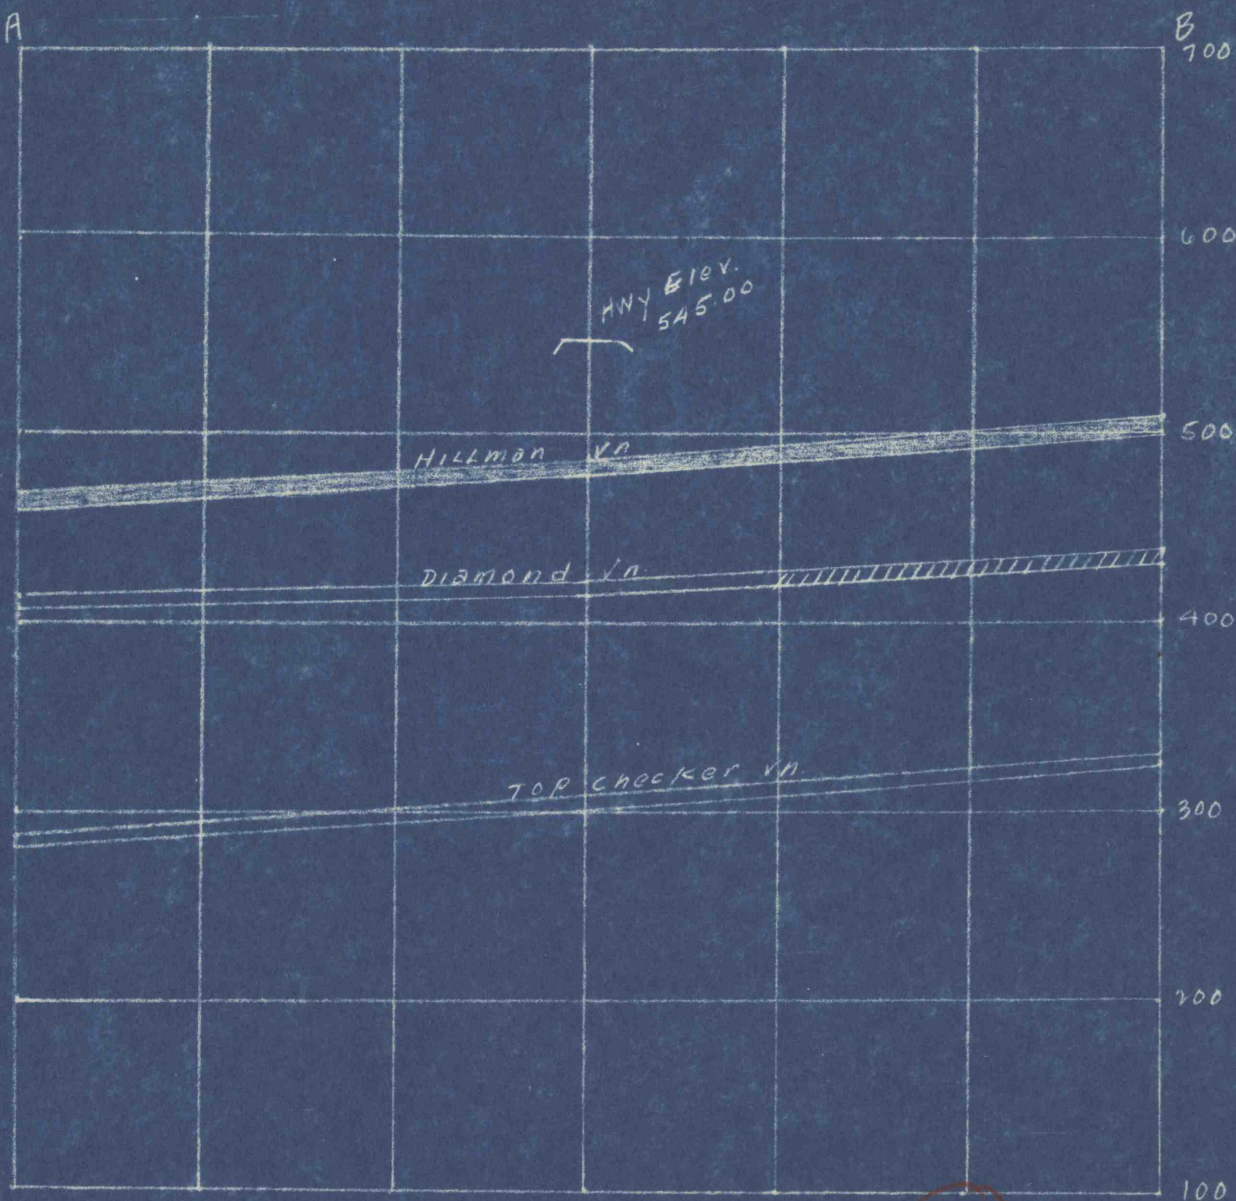


SECTION A - B.



2

NO. 14 COLLIERY  
 No. 14 Shaft - Top Checker Vein  
 Scale 1" - 100'

Cross section of Top Checker Vein  
 underlying Leg. Route No. 5 in  
 Plains Township, Luzerne County,  
 Penna.

-  Virgin coal
-  First mined
-  Complete mining