


214+60  
 $\frac{8 \text{ ft}}{222 \text{ 60}}$

SECTION A - B

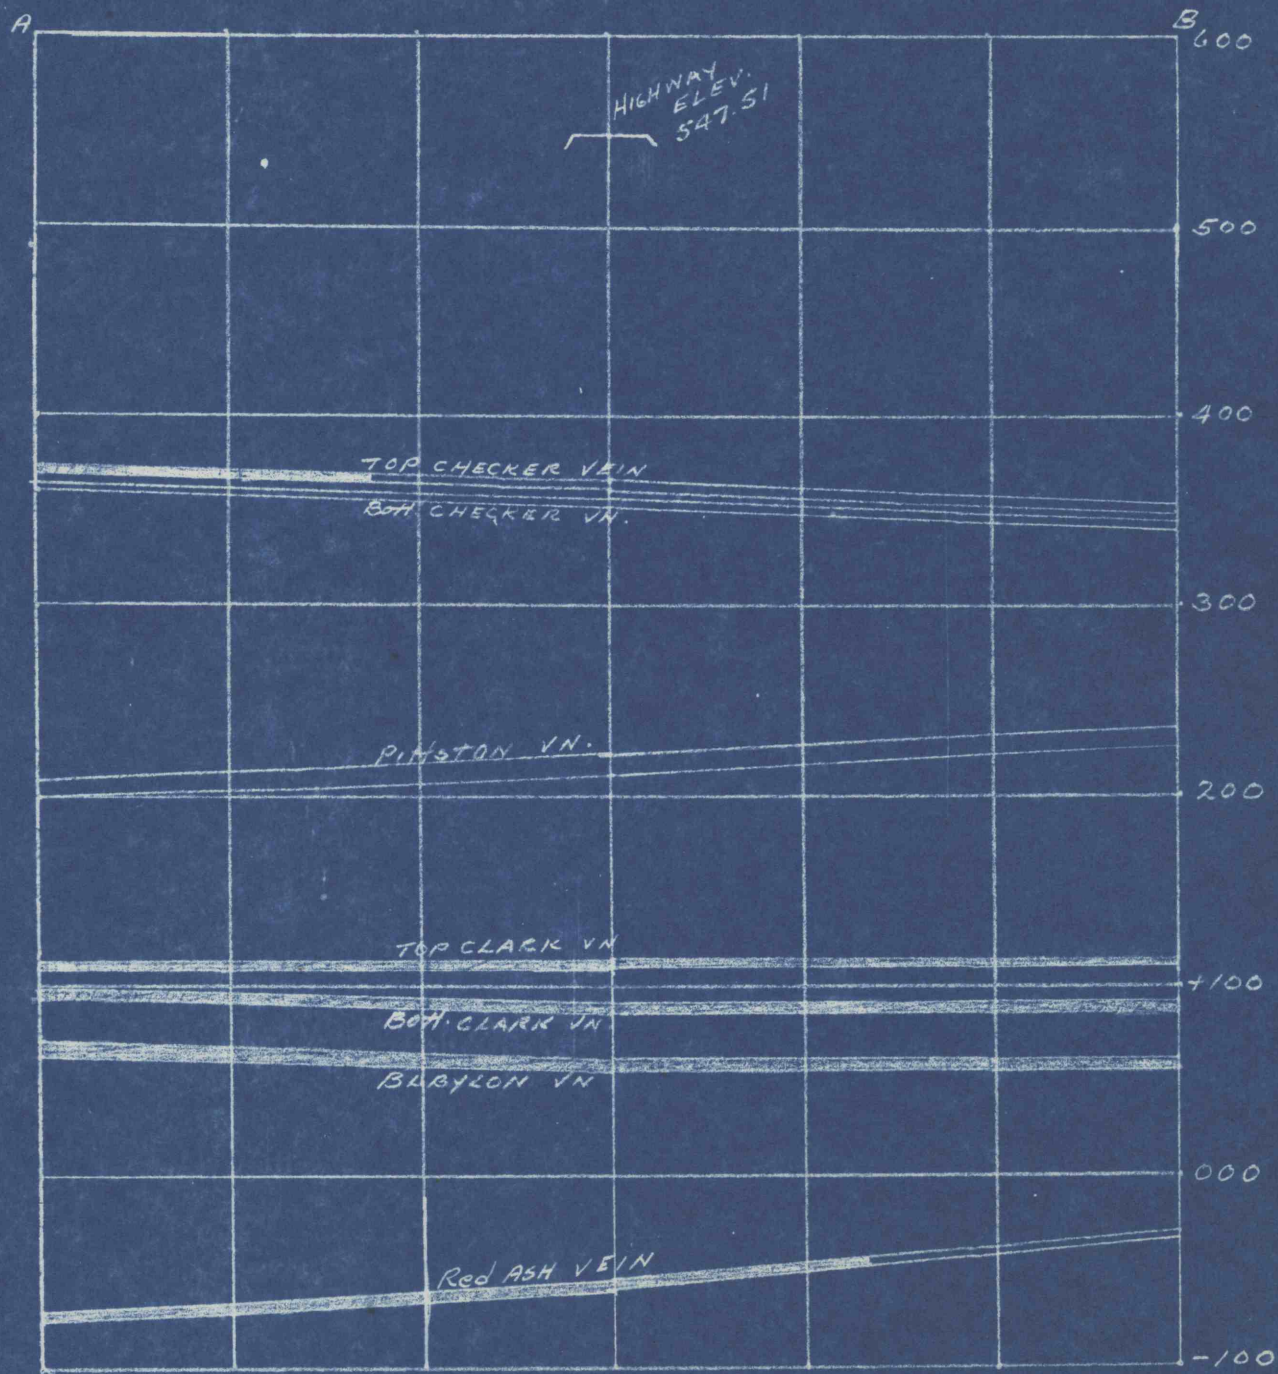




Sta 214+60 to 222+60  
 1st mining within 300' of Highway

3

NO. 14 COLLIERY  
 Red Ash Shaft - - - Red Ash Vein  
 Scale 1" = 100'

Cross section of Red Ash Vein  
 underlying Leg. Route #5, Luzerne  
 County (Jenkins Township), Pa.

-  Virgin coal
-  First mined
-  Mining completed