




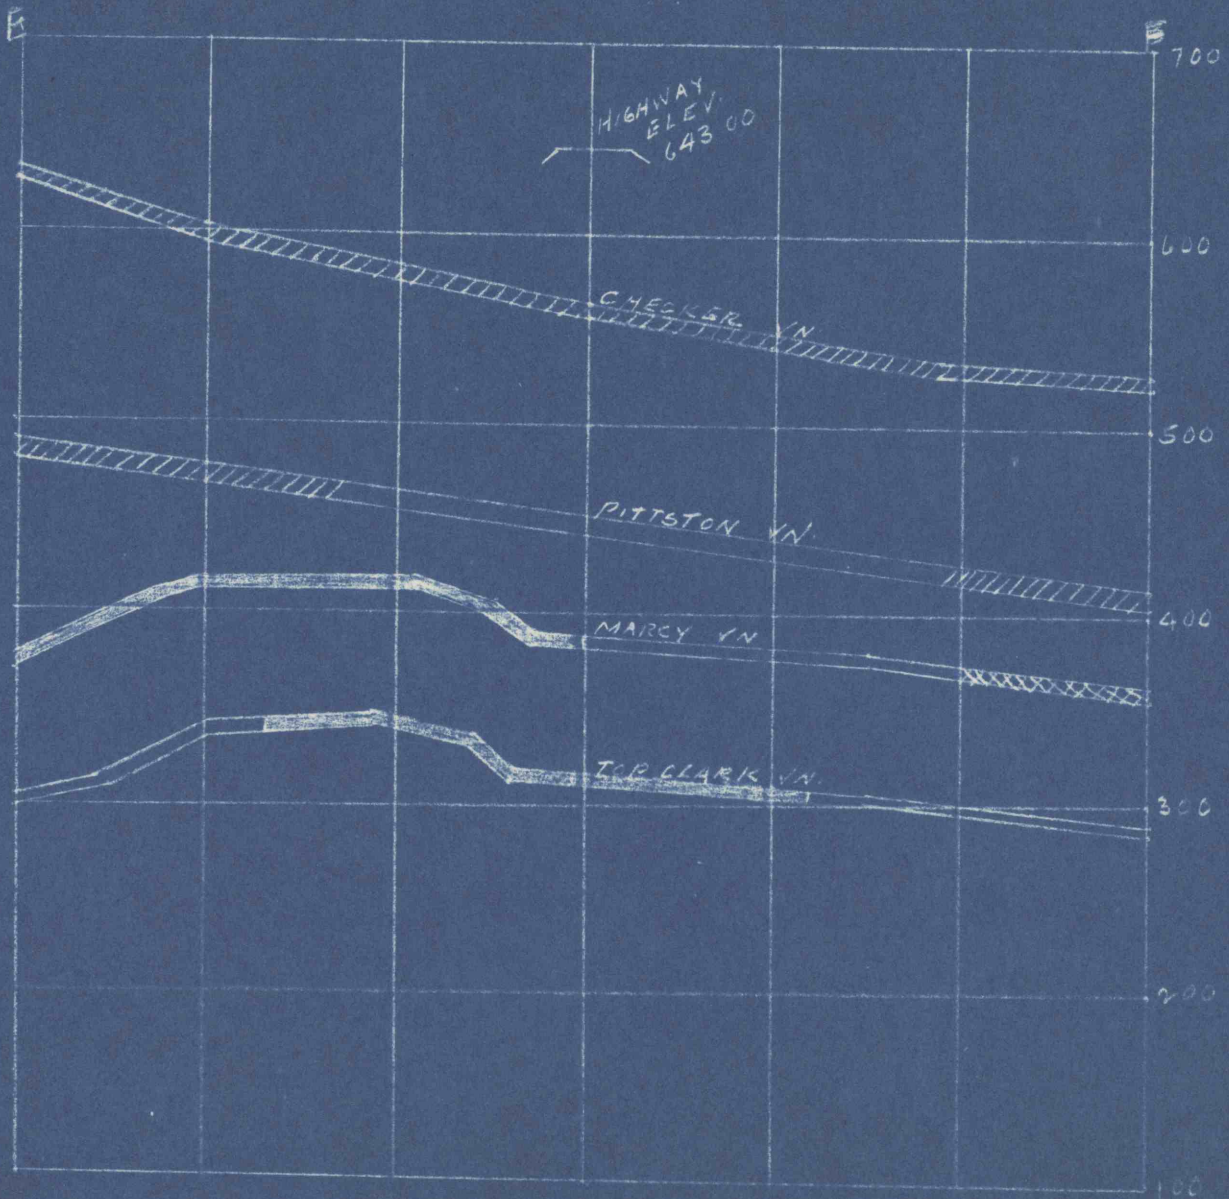

SECTION E - E



EWEN COLLIERY
 Hoyt Shaft - - - - Top Clark Vein
 Scale 1" - 100'

Cross section of Top Clark Vein
 underlying Leg. Route #5, Jenkins
 Twp., Luzerne County, Pa.

-  Virgin coal
-  First mined
-  Mining completed
-  Rock packed