


SECTION A-B

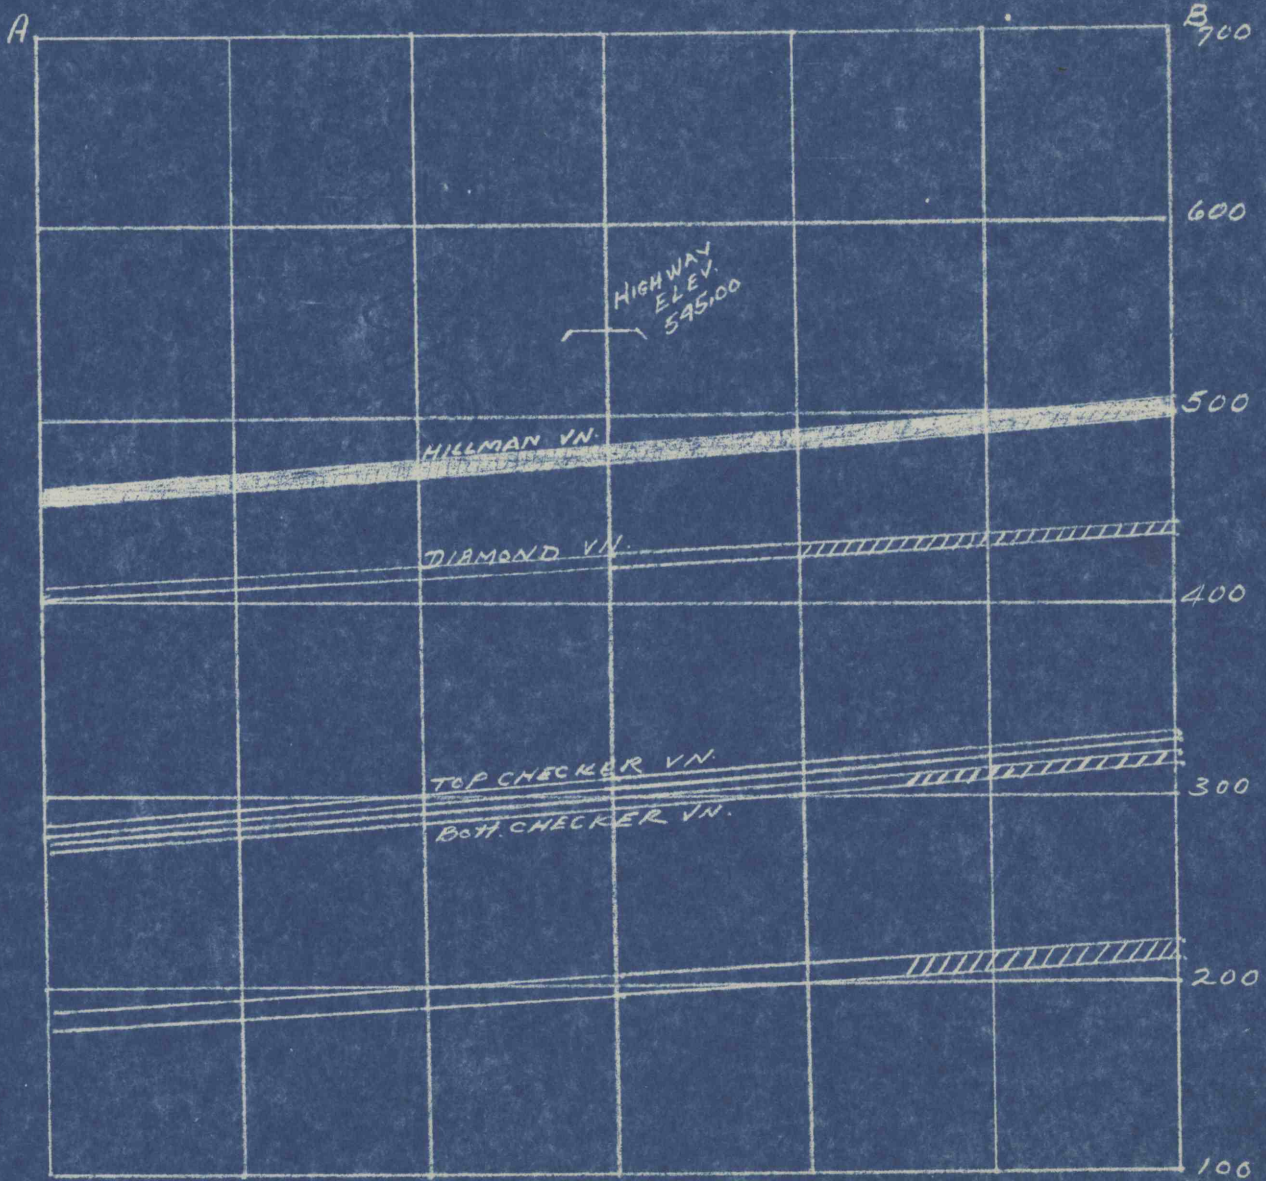




6

1st mining within 300 feet  
of Hwy

NO. 14 COLLIERY  
 No. 14 Shaft - - - Pittston Vein  
 Scale 1" = 100'

Cross section of Pittston Vein  
 underlying Leg. Route No. 5 in  
 Plains Twp., Luzerne County, Pa.

 Virgin coal  
 First mining  
 Complete mining