


SCALE 1" = 20'

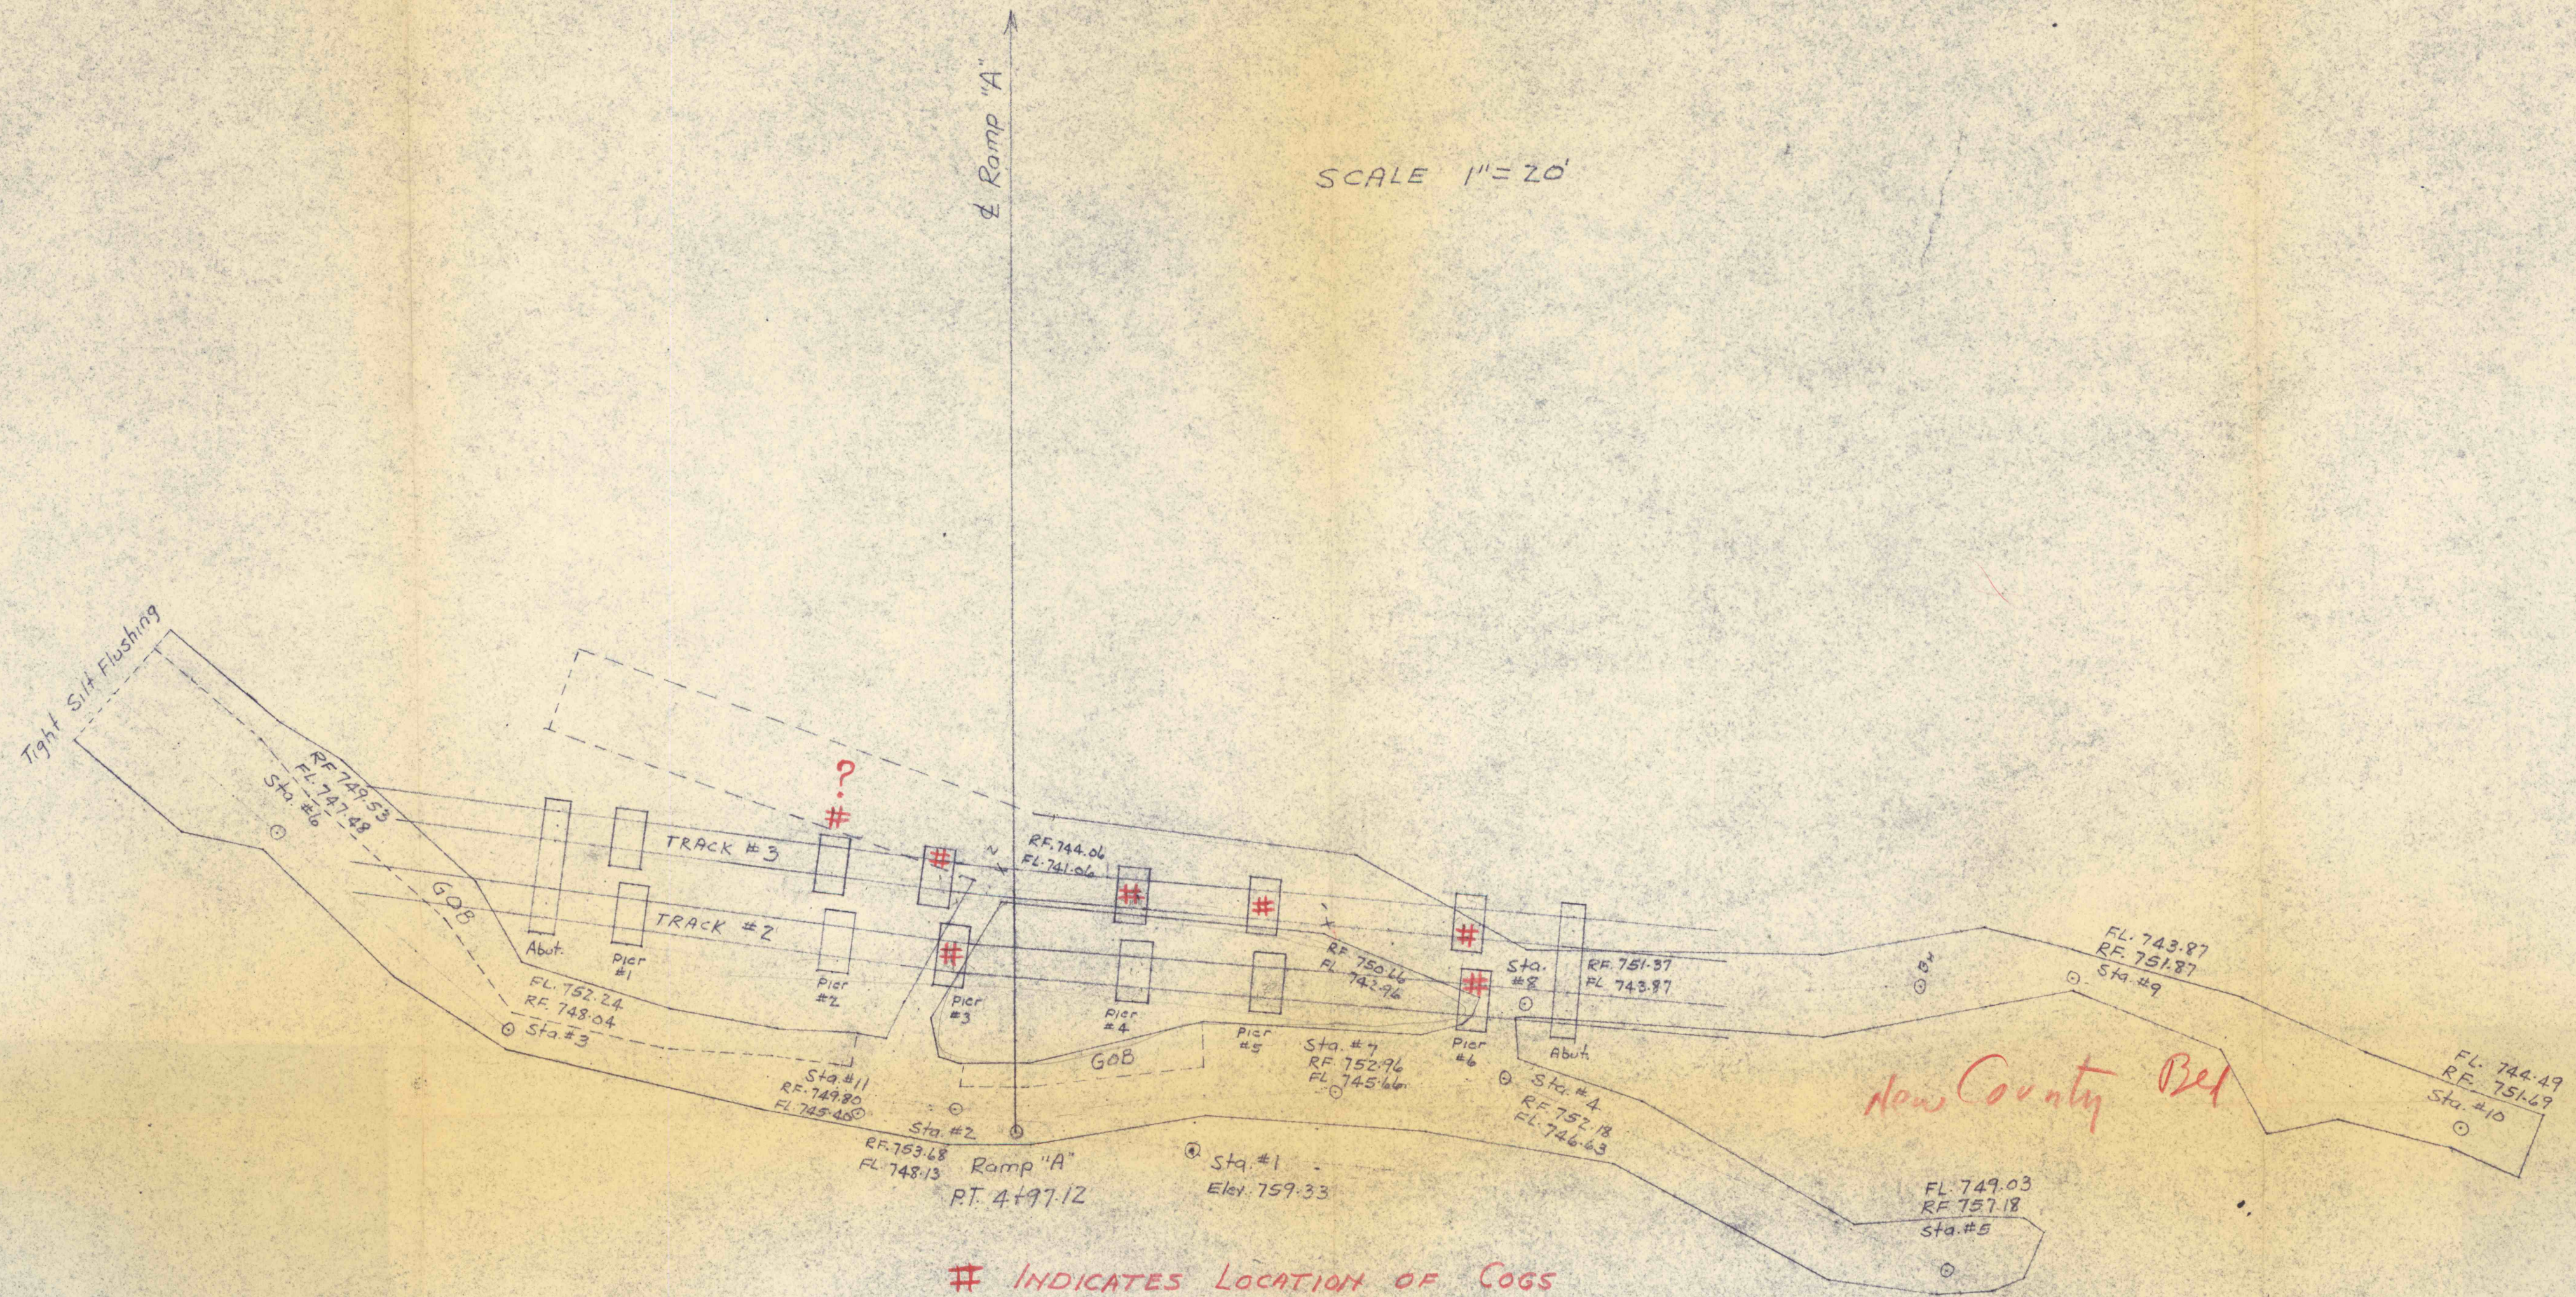

INDICATES LOCATION OF COGS