


WILKES-BARRE COAL
ALEX. NO. 4
GRAY

DIMAMS
GHI

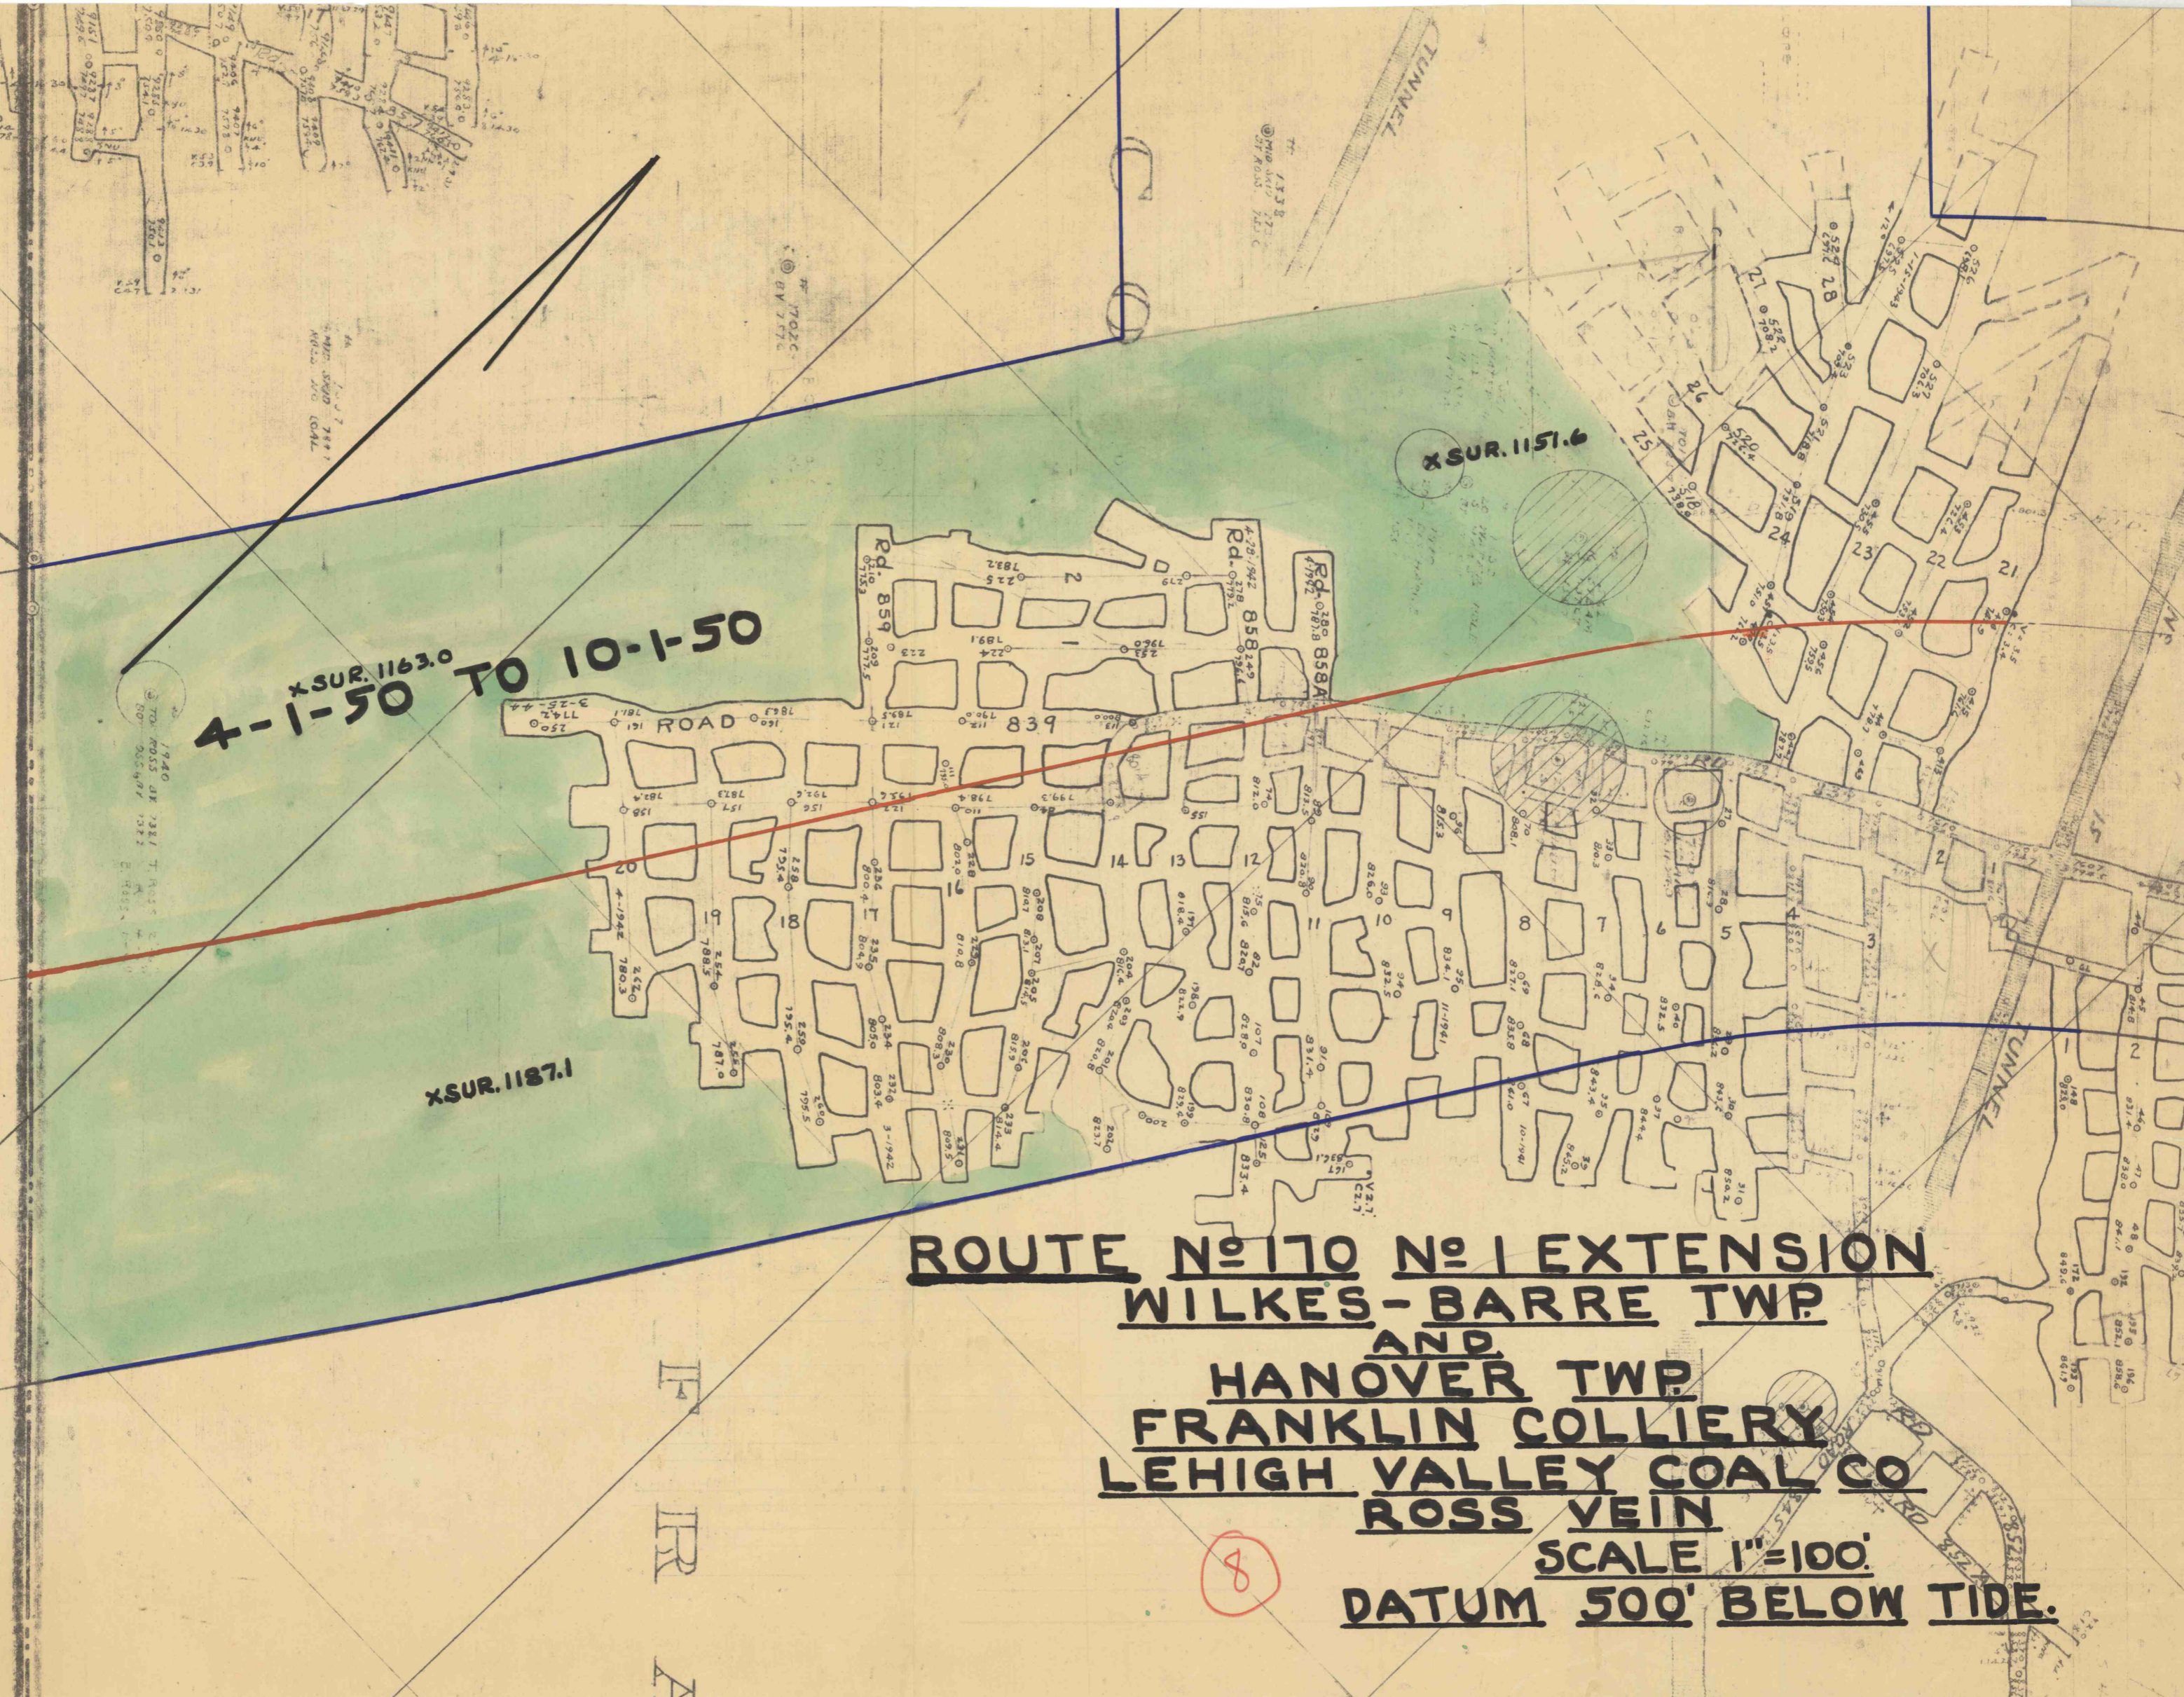

4-1-50 TO 10-1-50
X SUR. 1163.0

X SUR. 1187.1

X SUR. 1151.6

ROUTE No 170 No 1 EXTENSION
WILKES-BARRE TWP
AND
HANOVER TWP
FRANKLIN COLLIERY
LEHIGH VALLEY COAL CO
ROSS VEIN
SCALE 1"=100'
DATUM 500' BELOW TIDE.

8