



Oct. 21, 1980

FLY LINE STA 6400 =
outside Edge of PAVE 0+00 TRAFFIC ROUTE 309

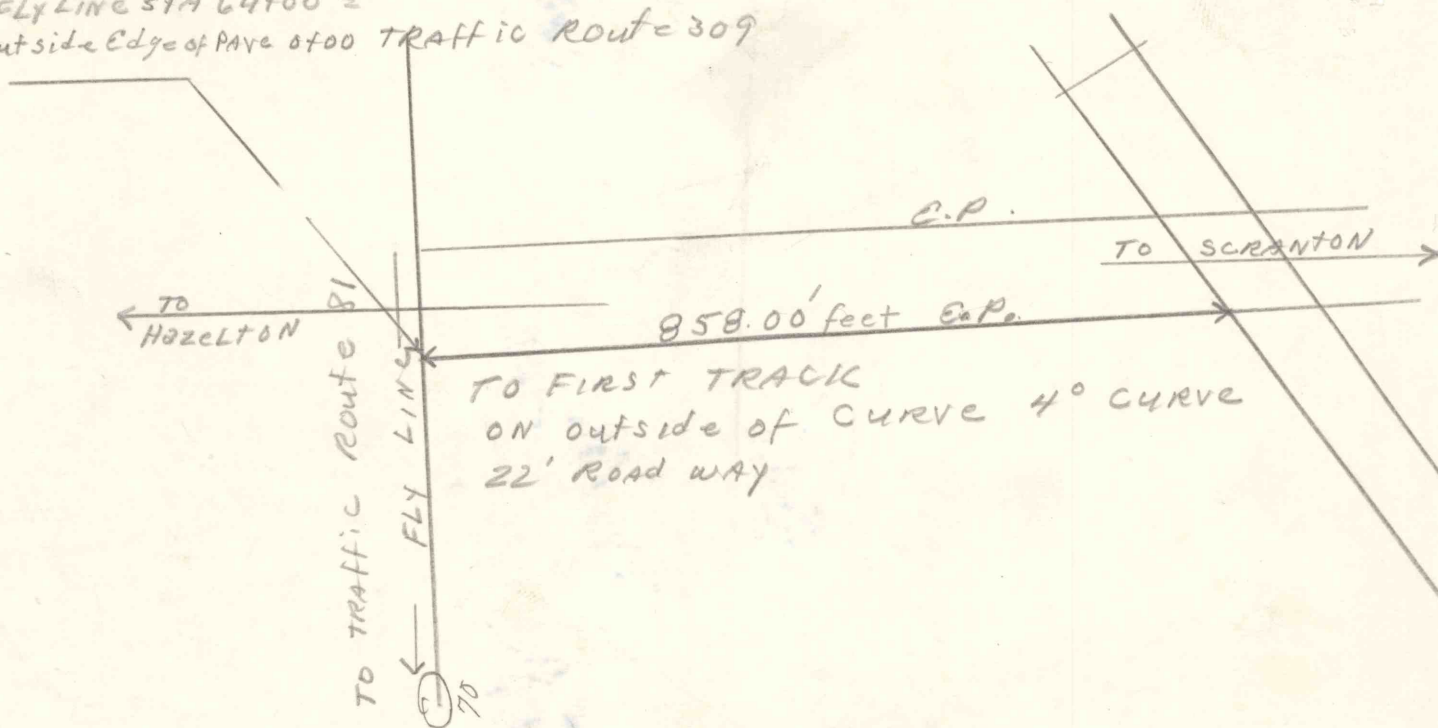

$$\begin{array}{r} 110 + 87.10 \\ 105 + 62.65 \\ \hline 524.55 \end{array} \text{ E.P.}$$

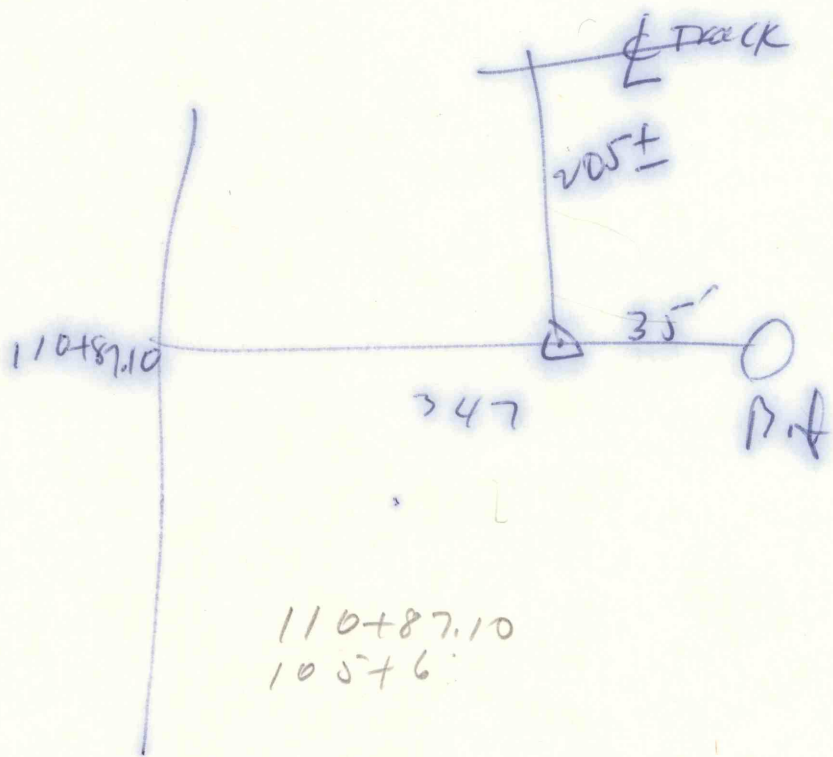

$$105 + 62.65$$

at

$$105 + 38.65$$

inside

N.B EP

~~104 + 53.16~~

$$104 + 53.16 =$$

105 on Plan