


LEHIGH VALLEY COAL CO.

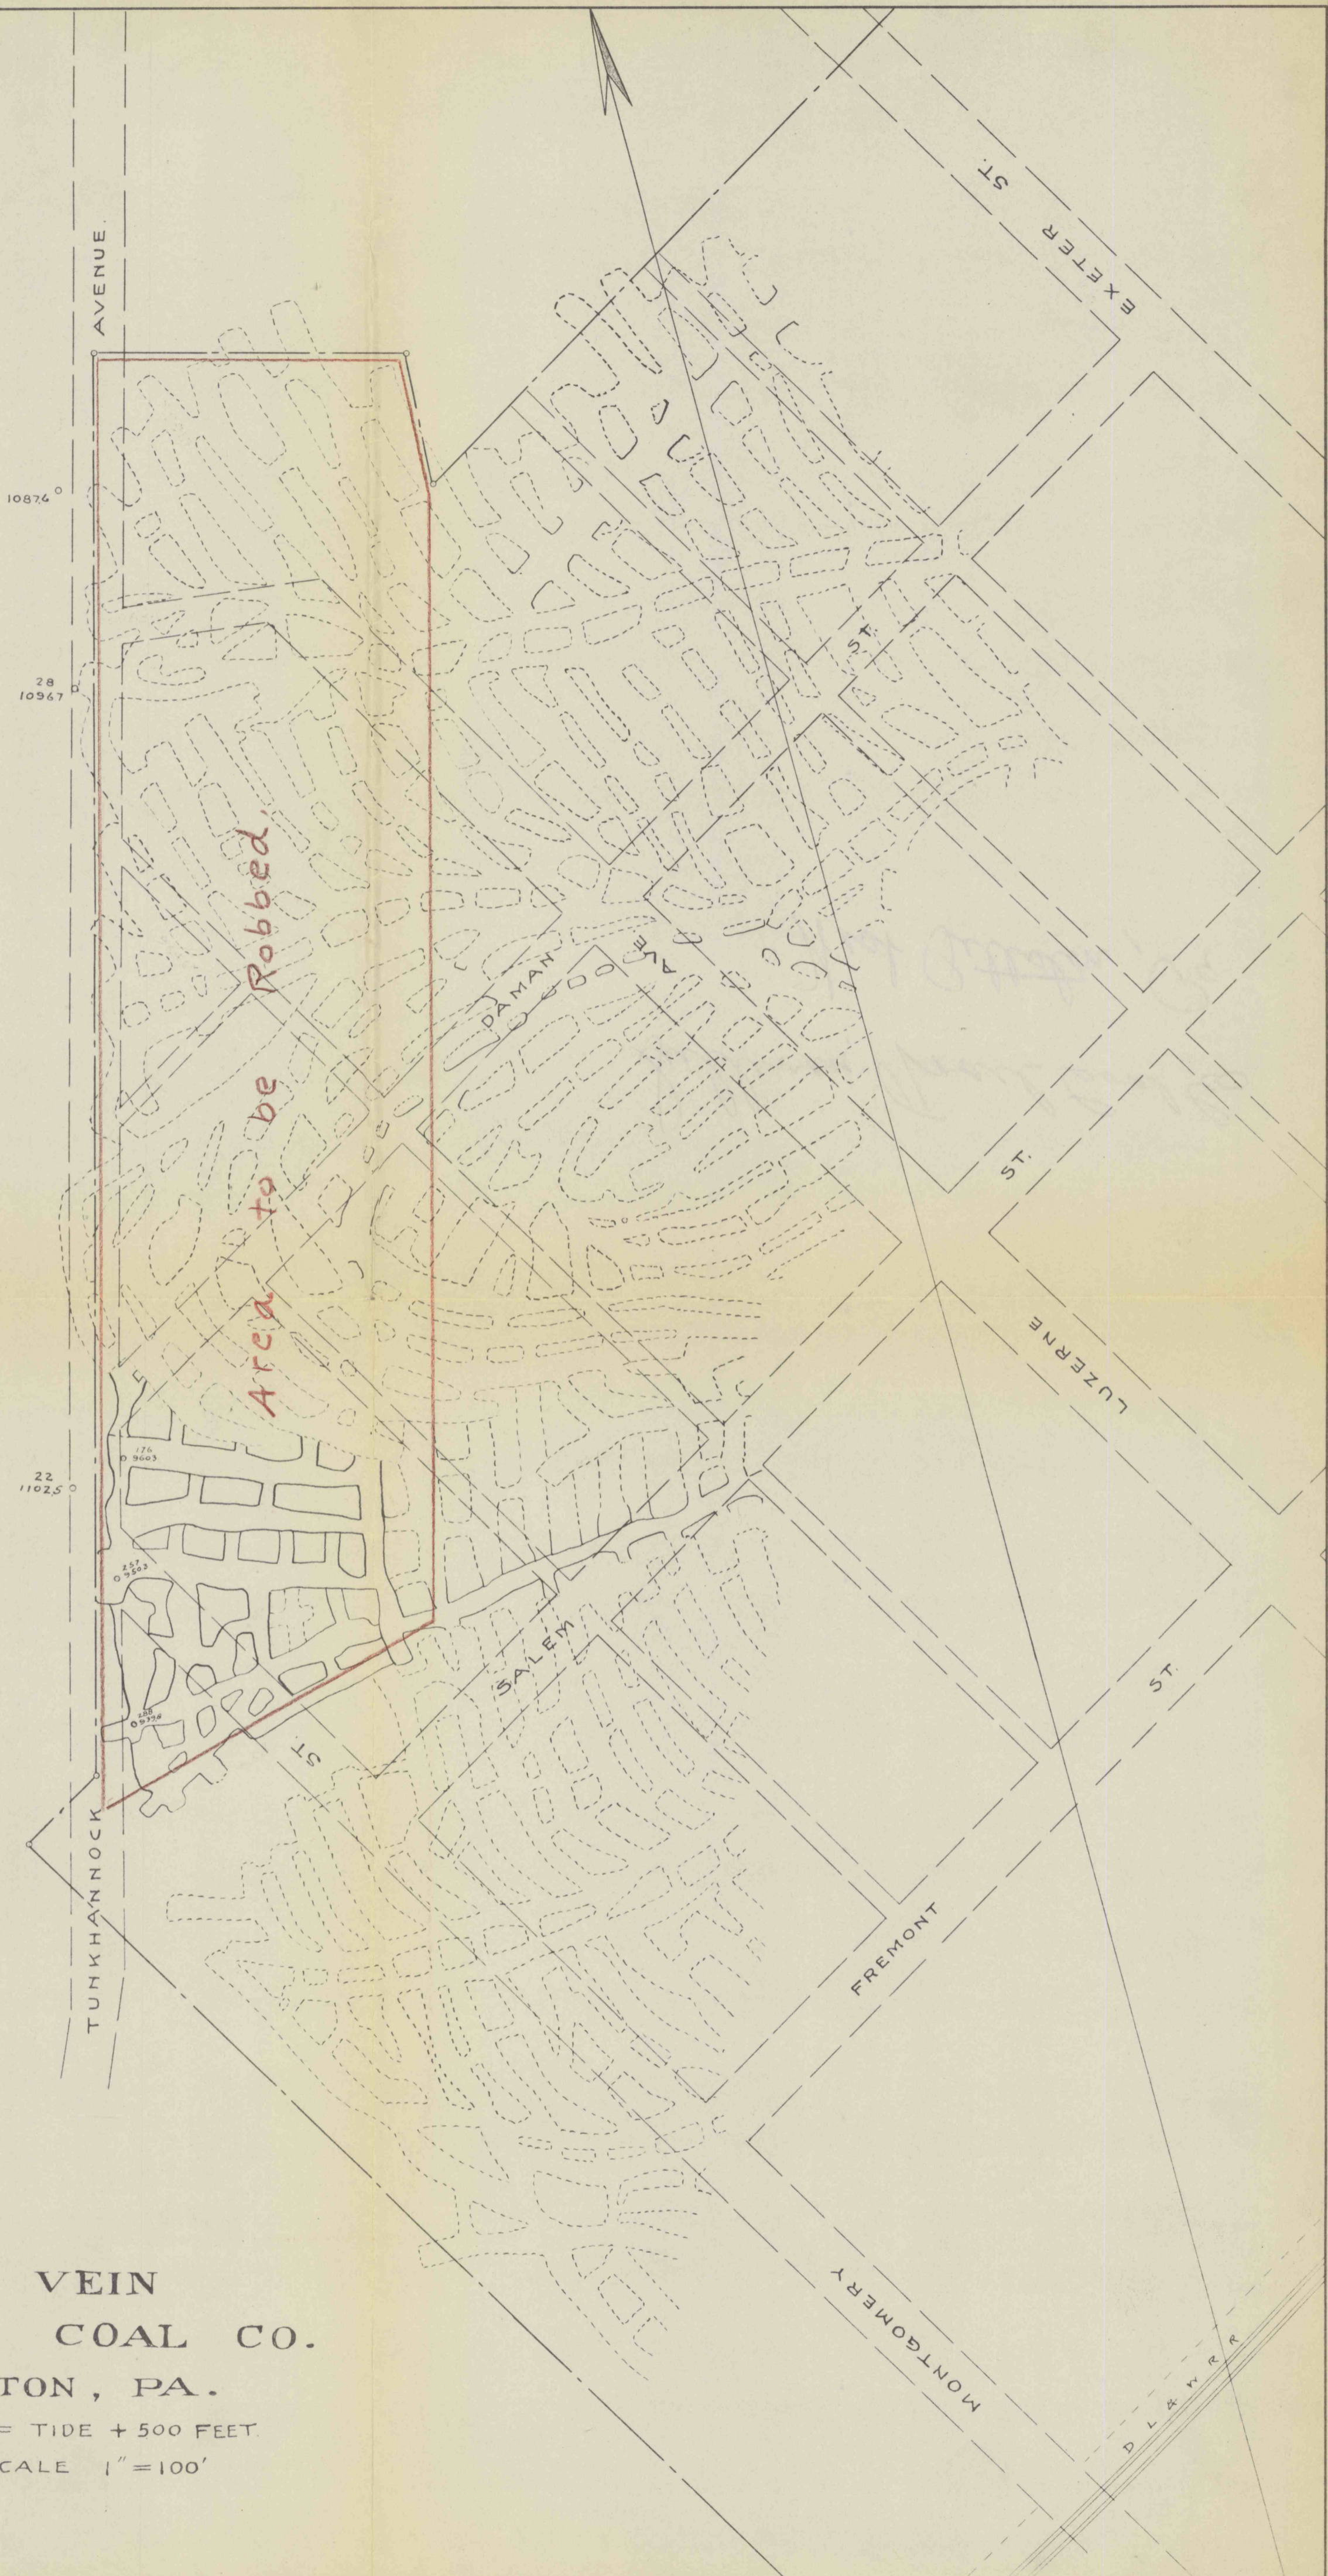

CHECKER VEIN
SULLIVAN TRAIL COAL CO.
WEST PITTSTON, PA.

ELEVATIONS = TIDE + 500 FEET.

SCALE 1" = 100'

Leon Whaites & Son,
Civil & Mining Engineers,
1638 Wyoming Ave., Scranton, Pa.
Jan. 10, 1938 *Leon Whaites*