


1st. Mining

10-1-1939 to 4-1-1940

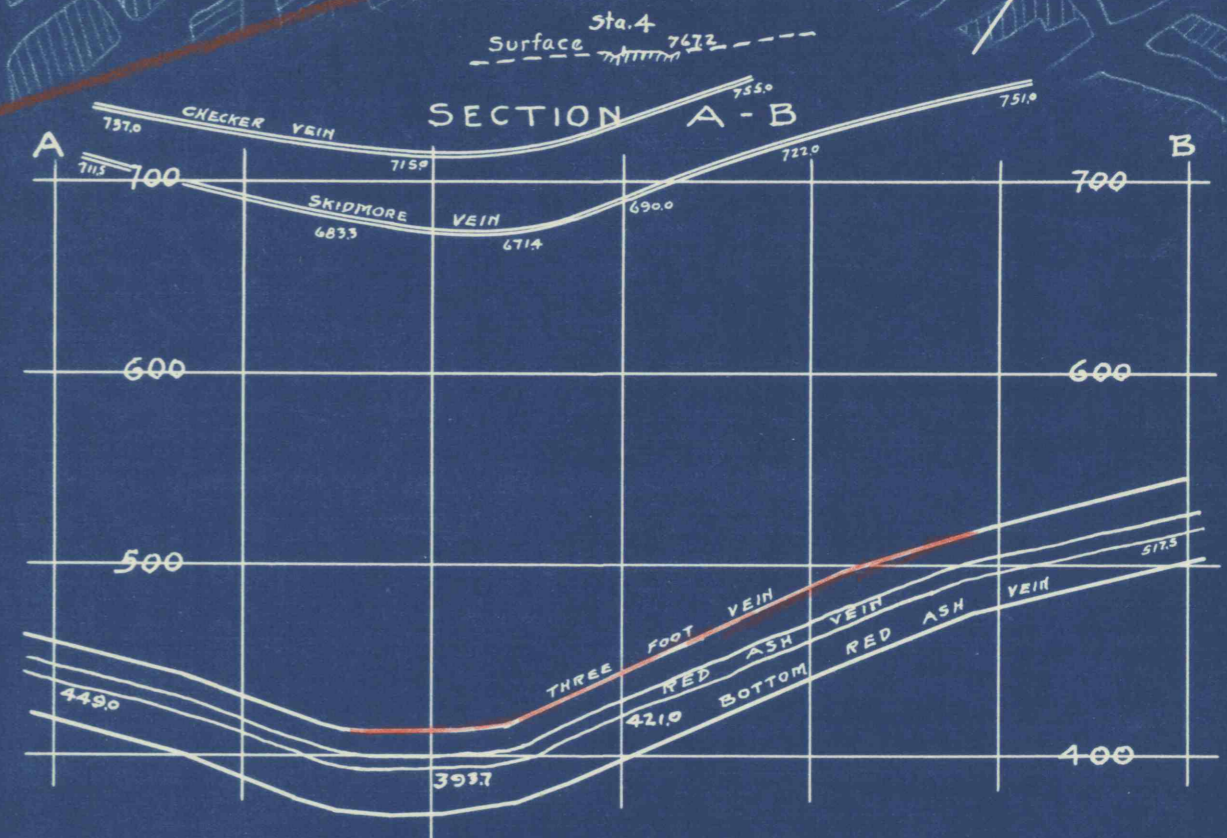

**THREE FOOT VEIN
MINERAL SPRING COAL CO.
PARSONS, PA.**

MAIN OFFICE - WEST PITTSBURGH, PA.

SCALE 1" = 100'

Mine Superintendent
Henry Vendre,
146 N. Main Street
Old Forge, Pa.

Leon White & Son,
Civil & Mining Engineers
1638 Wyoming Ave. Scranton, Pa.
Leon White