


SECTION AT STA. 63

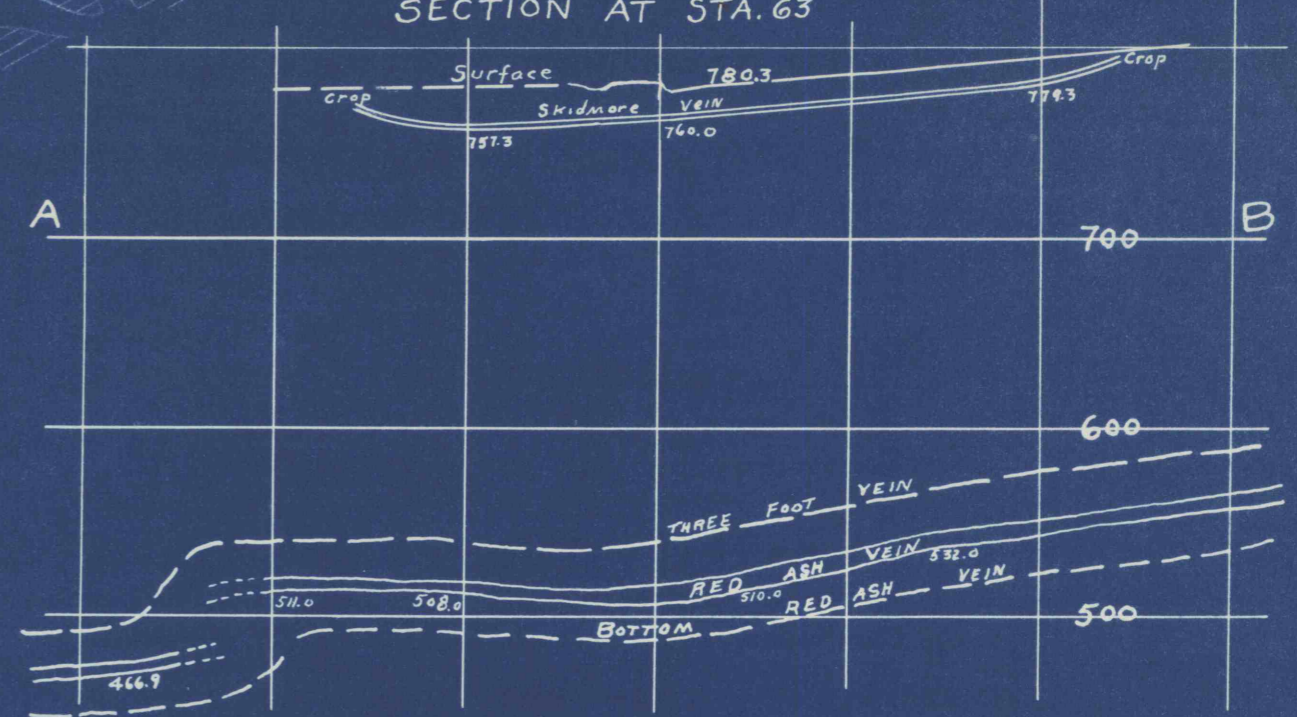

BOTTOM RED ASH VEIN
MINERAL SPRING COAL CO.
PARSONS, PA.

MAIN OFFICE - WEST PITTSBURGH, PA.

SCALE 1" = 100'

Mine Superintendent
 Henry Vendre,
 146 N. Main Street,
 Old Forge, Pa.

Leon White & Son,
 Civil & Mining Engineers
 1638 Wyoming Ave. Scranton, Pa.

Apr. 27, 1938 *Leon White*