


Columnar Stratigraphic Section at Bore Hole #3221 at Station 76+40

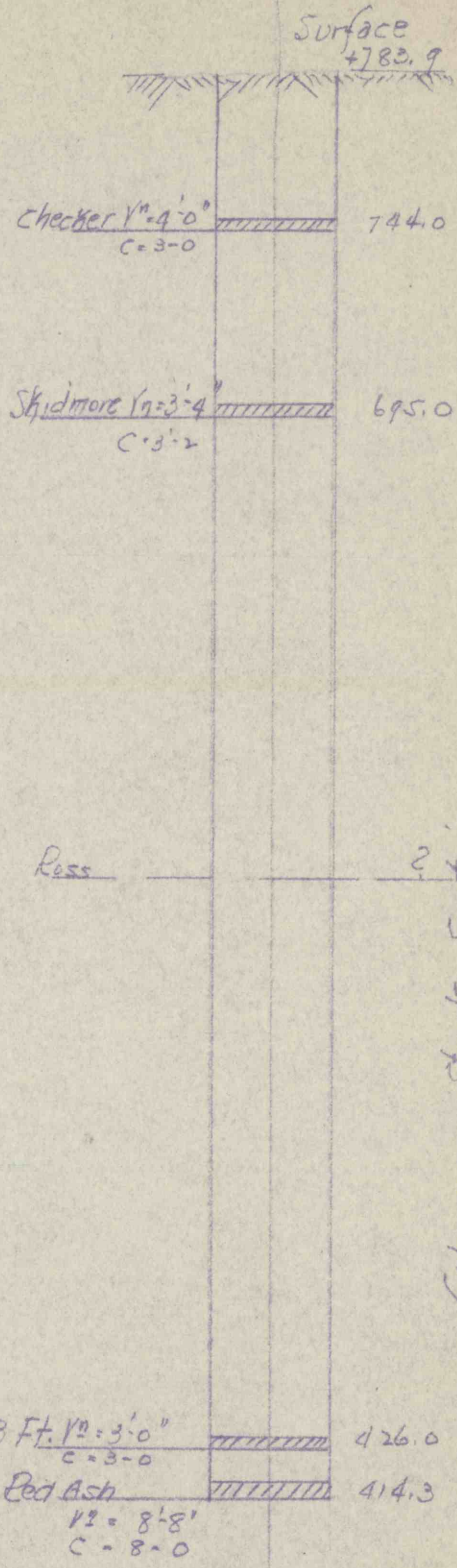

Columnar Stratigraphic Section at Station 112+27

Proposed Relocation Rt 169  
Frank B. Davenport  
Mining Engineer  
4-10-90