



Columnar Stratigraphic Section at Bore Hole #3221
at Station 76+40

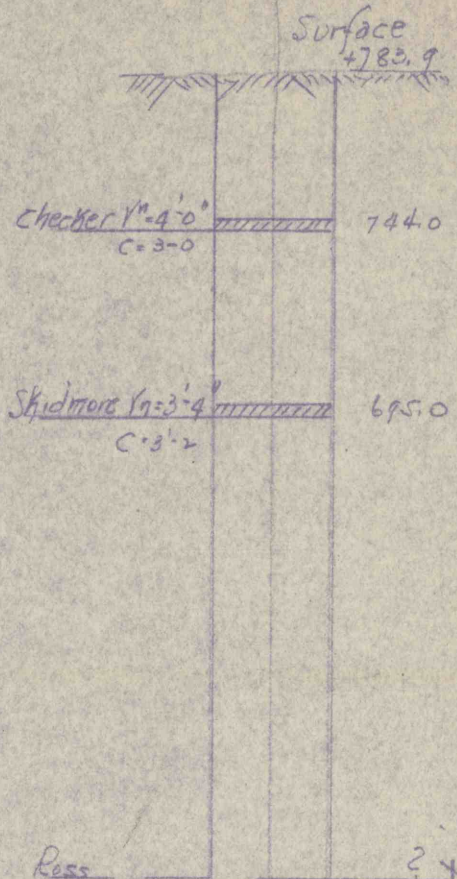

Columnar Stratigraphic Section
at Station 112+27

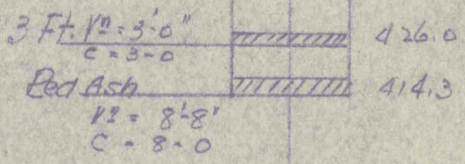

Proposed Relocation Et 169
Frank B. Davenport
Mining Engineer
4-10-90