


Dec 31 - 400

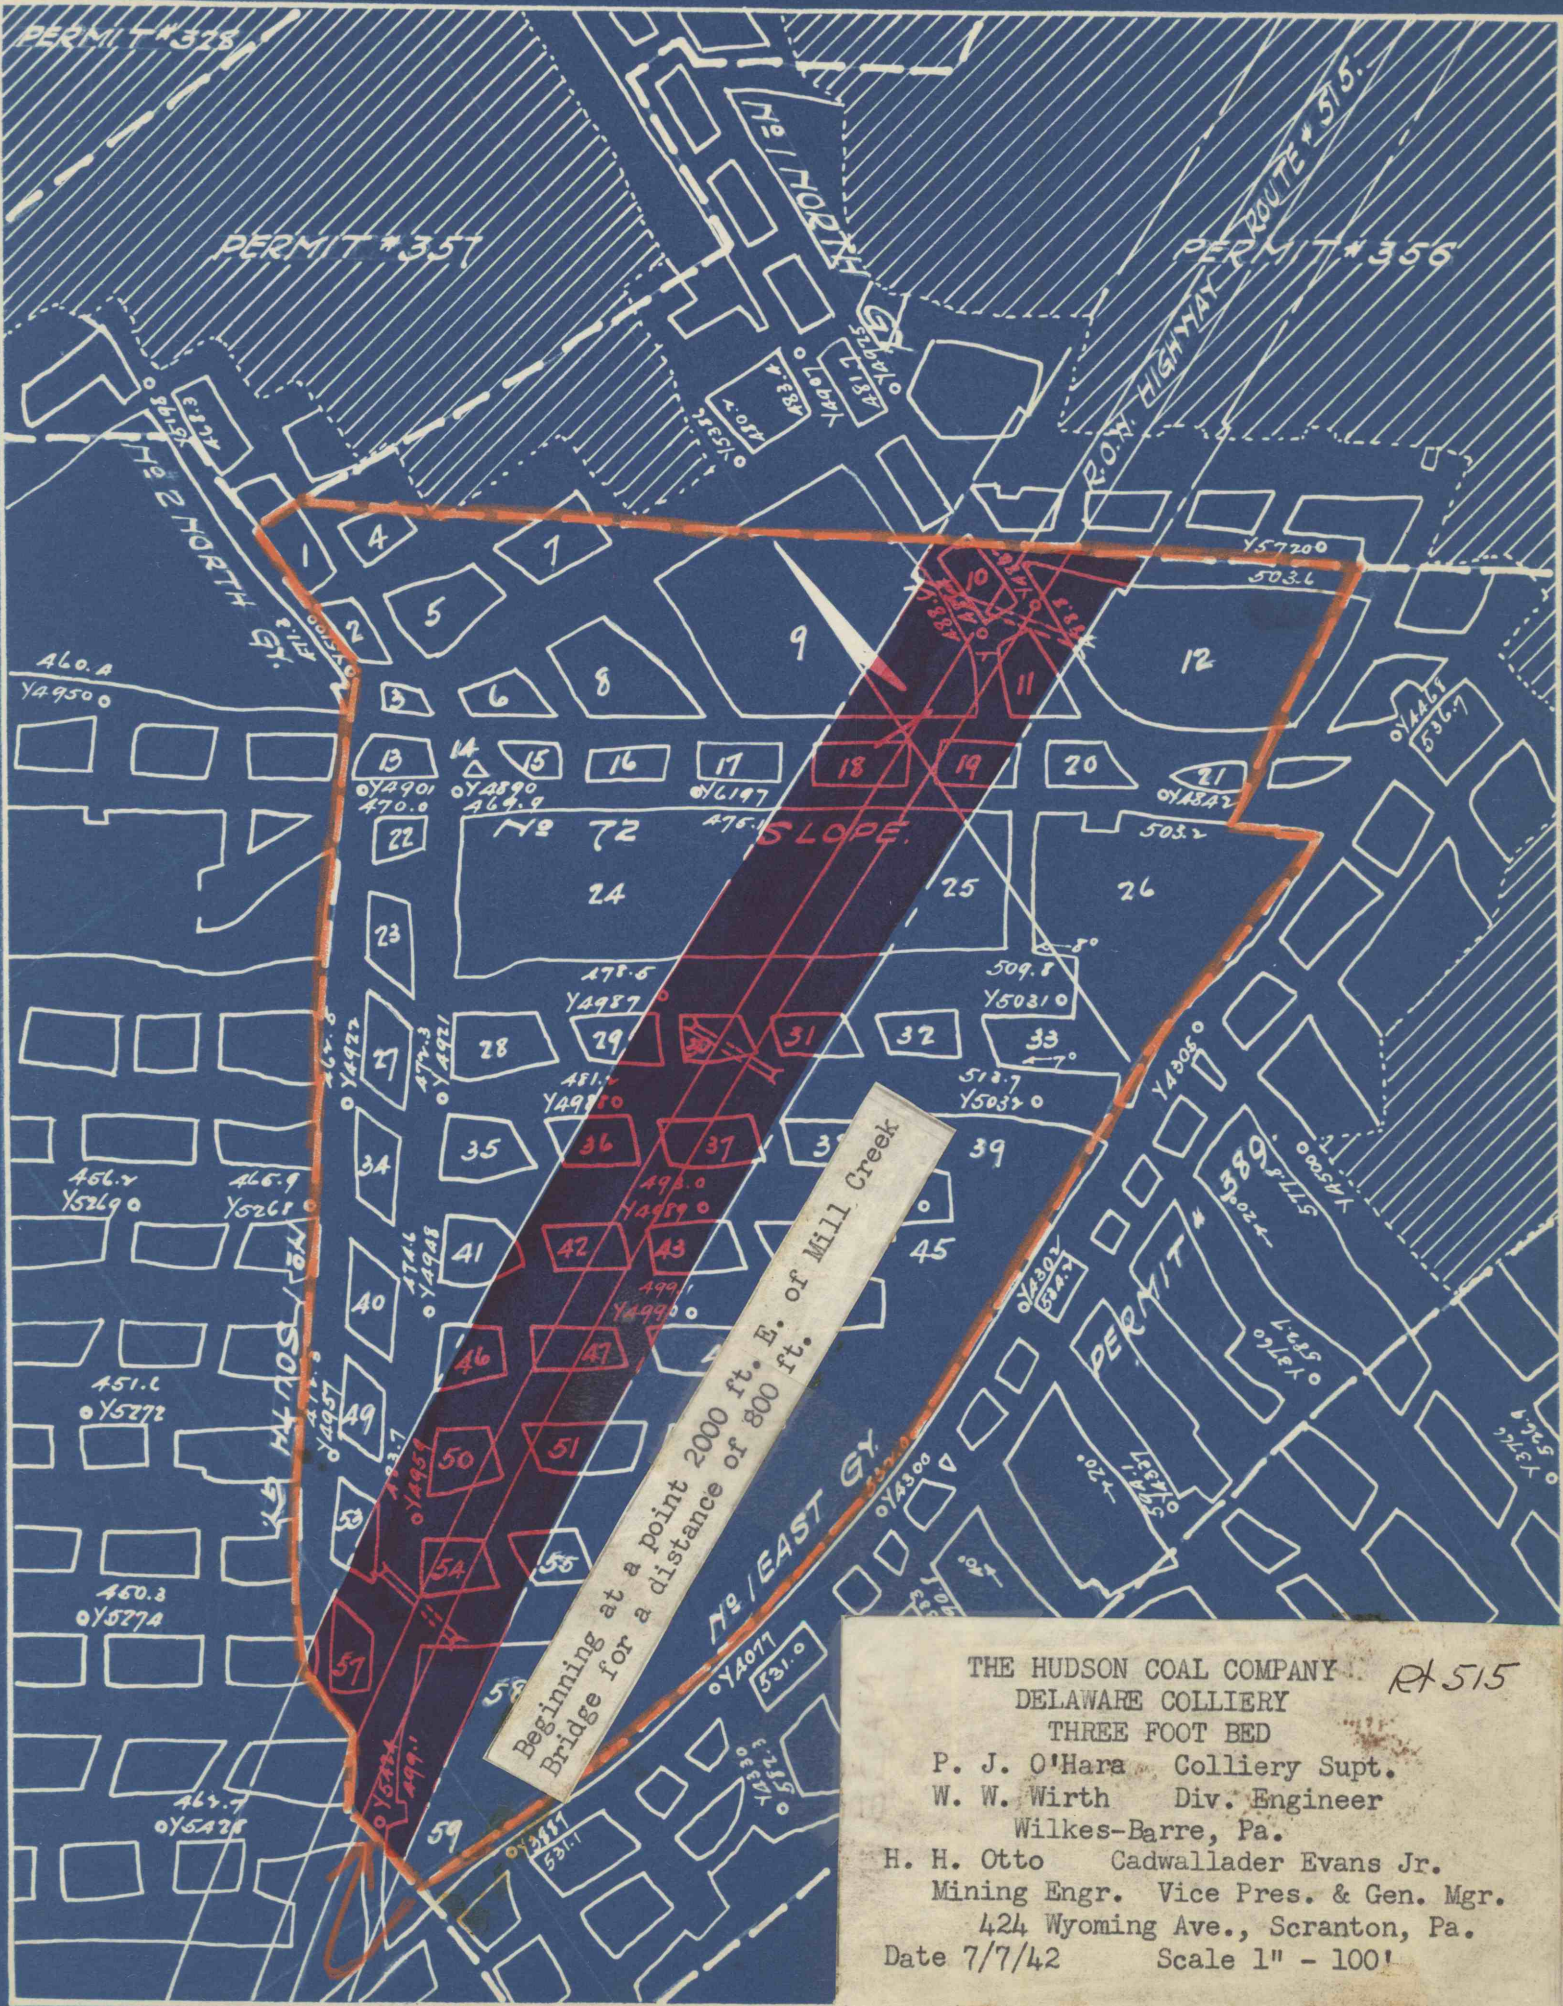

Beginning at a point 2000 ft. E. of Mill Creek
 Bridge for a distance of 800 ft.

THE HUDSON COAL COMPANY RT 515
 DELAWARE COLLIERY
 THREE FOOT BED
 P. J. O'Hara Colliery Supt.
 W. W. Wirth Div. Engineer
 Wilkes-Barre, Pa.
 H. H. Otto Cadwallader Evans Jr.
 Mining Engr. Vice Pres. & Gen. Mgr.
 424 Wyoming Ave., Scranton, Pa.
 Date 7/7/42 Scale 1" - 100'